
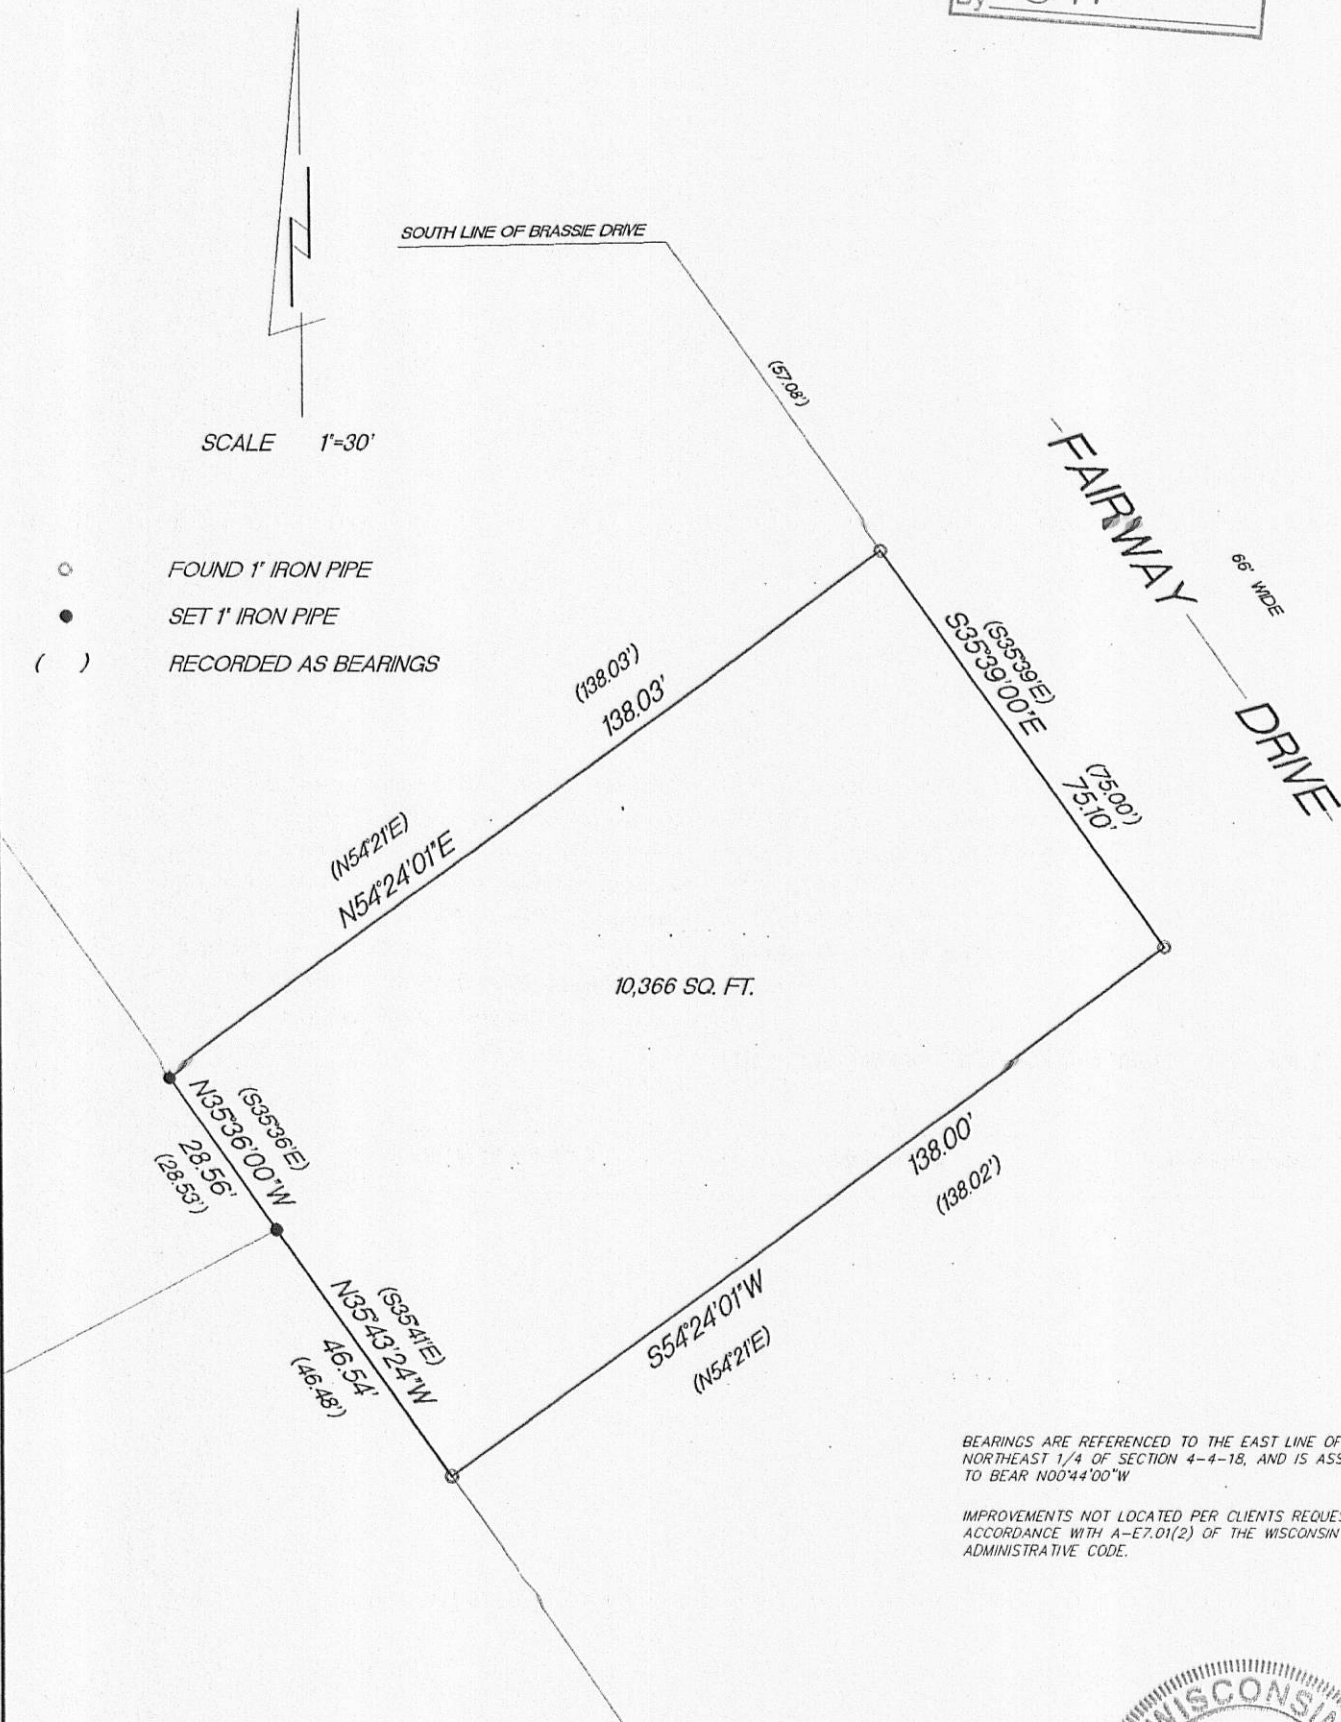


PLAT OF SURVEY

LOT 41, FAIRWAY SUBDIVISION, being a redivision of part of Williams Park Subdivision, located in the Southwest ¼, Northeast ¼ and Southeast ¼ of the Northwest ¼ of Section 4, Town 4 North, range 18 East, Town of East Troy, Walworth County, Wisconsin.

Surveyed for: Chris Breidenbach

Survey address: W1525 Fairway Drive

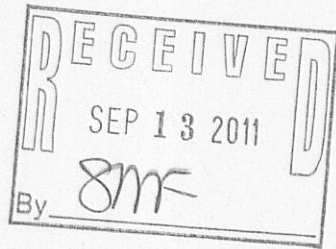

BEARINGS ARE REFERENCED TO THE EAST LINE OF THE NORTHEAST 1/4 OF SECTION 4-4-18, AND IS ASSUMED TO BEAR N00°44'00"W

IMPROVEMENTS NOT LOCATED PER CLIENTS REQUEST IN ACCORDANCE WITH A-E7.01(2) OF THE WISCONSIN ADMINISTRATIVE CODE.

"I hereby certify that I have surveyed the above described property and that the above map is a true representation thereof and shows the size and location of the property, its exterior boundaries, the location of all visible structures and dimension of all principal buildings thereon, boundary fences, apparent easements, roadways and encroachments if any."

"This survey is made for the use of the present owners of the property, and also those who purchase, mortgage or guarantee the title thereto within one year from date hereof."

KETTLE MORaine SURVEYING INC.
S75 W36245 Wilton Road
Eagle Wisconsin 53119
P.O. Box 357
(262) 594-3484
Terrance E. Pisarek R.L.S.



THIS IS NOT AN ORIGINAL SURVEY UNLESS THE SEAL IS RED.

7/21/11	TEP	TEP	11026
DATE	FIELD WORK BY	DRAWN BY	JOB NUMBER

PF-41 418-2225