

LEGAL DESCRIPTION:



LOT 13, BLOCK 19 OF "MIRAMAR ADDITION NO. 1" ACCORDING TO THE RECORDED PLAT THEREOF, BEING A SUBDIVISION OF A PART OF THE NORTHWEST  $\frac{1}{4}$  AND THE SOUTHWEST  $\frac{1}{4}$  OF THE NORTHEAST  $\frac{1}{4}$  OF SECTION 10, TOWN 4 NORTH, RANGE 18 EAST, IN THE TOWN OF EAST TROY, COUNTY OF WALWORTH, STATE OF WISCONSIN.

STATE OF WISCONSIN  
COUNTY OF RACINE

The above-described property has been surveyed under my direction and the above map is a correct representation thereof.

DATED AT: NORTH CAPE, THIS 24TH DAY OF AUGUST, 2011.

*Pete L. Bailey*  
AMERICAN SURVEYING COMPANY, INC.  
PETE L. BAILEY, RLS NO. 1398  
RECERTIFIED this \_\_\_\_\_ day of \_\_\_\_\_, 2011.

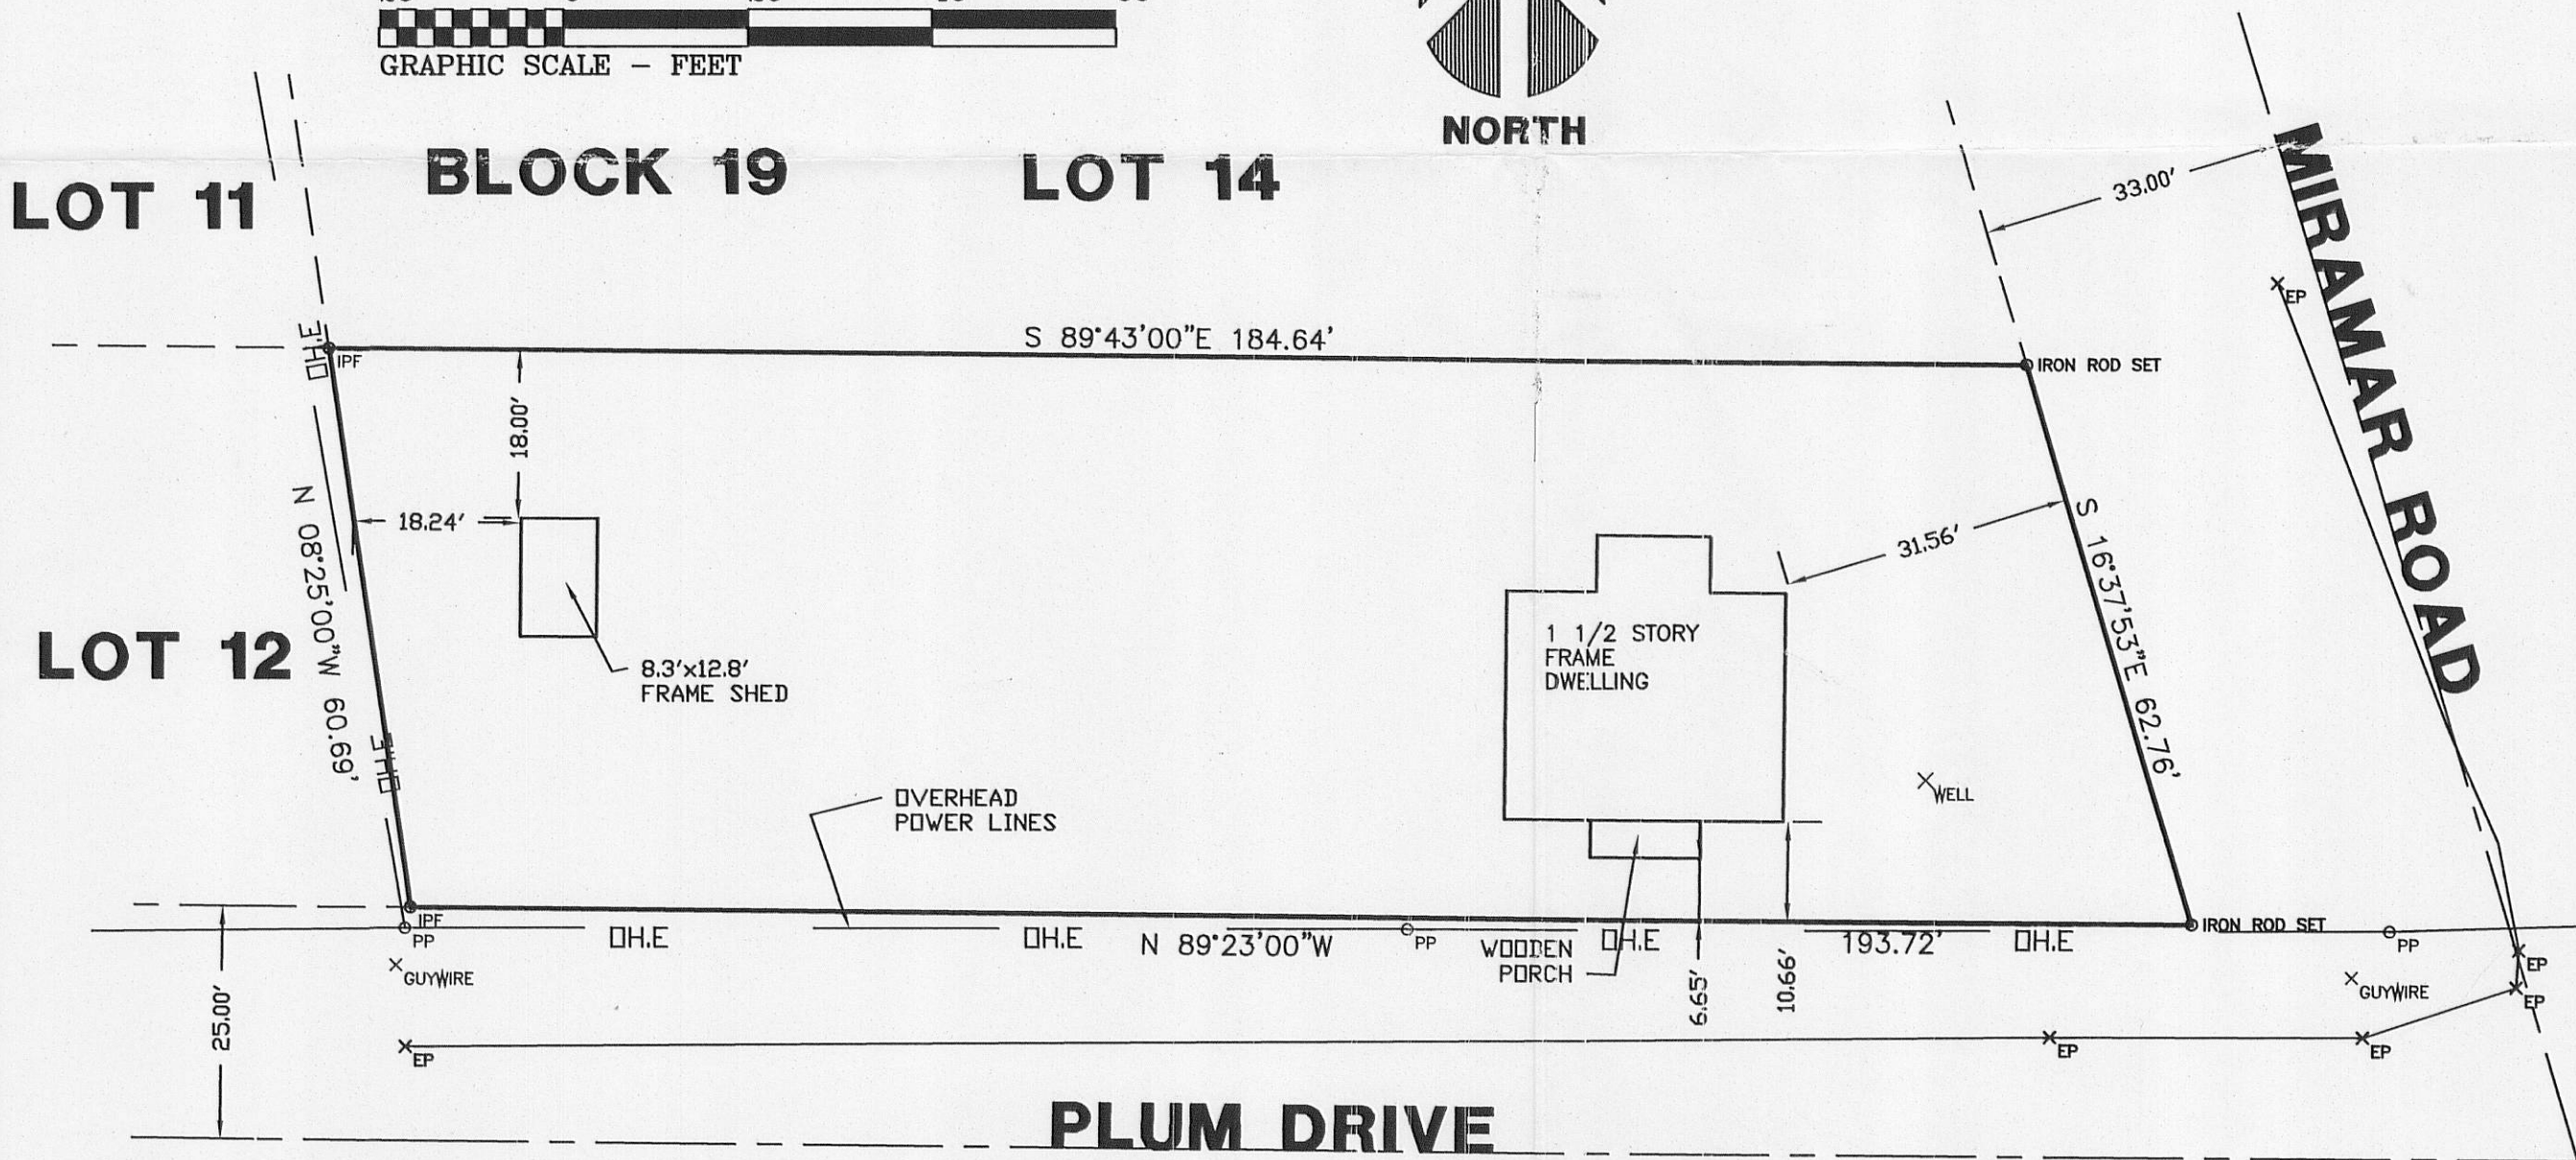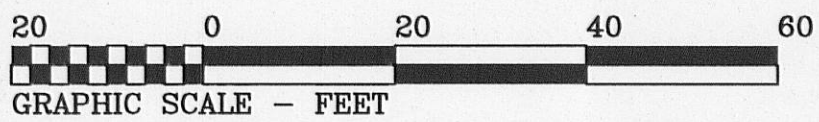

AMERICAN  
SURVEYING  
COMPANY, INC.

12207 C.T.H. "K" FRANKSVILLE, WISCONSIN 53126  
TEL. (262) 835-4774 FAX: (262) 835-2379  
beaufordbailey@hotmail.com


| DRAWN BY:   | PLB        | REVISIONS: | DATE  |
|-------------|------------|------------|-------|
| CHECKED BY: | PLB        |            |       |
| PLOT SCALE: | 1 = 20     |            |       |
| DATE:       | 08/24/2011 |            |       |
| JOB NO.:    | 2011073    |            |       |
| DWG. FILE:  | JN2011140  | CLIENT NO. | 04253 |

TOWN OF EAST TROY

PROJECT:  
**PLAT OF SURVEY/BOUNDARY SURVEY**  
PREPARED FOR, LOVELL V. WAMBOLD TRUST

Sheet  
**1**  
of  
**1**

RECEIVED  
OCT - 3 2011  
By *Sm*

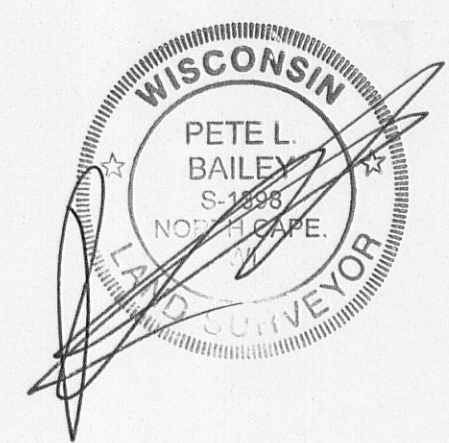

PMR1-19

418 - 2230