

W 238 S 3712 BIG BEND ROAD
WAUKESHA, WIS 53186


TELEPHONE
542-5616

RONALD H. ZIMMERMAN
REGISTERED LAND SURVEYOR

PLAT OF SURVEY

FOR

WAUKESHA SAVINGS & LOAN

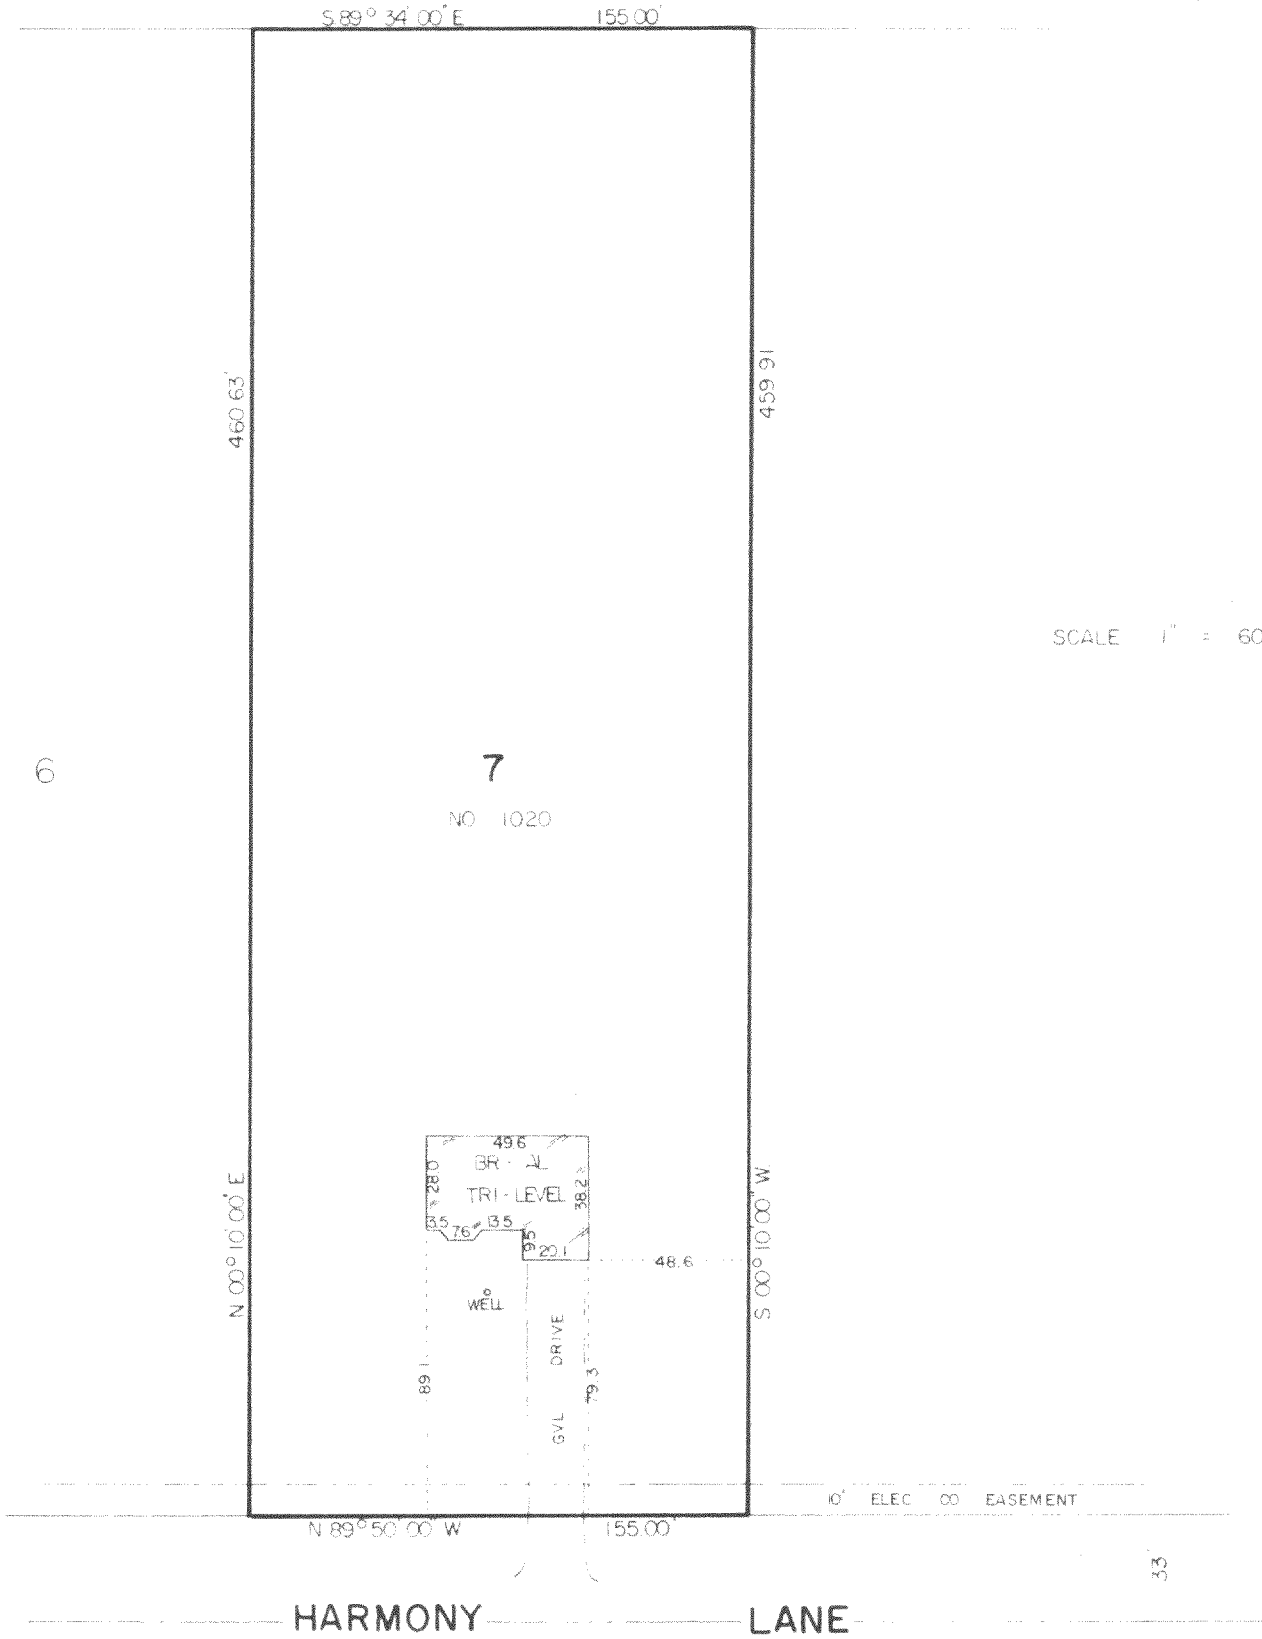

STATE OF WISCONSIN)
COUNTY OF WAUKESHA) SS


CERTIFICATION

I, RONALD H. ZIMMERMAN, REGISTERED LAND SURVEYOR, DO HEREBY CERTIFY THAT I HAVE MADE A SURVEY
OF LOT 7, MIRAMAR ADDITION NO. 2, TOWN OF EAST TROY,
AND THE EXISTING BUILDING AND IMPROVEMENTS LOCATED THEREON AND THAT THE PLAT HERWITH DRAWN
IS A CORRECT REPRESENTATION OF SAID SURVEY.

DATE APRIL 5, 19 74

RONALD H. ZIMMERMAN

S 868

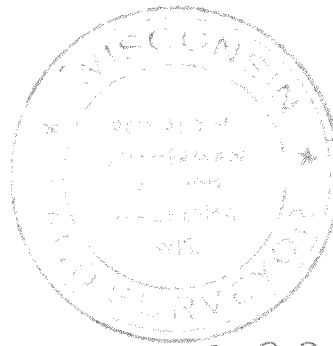

418-224