



ROAD
TOWNLINE

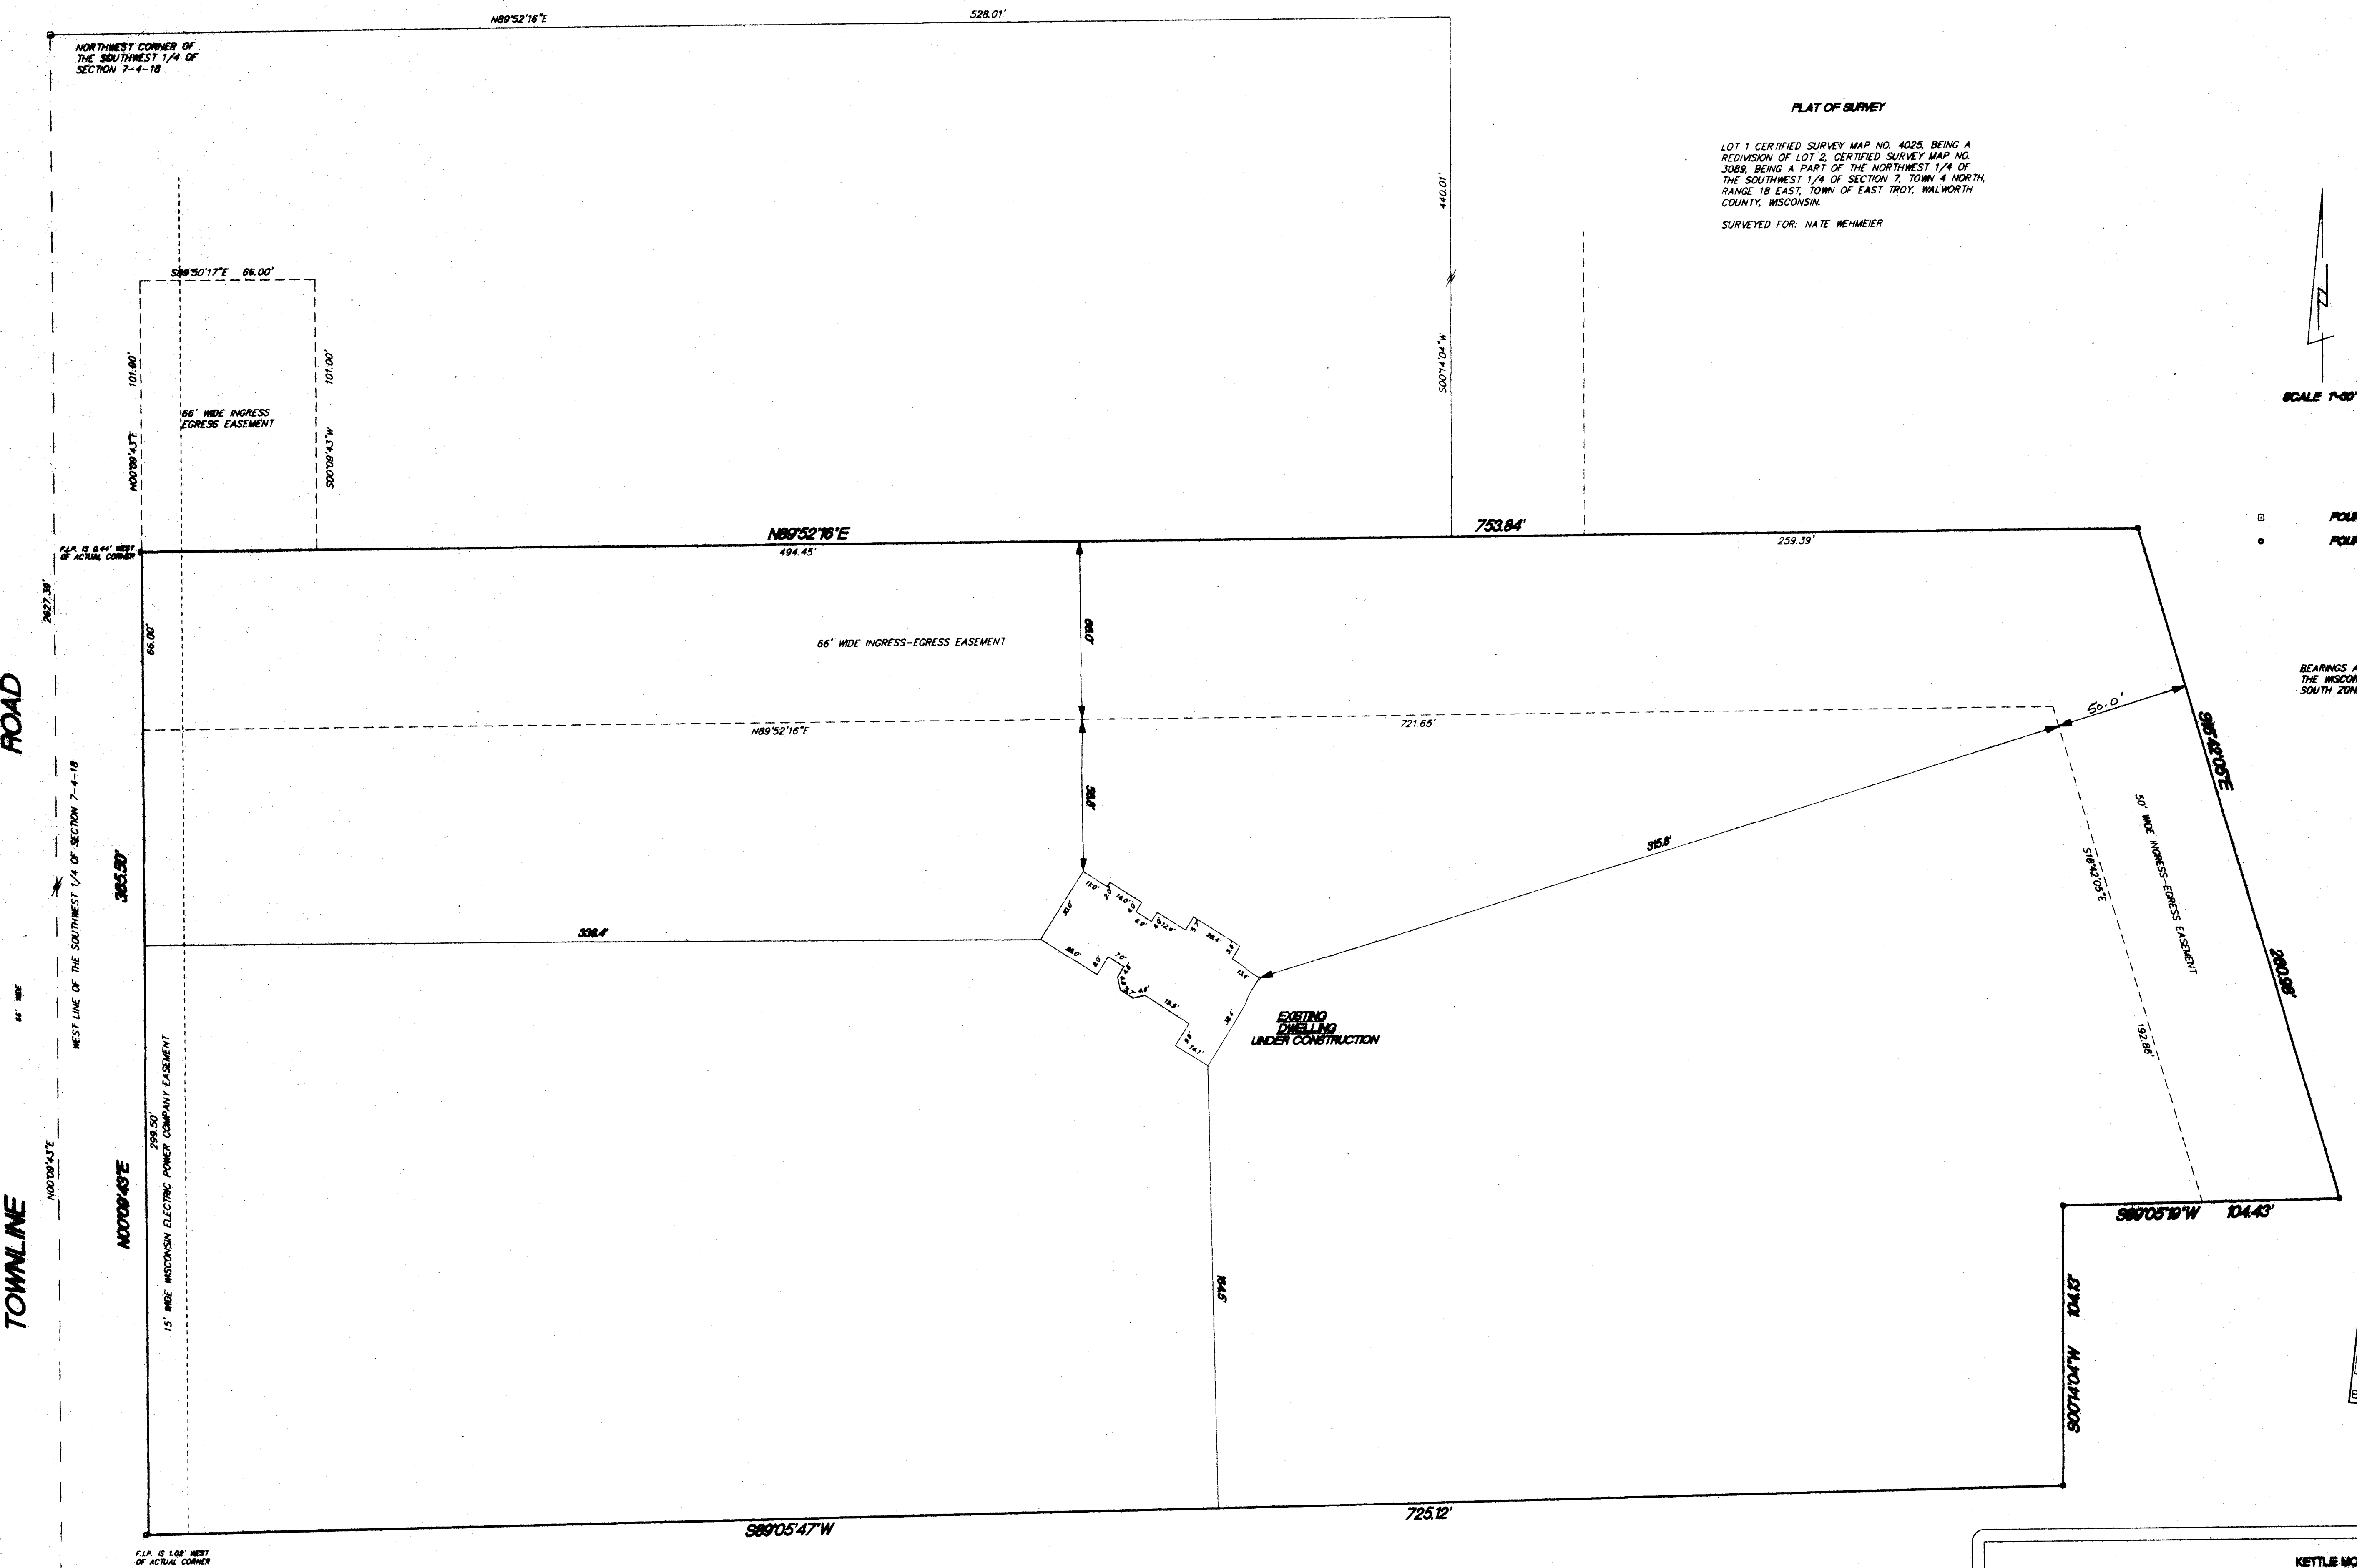

PLAT OF SURVEY


LOT 1 CERTIFIED SURVEY MAP NO. 4025, BEING A
REDIVISION OF LOT 2, CERTIFIED SURVEY MAP NO.
3089, BEING A PART OF THE NORTHWEST 1/4 OF
THE SOUTHWEST 1/4 OF SECTION 7, TOWN 4 NORTH,
RANGE 18 EAST, TOWN OF EAST TROY, WALWORTH
COUNTY, WISCONSIN.
SURVEYED FOR: NATE MEHMEIER

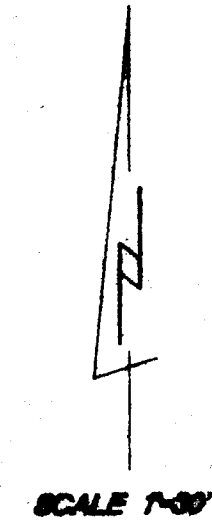

FOUND 6" CONC. MEN. REBAR CAP
FOUND 1" IRON PIPE

BEARINGS ARE REFERENCED TO GRID NORTH OF
THE WISCONSIN STATE PLANE COORDINATE SYSTEM
SOUTH ZONE. (NAD 1983)

RECEIVED
FEB 1 2012
By: [Signature]

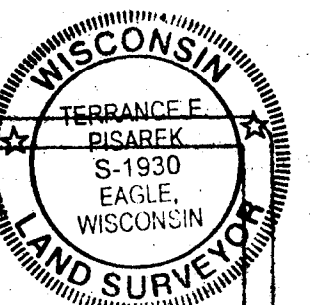

I hereby certify that I have surveyed the above property
and that the above map is a true representation thereof
and shows the size and location of the property
exterior boundaries, the location of all visible structures
and dimensions of all principal buildings thereon, boundary
lines, adjacent easements, roadways and encroachments if
any.
This survey is made for the use of the present owners of
the property, and who those who purchase, mortgage or
otherwise the title thereto shall use from date hereof.

KETTLE MORAINES SURVEYING INC.
P.O. BOX 867
Eagle, WI 53009
(262) 894-3404

THIS IS NOT AN ORIGINAL SURVEY UNLESS THE SEAL IS RED.

REV. 1/8/12
DATE 4/3/08
BY: [Signature]
FIELD WORK BY: [Signature]
DRAWN BY: [Signature]
JOB NUMBER 00017

PA4035-1

418-2766