


PREPARED FOR
VICTOR MADARICH

PLAT OF SURVEY

- OF -

LOT 1, BLOCK 1 SKONEY'S SUBDIVISION, LOCATED IN THE SE 1/4 OF THE SW 1/4, AND THE SW 1/4 OF THE SE 1/4 OF FRACTIONAL SECTION 10, TOWN 4 NORTH, RANGE 18 EAST, TOWN OF EAST TROY, WALWORTH COUNTY, WISCONSIN.

PATHFINDER SURVEYING INC.
(formerly)
J.K. SURVEYING INC.
P.O. BOX 322
LAKE GENEVA, WI. 53147
WWW.PATHFINDERSURVEYING.NET
262-248-8303

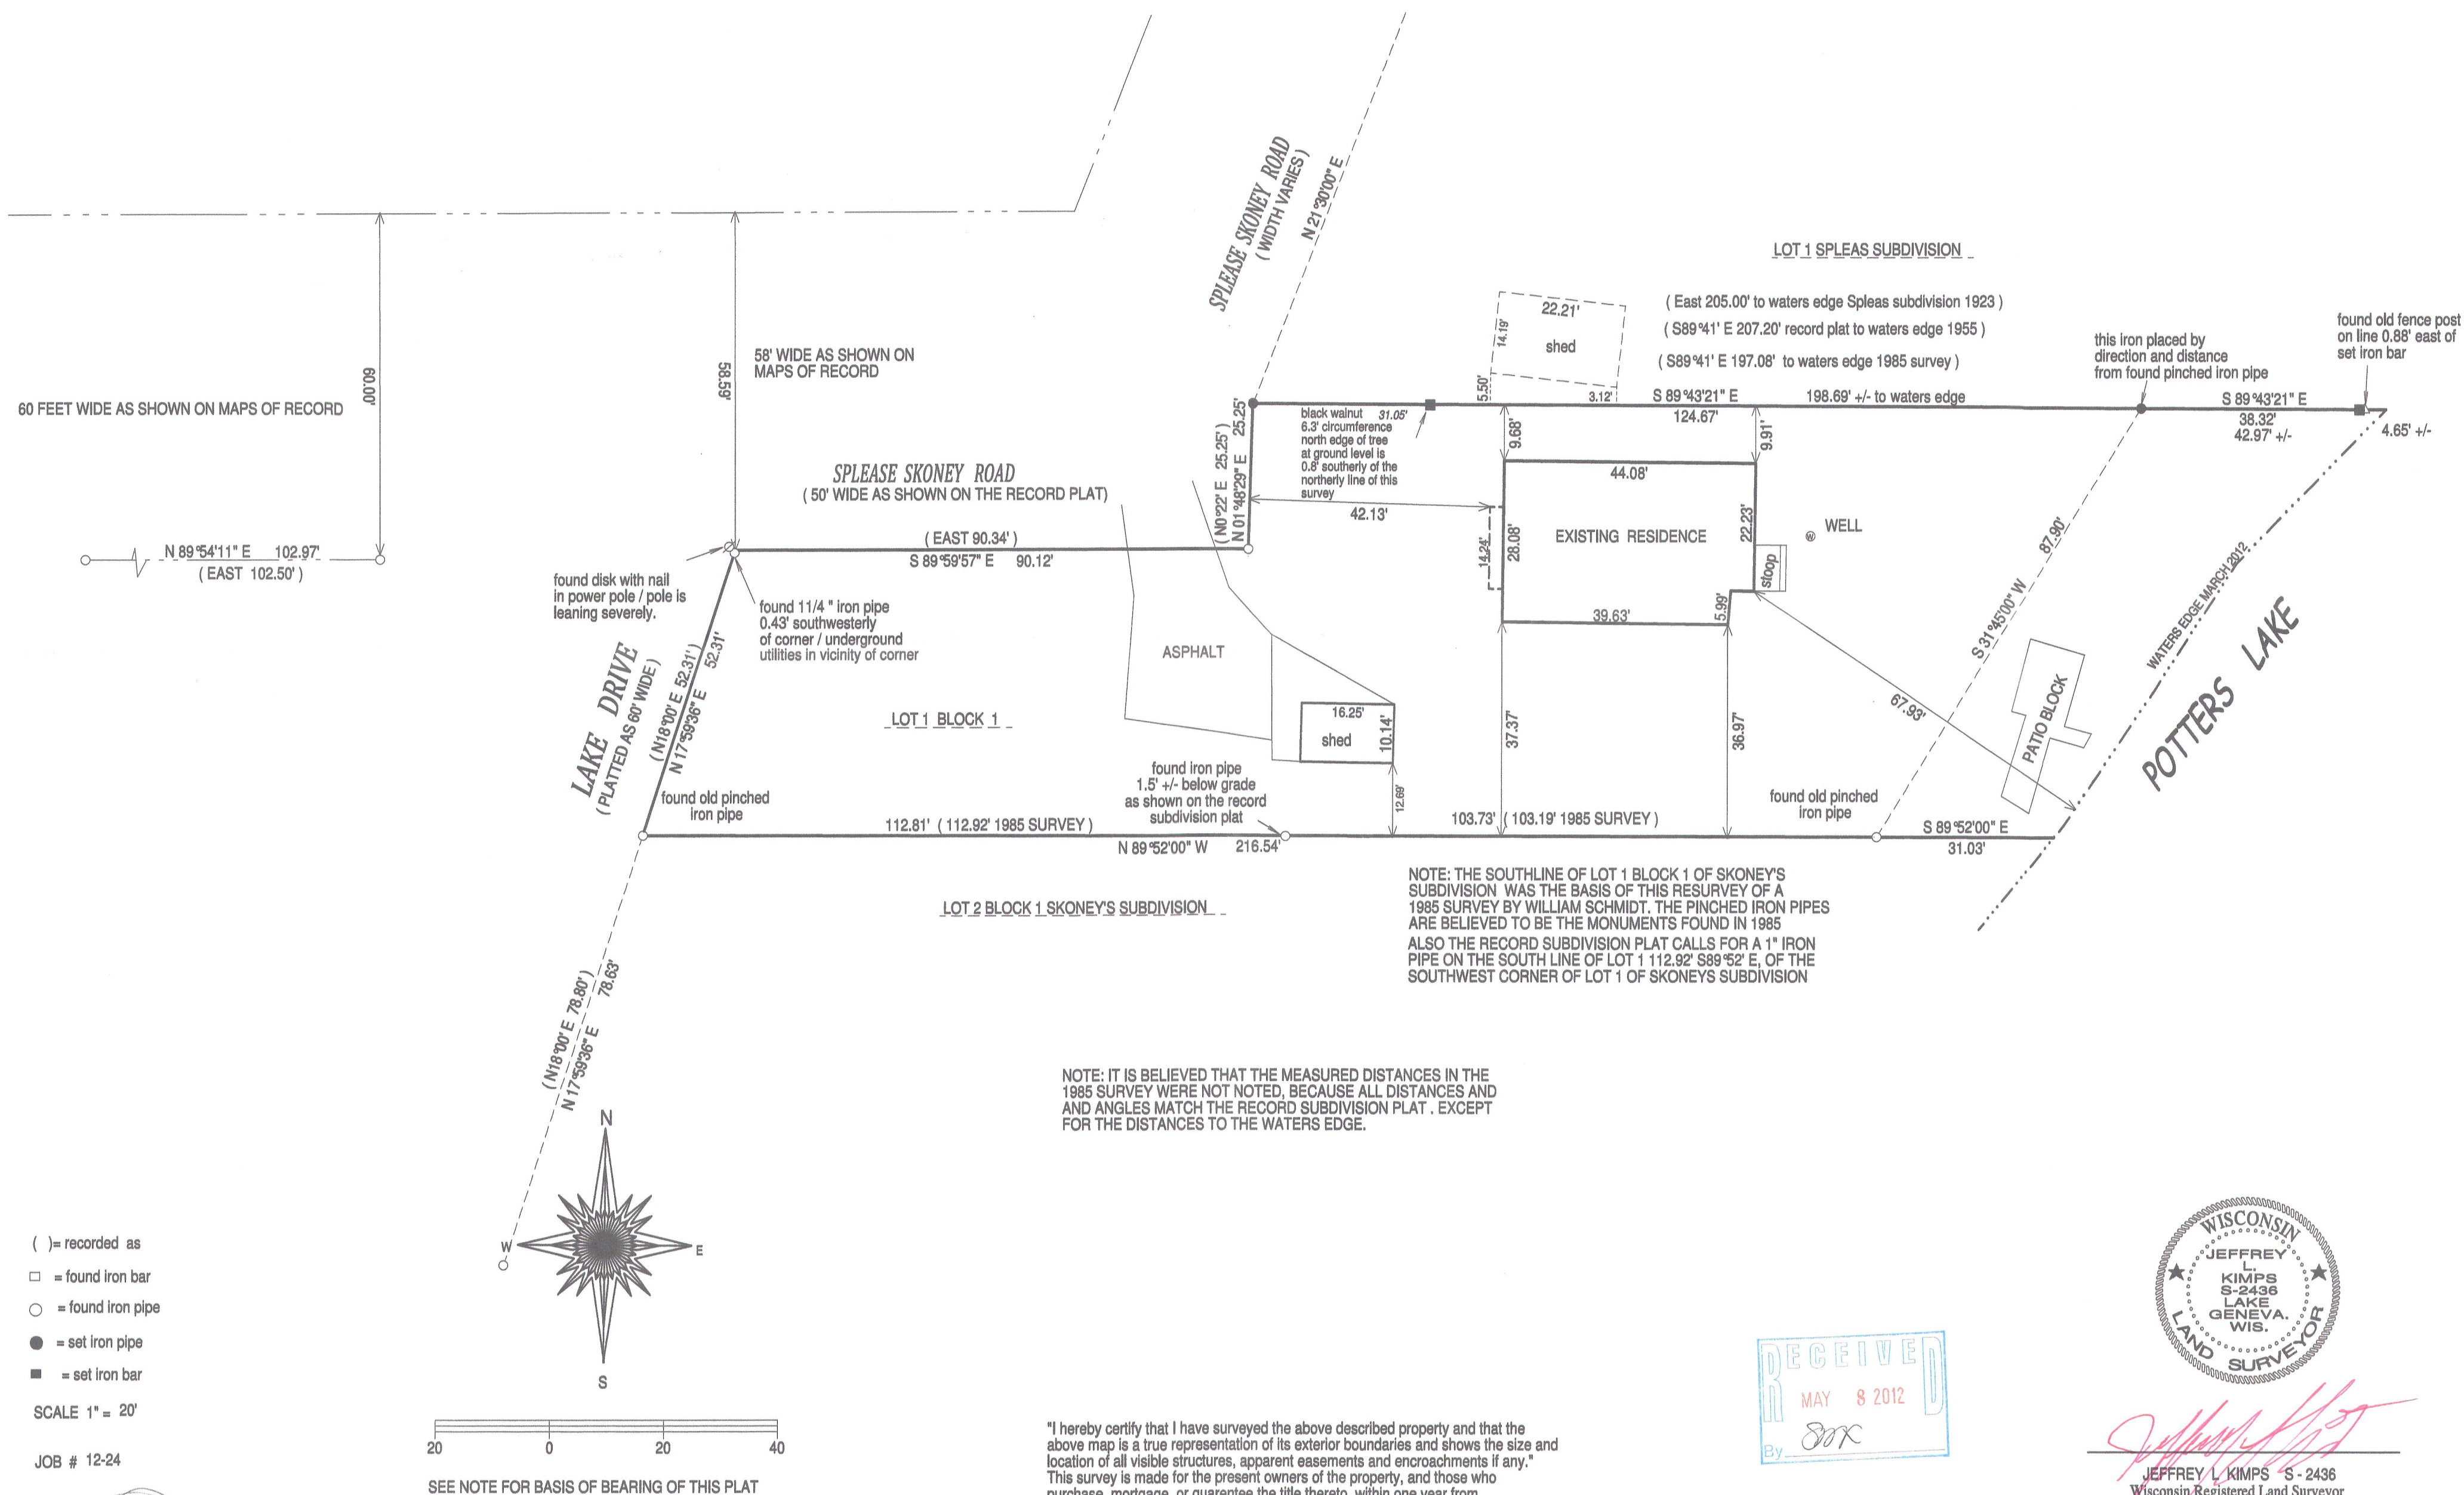

418-2275