

PLAT OF SURVEY
LOT 4 OF LAKE BEULAH ESTATES
TOWN OF EAST TROY, WALWORTH COUNTY, WISCONSIN


WORK ORDERED BY -
DALE DOBROTH
1360 MIDDLEFORK DRIVE
LAKE FOREST, IL 60045

FARRIS, HANSEN & ASSOCIATES, INC.
ENGINEERING - ARCHITECTURE - SURVEYING
7 RIDGWAY COURT P.O. BOX 437
ELKHORN, WISCONSIN 53121
OFFICE: (262) 723-2098 FAX: (262) 723-5886

REVISIONS

PROJECT NO.
3360.12
DATE
08/20/2012
SHEET NO.
1 OF 1

PLAT OF SURVEY
LOT 4 OF LAKE BEULAH ESTATES
LOCATED IN PART OF THE NW 1/4 OF THE NE 1/4 OF
SECTION 8, TOWN 4 NORTH, RANGE 18 EAST,
WALWORTH COUNTY, WISCONSIN

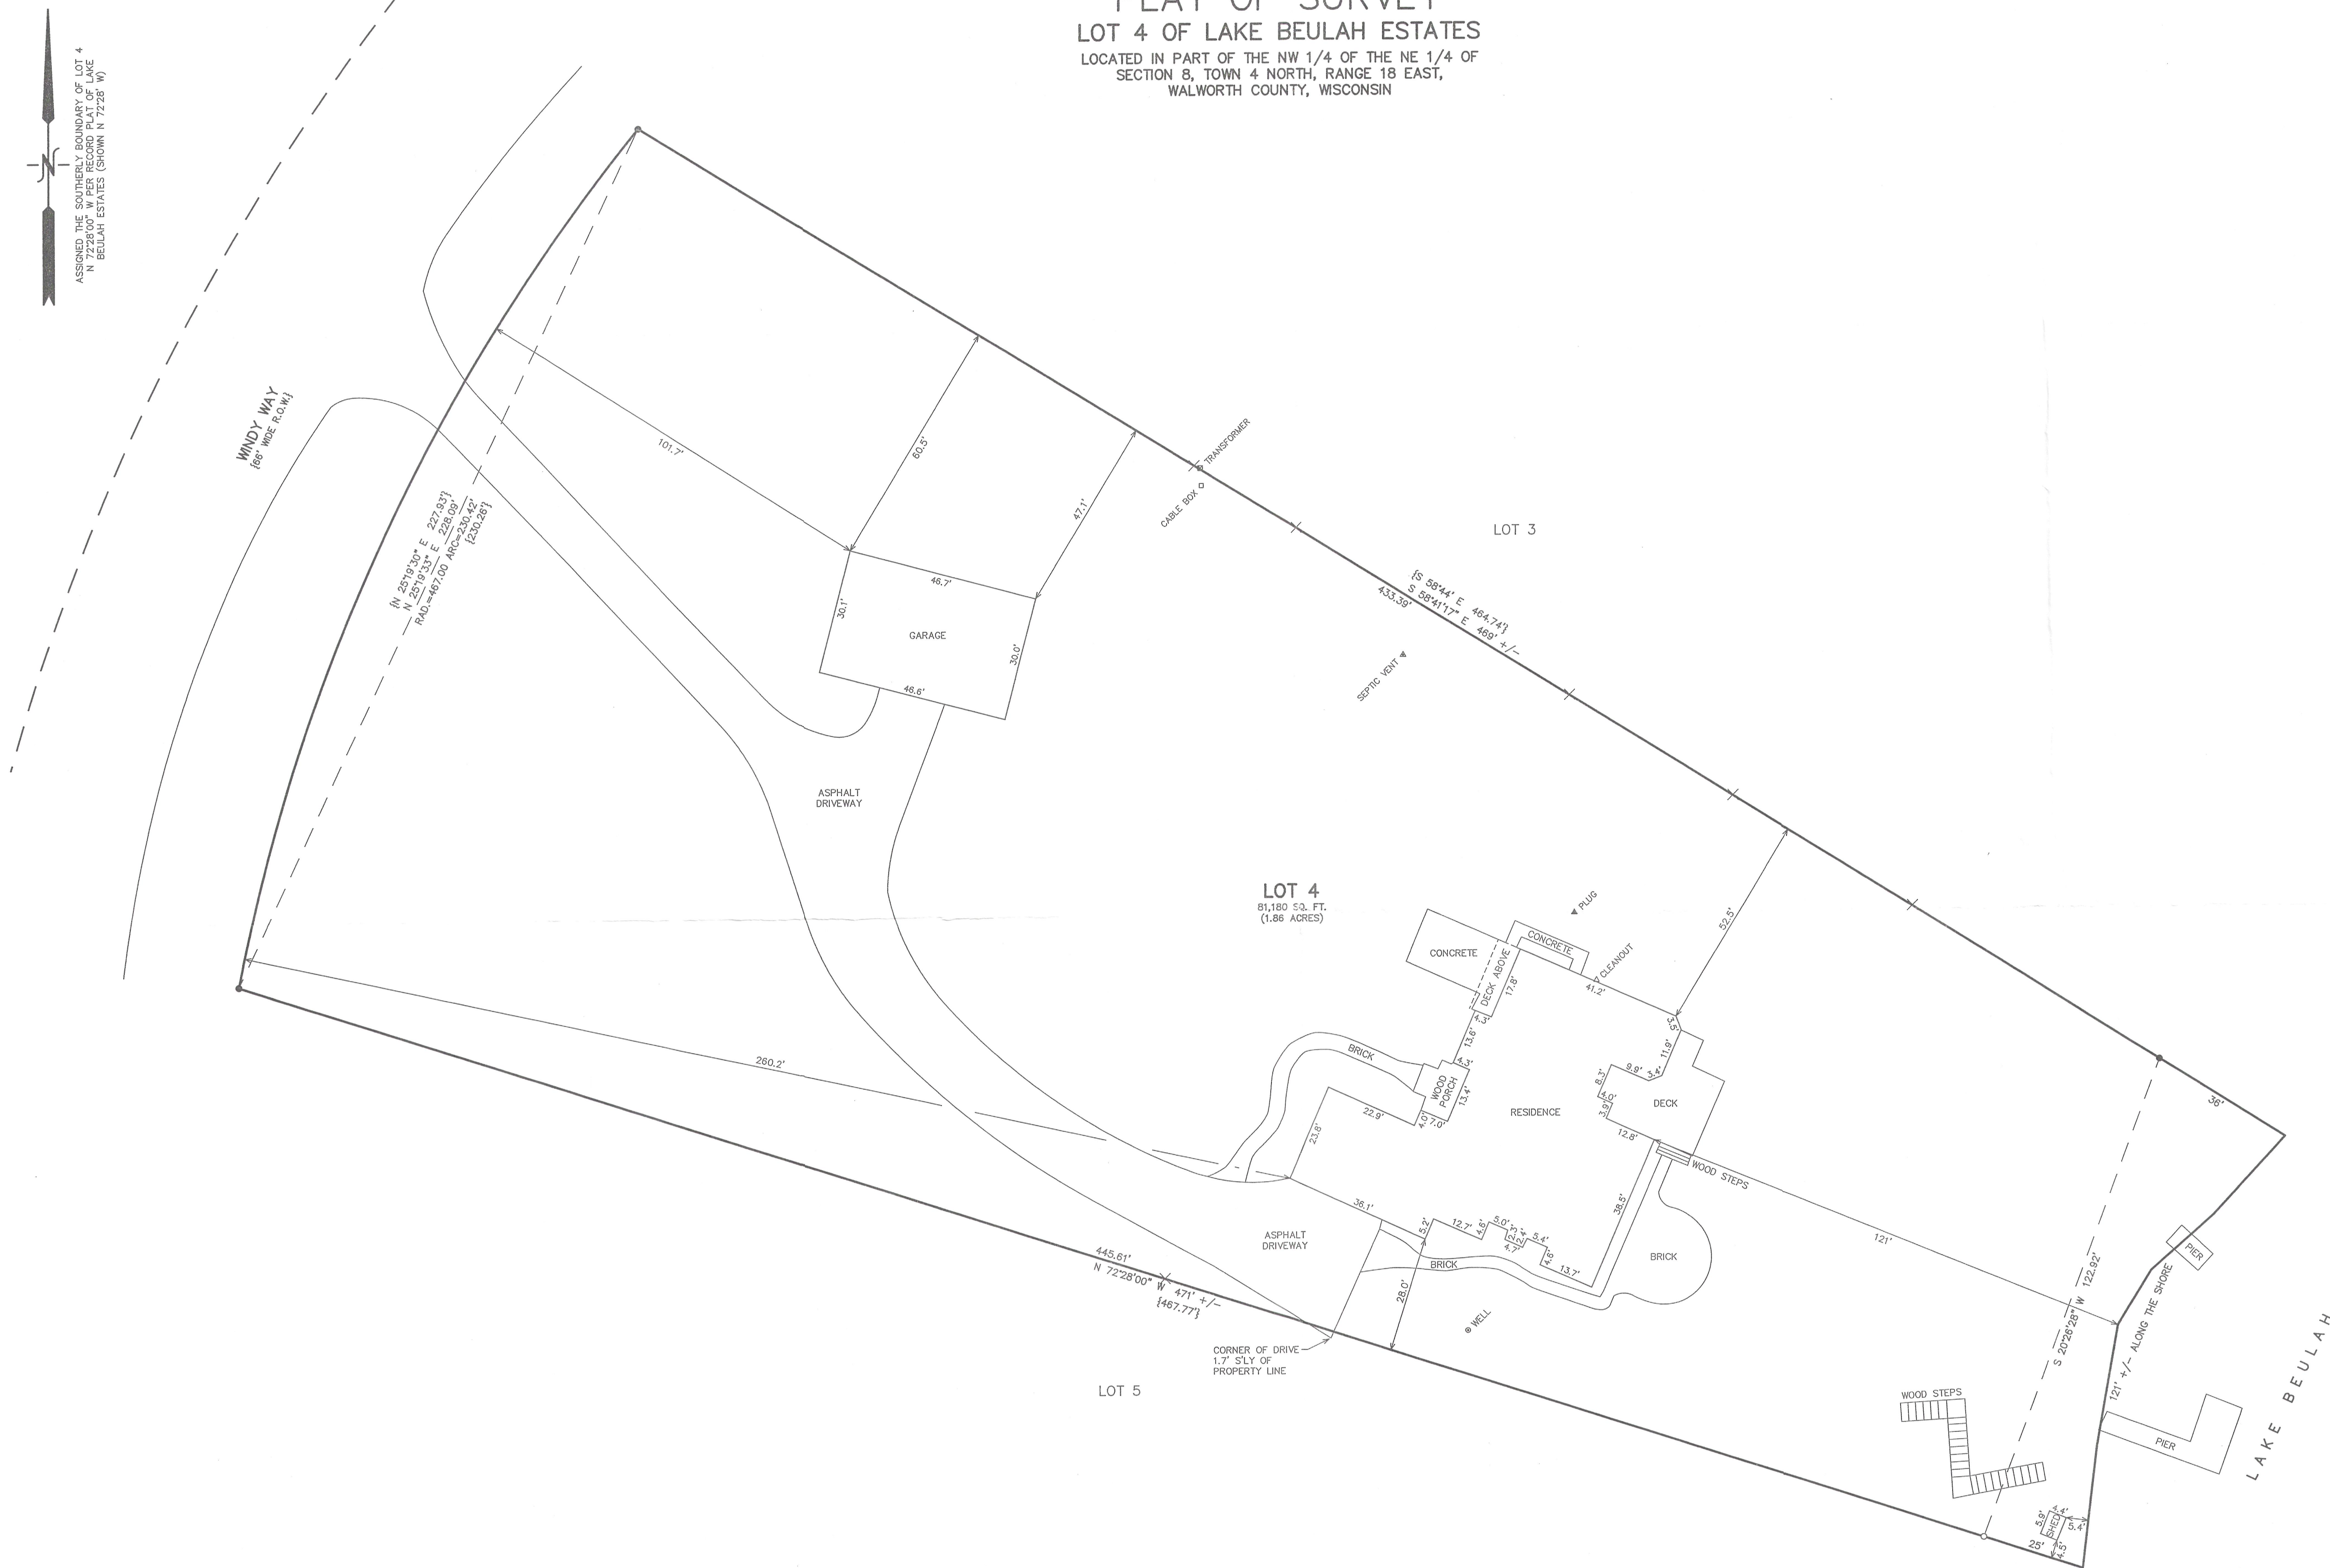

- LEGEND
- = FOUND IRON PIPE STAKE
 - = FOUND IRON REBAR STAKE
 - × = SET LATH ALONG PROPERTY LINE
 - {xxx} = RECORDED AS

RECEIVED
OCT 24 2012
SJK



NOTE: COPIES OF THIS MAP TO WHICH THE FOLLOWING CERTIFICATE WILL APPLY SHOW THE SURVEYOR'S ORIGINAL SEAL AND SIGNATURE IN RED INK. COPIES BY ANY OTHER MEANS MAY HAVE ALTERATIONS WHICH DO NOT REPRESENT THE SURVEYOR'S WORK PRODUCT.

I HEREBY CERTIFY THAT THE ABOVE DESCRIBED PROPERTY HAS BEEN SURVEYED UNDER MY DIRECTION AND THAT THE ABOVE MAP IS A TRUE REPRESENTATION THEREOF AND SHOWS THE SIZE AND LOCATION OF THE PROPERTY AND ITS EXTERIOR BOUNDARIES. THIS SURVEY IS MADE FOR THE USE OF THE PRESENT OWNERS OF THE PROPERTY, AND ALSO THOSE WHO PURCHASE, MORTGAGE, OR GUARANTEE THE TITLE THERETO WITHIN ONE YEAR FROM THE DATE HEREOF.

DATED: 08/20/2012

PETER S. GORDON
LAND SURVEYOR

MAP SCALE IN FEET ORIGINAL 1" = 20'

8/20/2012 X:\Projects\3360\08-20-2012\SURVEY

AME 2.1 JUL

PLC-4

418-9303