



17620 W. National Ave.
New Berlin, Wisconsin 53151
414-784-7971



SCALE 1" = 50'

FOR: REGINA KAMINSKI

Lot 8 and the North one-half of Lot 7, Block 2 Lake Beulah being a subdivision of part of Section 12, Town 4 North, Range 18 East, Town of East Troy, Walworth County, Wisconsin.

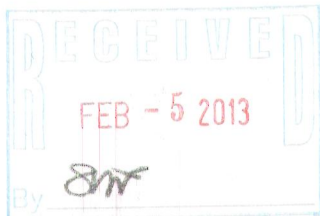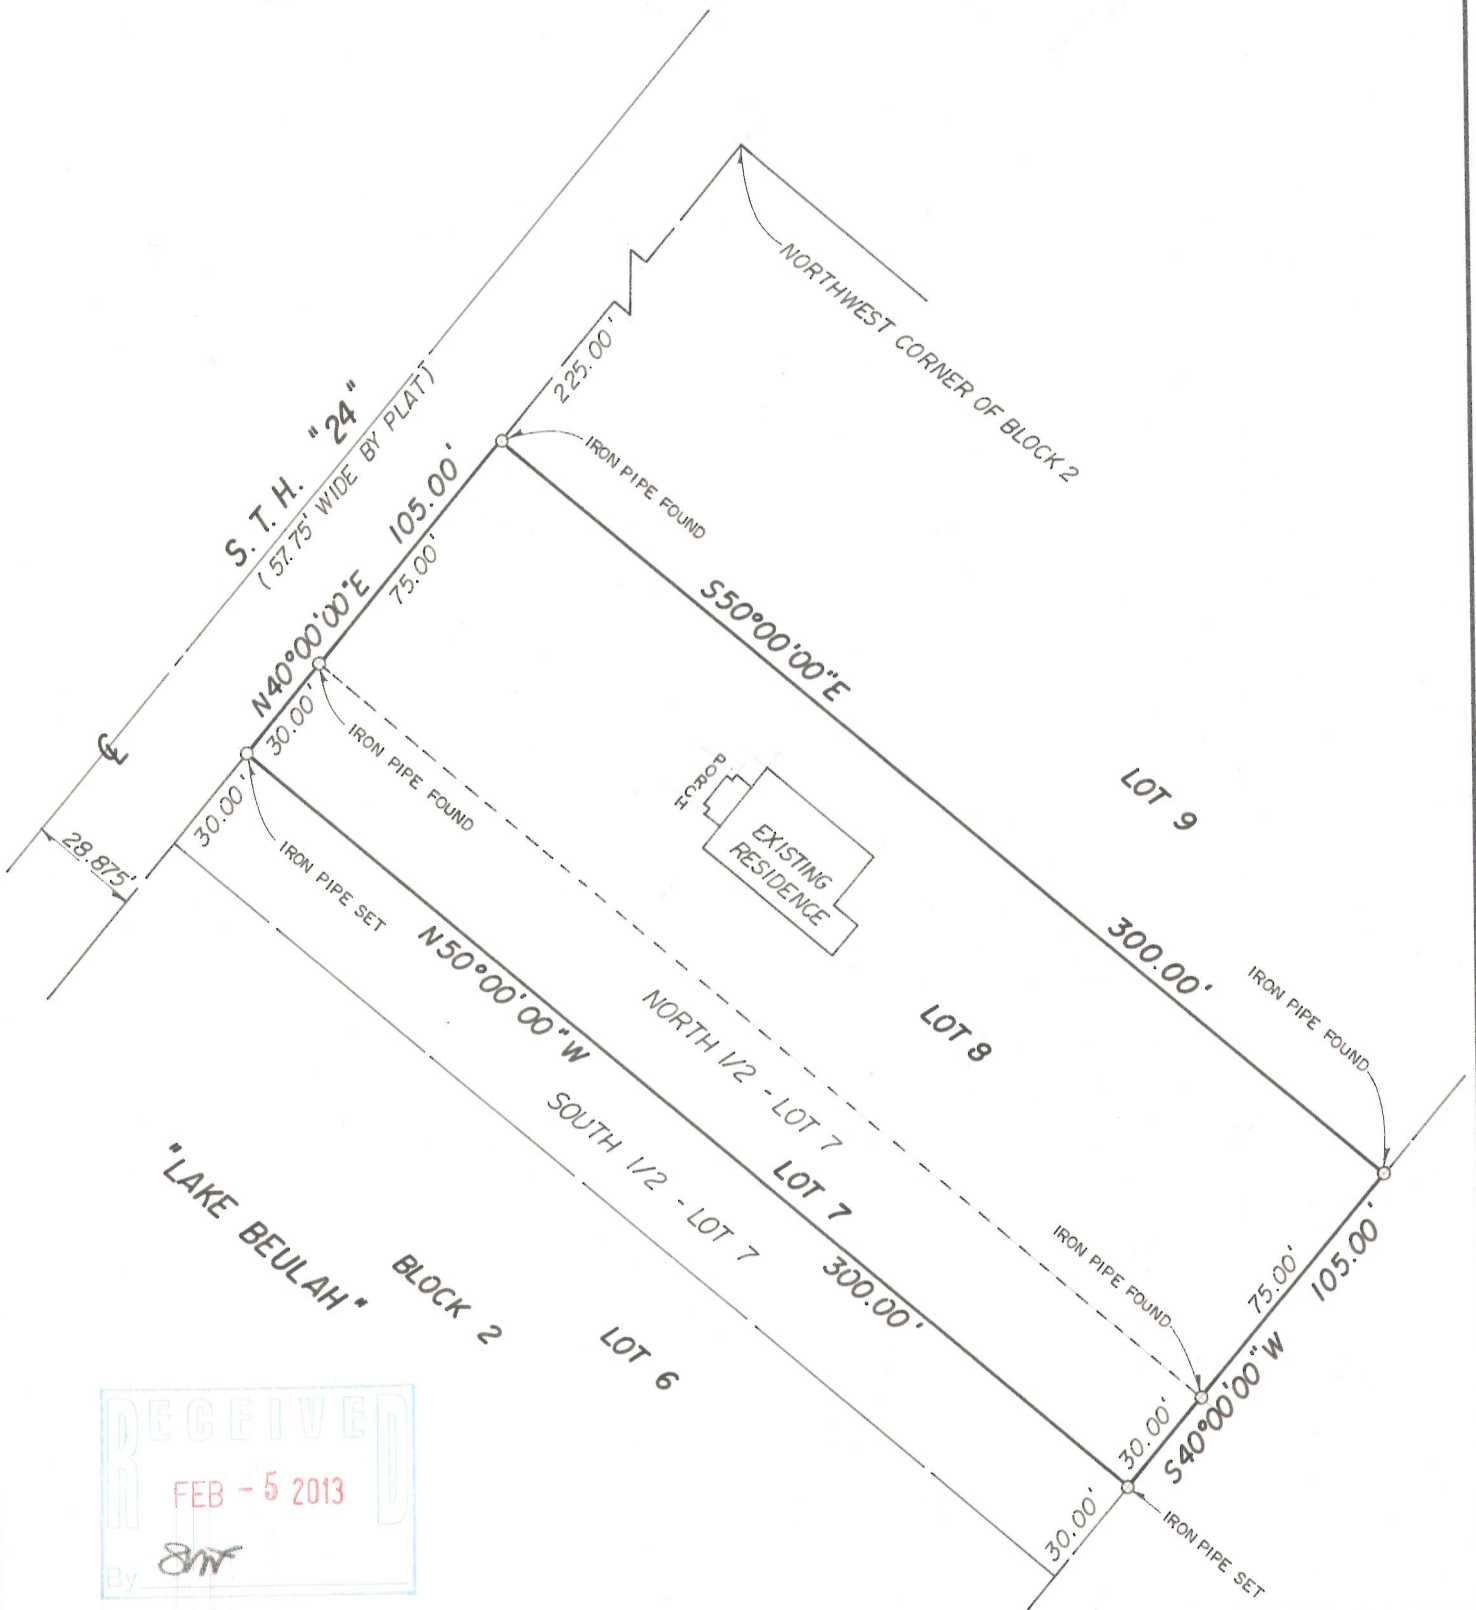

CERTIFICATION

"I HAVE SURVEYED THE ABOVE DESCRIBED PROPERTY, AND THE ABOVE MAP IS A TRUE REPRESENTATION THEREOF AND SHOWS THE SIZE AND LOCATION OF THE PROPERTY, ITS EXTERIOR BOUNDARIES, THE LOCATION AND DIMENSIONS OF ALL STRUCTURES THEREON, FENCES, APPARENT EASEMENTS AND ROADWAYS AND VISIBLE ENCROACHMENTS, IF ANY.
THIS SURVEY IS MADE FOR THE EXCLUSIVE USE OF THE PRESENT OWNERS OF THE PROPERTY, AND ALSO THOSE WHO PURCHASE, MORTGAGE, OR GUARANTEE THE TITLE THERETO, WITHIN ONE (1) YEAR FROM DATE HEREOF; AND AS TO THEM I HEREBY CERTIFY THAT SAID SURVEY AND THE ABOVE MAP WERE MADE IN ACCORDANCE WITH ACCEPTABLE PROFESSIONAL STANDARDS AND THAT THE INFORMATION CONTAINED THEREON IS, TO THE BEST OF MY KNOWLEDGE, INFORMATION AND BELIEF A TRUE AND ACCURATE REPRESENTATION THEREOF."

DATED THIS 22nd DAY OF August, 19 83

Claude C. Johnson, Jr.
REGISTERED LAND SURVEYOR



PLBS-6

DRAFTED BY GREG L. BARLOW

418-2325 JOB NO. 83-139