

WAUKESHA LAND SURVEYS INC.

405 ARCADIAN AVE.



WAUKESHA, WISCONSIN

Plat of Survey

for Mr. Robert Hoffmen

location

801 White Oak Drive in the NW $\frac{1}{4}$ of Section 11, T.4N., R.18E.,
County, Wisconsin.

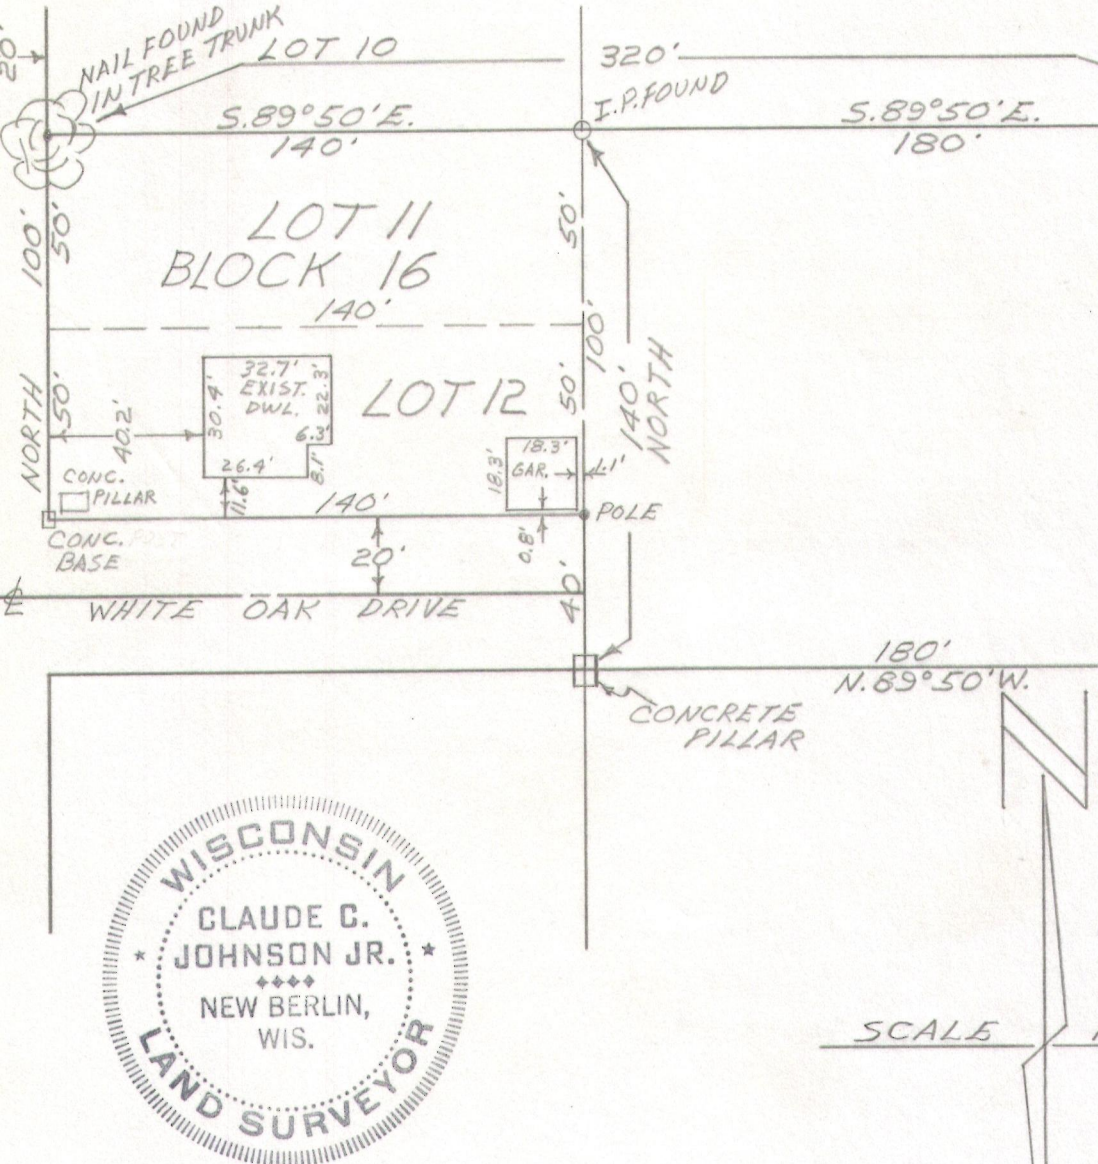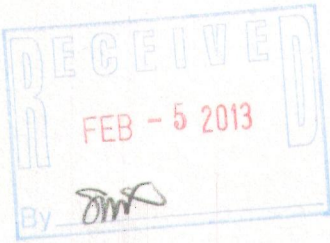

State of Wisconsin }
County of Waukesha } ss.

Certificate

We, WAUKESHA LAND SURVEYS, INC., certify that we have surveyed the above-described property and that the above plat is true and correctly shows the exterior boundary lines and location of existing and other improvements and roads, and other apparent easements.

Dated this 11th day of October 19 67

Claude C. Johnson, Jr.
Land Surveyor No. S-765

MR-191