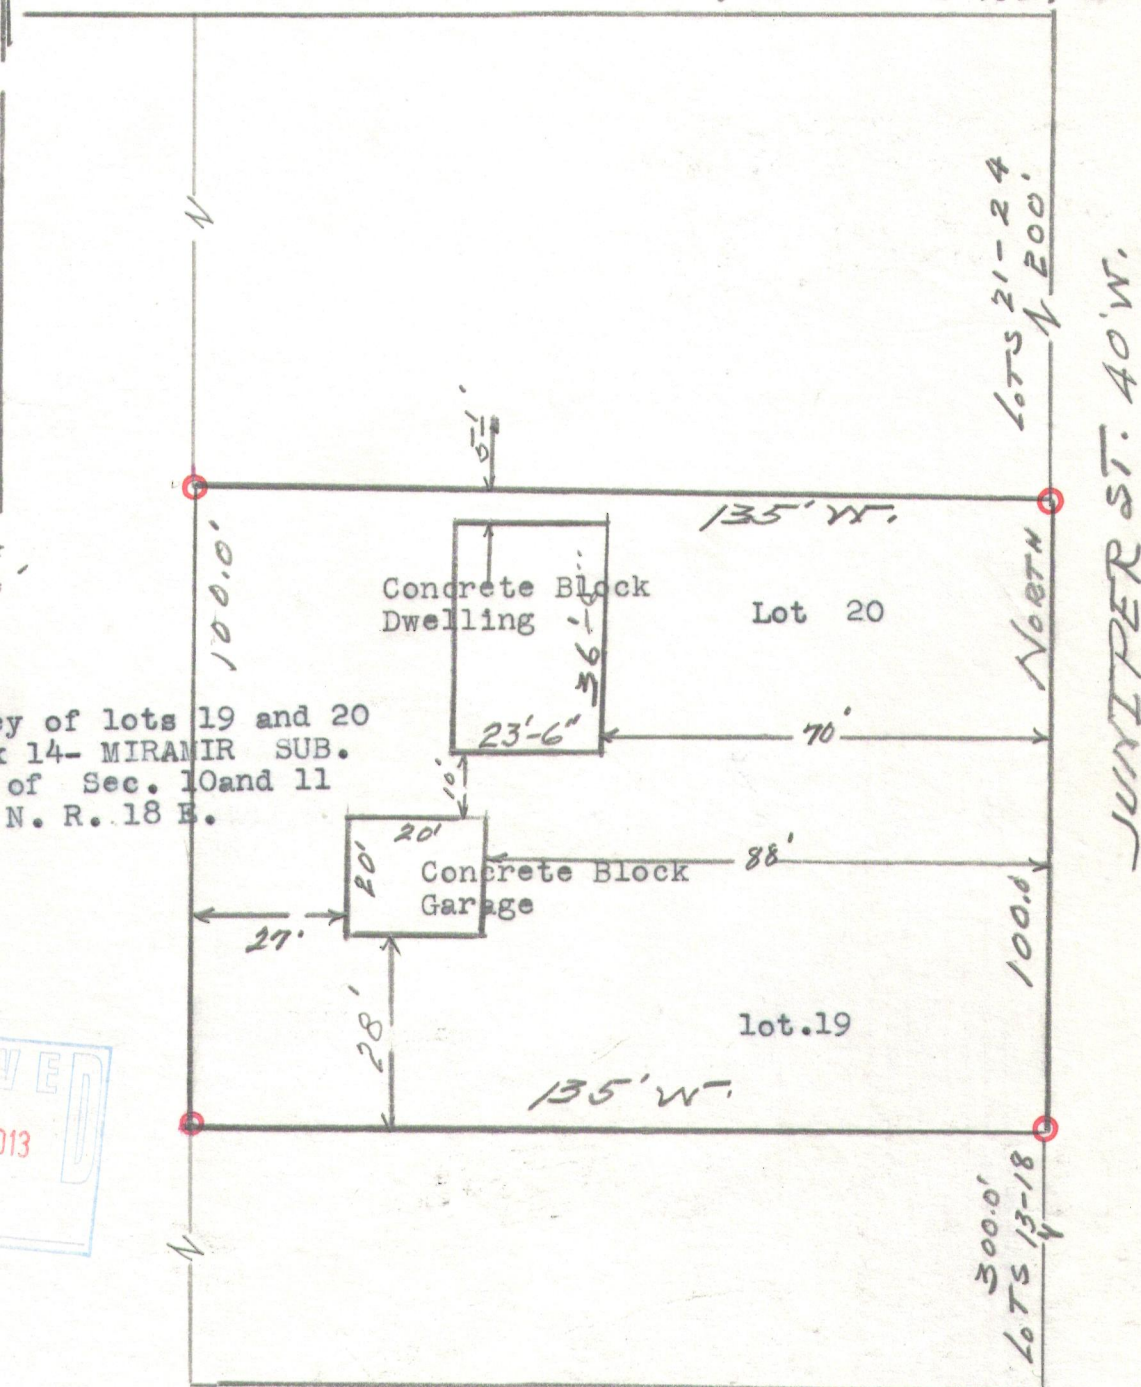


LLOYD S. DANCEY
ENGINEER E-338
PROFESSIONAL ENGINEERING AND PLATTING
SURVEYING AND
125 NORTH CHARLES ST.
WAUKESHA, WIS.

Plat of Survey *NORTHMAN RD. 49.5' W*

consin } SS.
aukesha }

Certificate *WHITE OAK DR. 40'vv-*

I, _____, surveyor, do hereby certify that I have made the survey of lands shown on the within
correctly represented the principal lines and measurements thereof and of the buildings shown thereon.

Lloyd Stacey Surveyor

22 June 53
_____ day of _____ 19_____

418-2329