

PLAT OF SURVEY
LOTS 75, 77, 78, 79 AND 80, OF O-TON-KAH SUBDIVISION, according to the plat thereof recorded in Volume 8 of Plats, Pages 111 and 112, Walworth County, Wisconsin.


Surveyed for: Irene Keats

Survey address: N9144 Deer Path Road

DEER PATH ROAD

MONUMENTATION AND FENCE LOCATION WAS
WAIVED BY CLIENT IN ACCORDANCE WITH
A-E 7.01(2) OF THE WISCONSIN
ADMINISTRATIVE CODE.

BEARINGS ARE ASSUMED THAT THE
EAST LINE OF SUMAC DRIVE
BEARS SOUTH

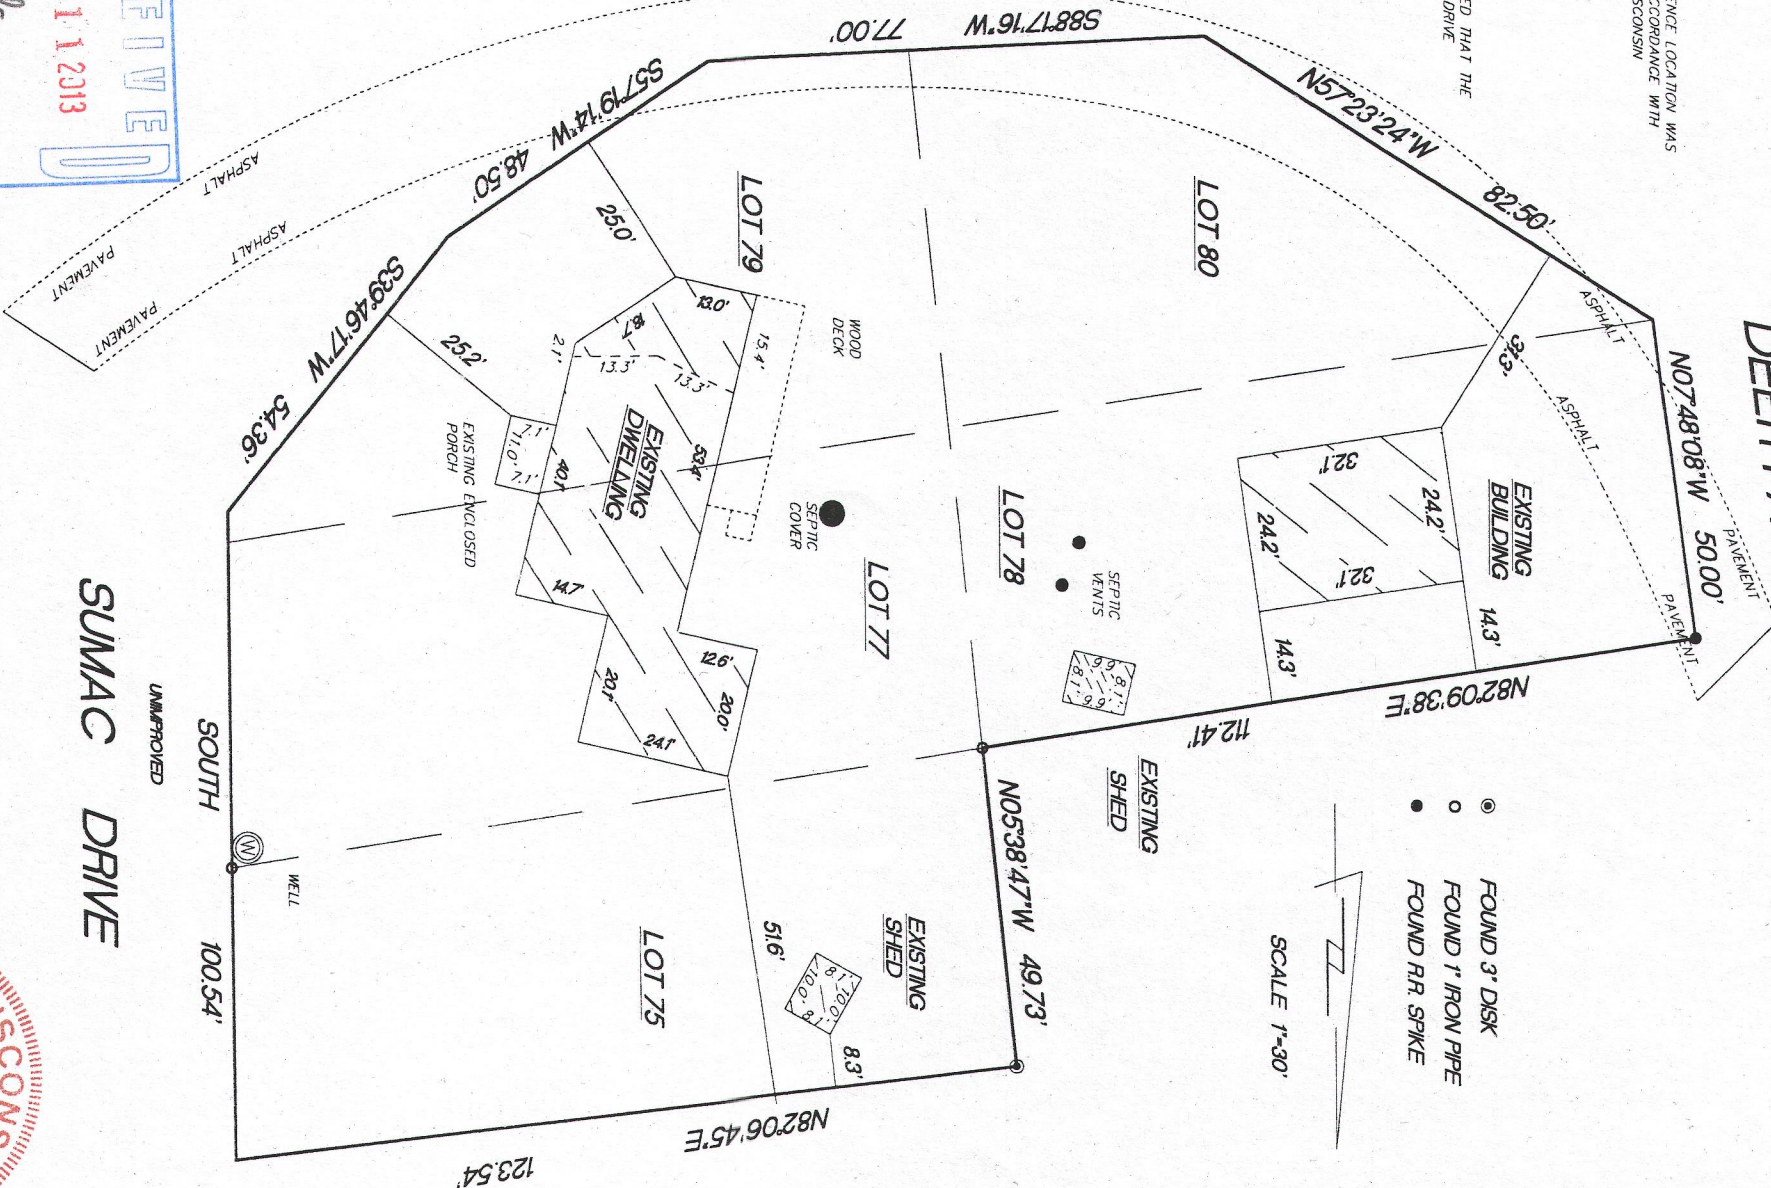

"I hereby certify that I have surveyed the above described property and that the above map is a true representation thereof and shows the size and location of the properties exterior boundaries.

"This survey is made for the use of the present owners of the property, and also those who purchase, mortgage or guarantee the title thereto within one year from date hereof."

REV 3/3/11 REV 4/3/13
REV 10/28/10 REV 12/6/12
REV 10/21/10 REV 10/4/12


DATE

TEP/DW
FIELD WORK BY

TEP
DRAWN BY

JOB NUMBER
03121

KETTLE MORaine SURVEYING INC.
575 W36245 Wilton Road
Eagle Wisconsin 53119
P.O. Box 357
(262) 594-3484 / kettlemorainesurvey.com
Terrance E. Pisarek R.L.S.

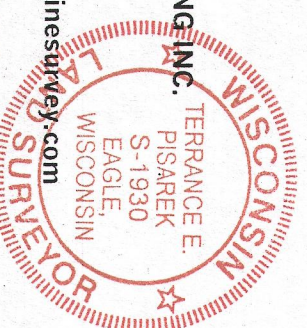

THIS IS NOT AN ORIGINAL SURVEY UNLESS THE SEAL IS RED.

POT 06029

418-2344