

# Plat of Survey

of  
**Lots 28 & 29 of Fairway Subdivision,**


located in the Northeast 1/4 of Section 4, Town 4 North, Range 18 East, Town of East Troy, Walworth County, Wisconsin.

Surveyed for: **Andy Cobb**  
 W1485 Brassie Drive  
 Mukwonago, Wisconsin. 53149

Tax Parcel  
 PWP 00015D



Bearings reference to the plat  
 of Fairway Subdivision.

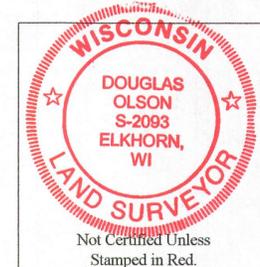

**Notes:**

- 1) This survey plat is not certified unless signed and sealed in red ink.
- 2) This survey is subject to Wisconsin lien laws. This Plat of Survey is the notice of intent to file lien. Lien waiver required.




Copyright 2013 by Jensen & Olson Land Surveying, LLC.


All rights reserved. No part of this survey plat may be reproduced or transmitted in any form by any means - graphic, electronic, or mechanical, including photocopying, tracing, or information storage and retrieval systems - without permission in writing from Douglas G. Olson, Jensen & Olson Land Surveying, LLC.

I, Douglas G. Olson, Wisconsin Registered Land Surveyor, do hereby certify that this survey was performed by me, or under my direction in full compliance with the owner's/agent's instructions and Chapter A-E 7 of the Wisconsin Administrative Code "Minimum Standards for Property Surveys"; and that this map is an accurate representation thereof to the best of my knowledge and belief.

Douglas G. Olson  
 Wisconsin Registered Land Surveyor - 2093

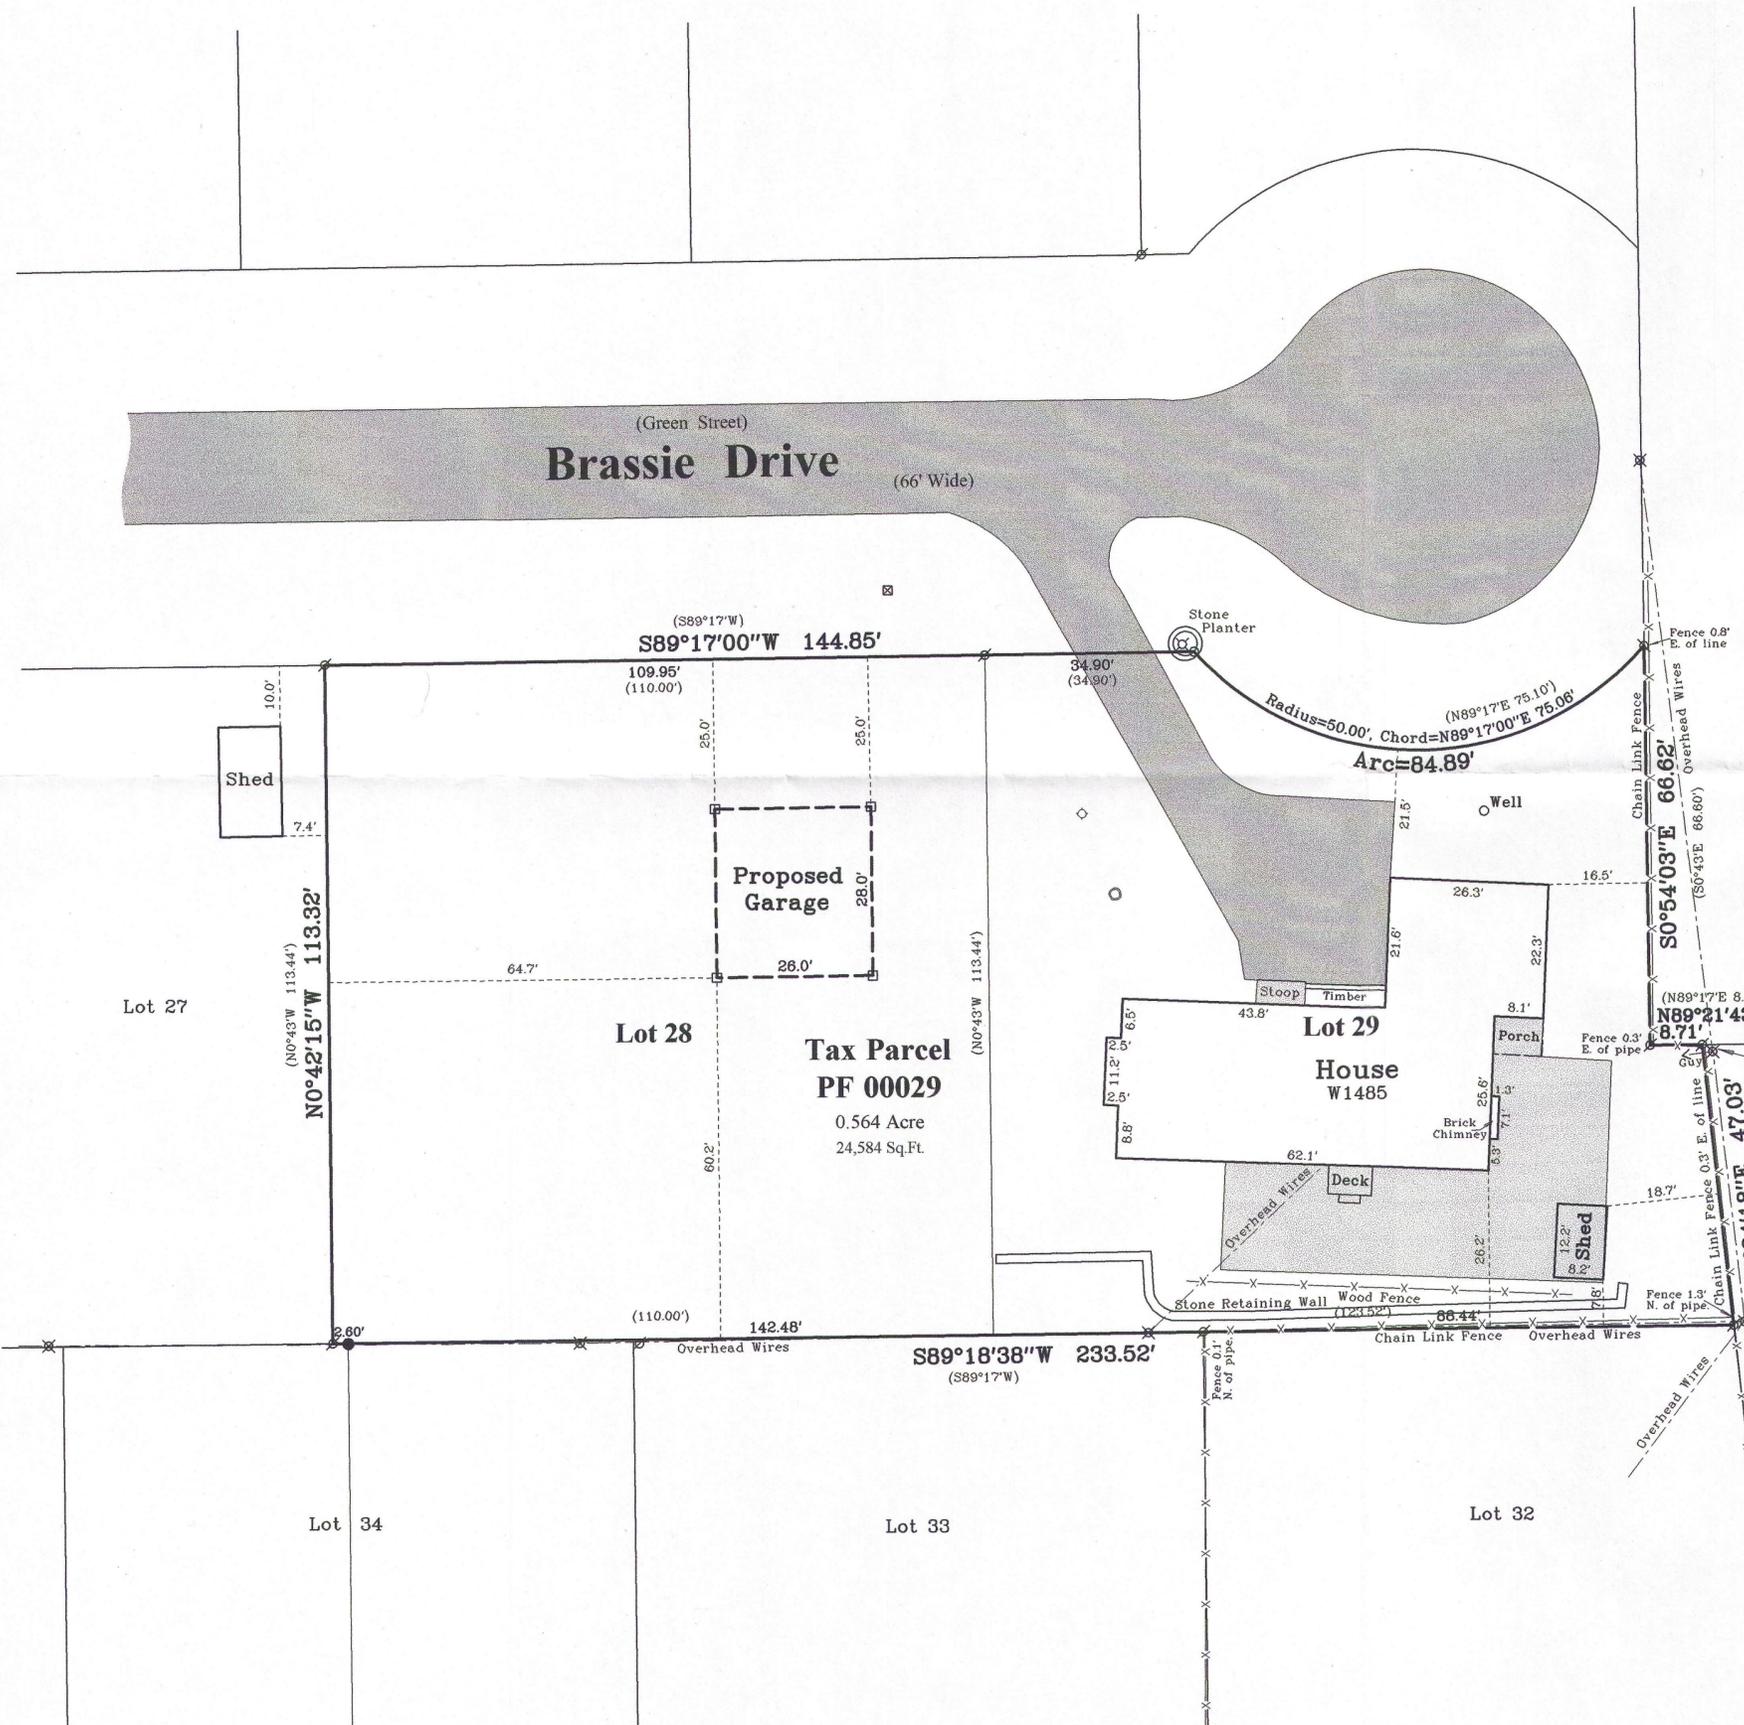

Survey Date: April 1, 2013  
 Revisions:

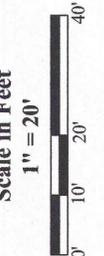

**Jensen & Olson Land Surveying, LLC**  
 45 South Wisconsin Street \* P.O. Box 322 \* Elkhorn, Wisconsin. 53121  
 Telephone: (262) 723-3434 \* Facsimile: (262) 723-8044  
 Email: jensen.olson@elknet.net

- Legend**
- Found Iron Pipe, 1-1/4" dia.
  - Found Iron Rod
  - Set Wood Stake
  - Set Iron Pipe, 1" dia.
  - Recorded Information
  - Utility Pole
  - Utility Pedestal
  - Concrete Cover
  - Septic Vent
  - Asphalt Surface
  - Concrete

Sheet 1 of 1 Sheets  
 Job Reference Number  
**2013-024**

2013.024

PF 00029 418-2351