

Plat of Survey


of

Lots 28 & 29 of Fairway Subdivision,


located in the Northeast 1/4 of Section 4, Town 4 North, Range 18 East, Town of East Troy, Walworth County, Wisconsin.

Surveyed for: **Andy Cobb**
W1485 Brassie Drive
Mukwonago, Wisconsin. 53149

Tax Parcel
PWP 00015D

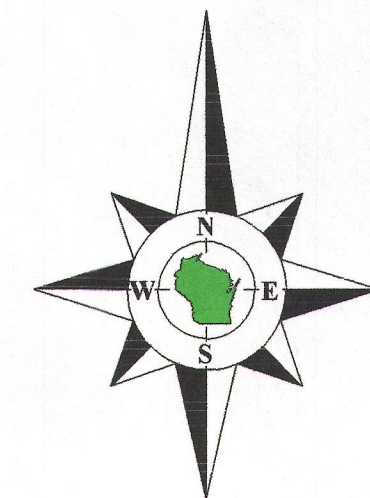

Bearings reference to the plat
of Fairway Subdivision.

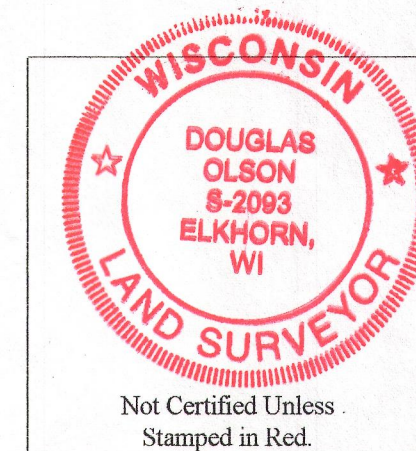

Notes:

- 1) This survey plat is not certified unless signed and sealed in red ink.
- 2) This survey is subject to Wisconsin lien laws. This Plat of Survey is the notice of intent to file lien. Lien waiver required.

Copyright 2013 by Jensen & Olson Land Surveying, LLC.

All rights reserved. No part of this survey plat may be reproduced or transmitted in any form by any means - graphic, electronic, or mechanical, including photocopying, tracing, or information storage and retrieval systems - without permission in writing from Douglas G. Olson, Jensen & Olson Land Surveying, LLC.

I, Douglas G. Olson, Wisconsin Registered Land Surveyor, do hereby certify that this survey was performed by me, or under my direction in full compliance with the owner's/agent's instructions and Chapter A-E 7 of the Wisconsin Administrative Code "Minimum Standards for Property Surveys"; and that this map is an accurate representation thereof to the best of my knowledge and belief.

Douglas G. Olson
Wisconsin Registered Land Surveyor - 2093

Survey Date: April 1, 2013.
Revisions: No. 1 - Garage as-built

Scale in Feet
1" = 20'



Jensen & Olson Land Surveying, LLC
45 South Wisconsin Street * P.O. Box 322 * Elkhorn, Wisconsin. 53121
Telephone: (262) 723-3434 * Facsimile: (262) 723-8044
Email: jensen.olson@elknet.net

Legend
Found Iron Pipe, 1-1/4" dia. ☐ Set Wood
Found Iron Rod, 1" dia. ☐ State
Sectioned Information
Utility Pole, 1" dia. ☐ State
Utility Pedestal, 1" dia. ☐ State
Concrete Cover, 6" dia. ☐ State
Asphalt Surface ☐ Concrete

Sheet 1 of 1 Sheets
Job Reference Number
2013.024

2013.024

418-2368