

PLAT OF SURVEY

RE-CERTIFICATION

PROPERTY DESCRIPTION:

LOT 4 OF HIDDEN OAKS SUBDIVISION, BEING PART OF THE NE 1/4, SE 1/4, NW 1/4, AND SW 1/4 OF TH SW 1/4 OF SECTION 3, TOWN 4 NORTH, RANGE 18 EAST, TOWN OF EAST TROY, WALWORTH COUNTY, WISCONSIN.

UNPLATTED
LANDS

N85°20'03"E 268.73'

N09°14'13"W 403.05'

LOT 4
218,282 S.F.
5.01 ACRES

324.75'

S26°54'10"E 568.41'

LOT 5

HOUSE
UNDER
CONSTRUCTION

139.40'

GRAVEL DRIVE

159.05'

CABLE BOX
ON PROPERTY
CORNER

195.79'

N86°30'03"W

C1

82.26'

HIDDEN OAKS DR.


66.00'

N66°16'25"W

118.00'

S31°29'03"W 265.57'

LOT 3

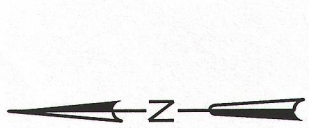

LEGEND:

(100.00') RECORDED DISTANCE

100.00' MEASURED DISTANCE

● 1" FOUND IRON PIPE,
UNLESS NOTED

⊘ 3/4" x 18" IRON PIPE SET,
1.13 lbs./L.F.

⊙ SOIL BORING

UNPLATTED
LANDS

SURVEY DATE: 7/24/2013

SURVEY MADE FOR:

BRIAN & TARA LOOMIS


LOT 4 HIDDEN MEADOWS

LOT SURVEY/HSE STAKE OUT

V2G
SURVEYING, LLC
550 BAYVIEW ROAD SUITE 8
MUKWONAGO, WI 53149
(262) 662-0110

THIS SURVEY IS MADE FOR THE USE OF THE PRESENT OWNERS OF THE PROPERTY, AND ALSO THOSE WHO PURCHASE, MORTGAGE OR GUARANTEE TITLE TO WITHIN ONE (1) YEAR FROM DATE HERETO.

I, MICHAEL A. GREESON R.L.S. #2770, HEREBY CERTIFY THAT THIS SURVEY WAS MADE IN ACCORDANCE WITH THE MINIMUM STANDARDS FOR PROPERTY SURVEYS (CHAPTER A-E 7) FOR THE STATE OF WISCONSIN AND HAS BEEN PREPARED UNDER MY DIRECTION AND CONTROL AND IS CORRECT TO THE BEST OF MY KNOWLEDGE AND BELIEF.

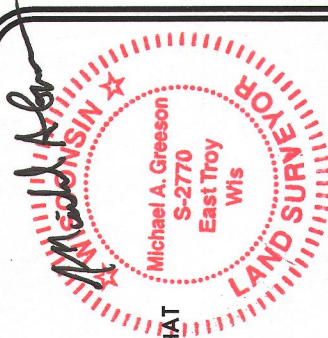

FILE NAME: \$FILES\$

PLOT DATE: 7/24/2013

V2G JOB#: 2013-020

PHO -4

418-2380