


PREPARED FOR
DONALD CAMERON
513 S. PROSPECT AVE.
PARK RIDGE IL. 60068

PLAT OF SURVEY OF


KROTT SURVEYING INC.
(262) 248-3697
N 3705 WILLOW BEND LANE
LAKE GENEVA WI. 53147

LOT 37 OF SHOREWOOD SUBDIVISION, BEING A SUBDIVISION OF A PART OF
THE SOUTHEAST 1/4 OF SECTION 10, THE SOUTHWEST 1/4 OF SECTION 11,
THE NORTHWEST 1/4 OF SECTION 14 AND THE NORTHEAST 1/4 OF SECTION
15 ALL IN TOWN 4 NORTH, RANGE 18 EAST, WALWORTH COUNTY, WISCONSIN.

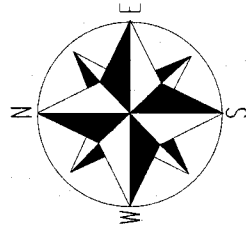

SCALE 1" = 30'

NOTE: BEARINGS ARE REFERENCED TO THE RECORD PLAT.


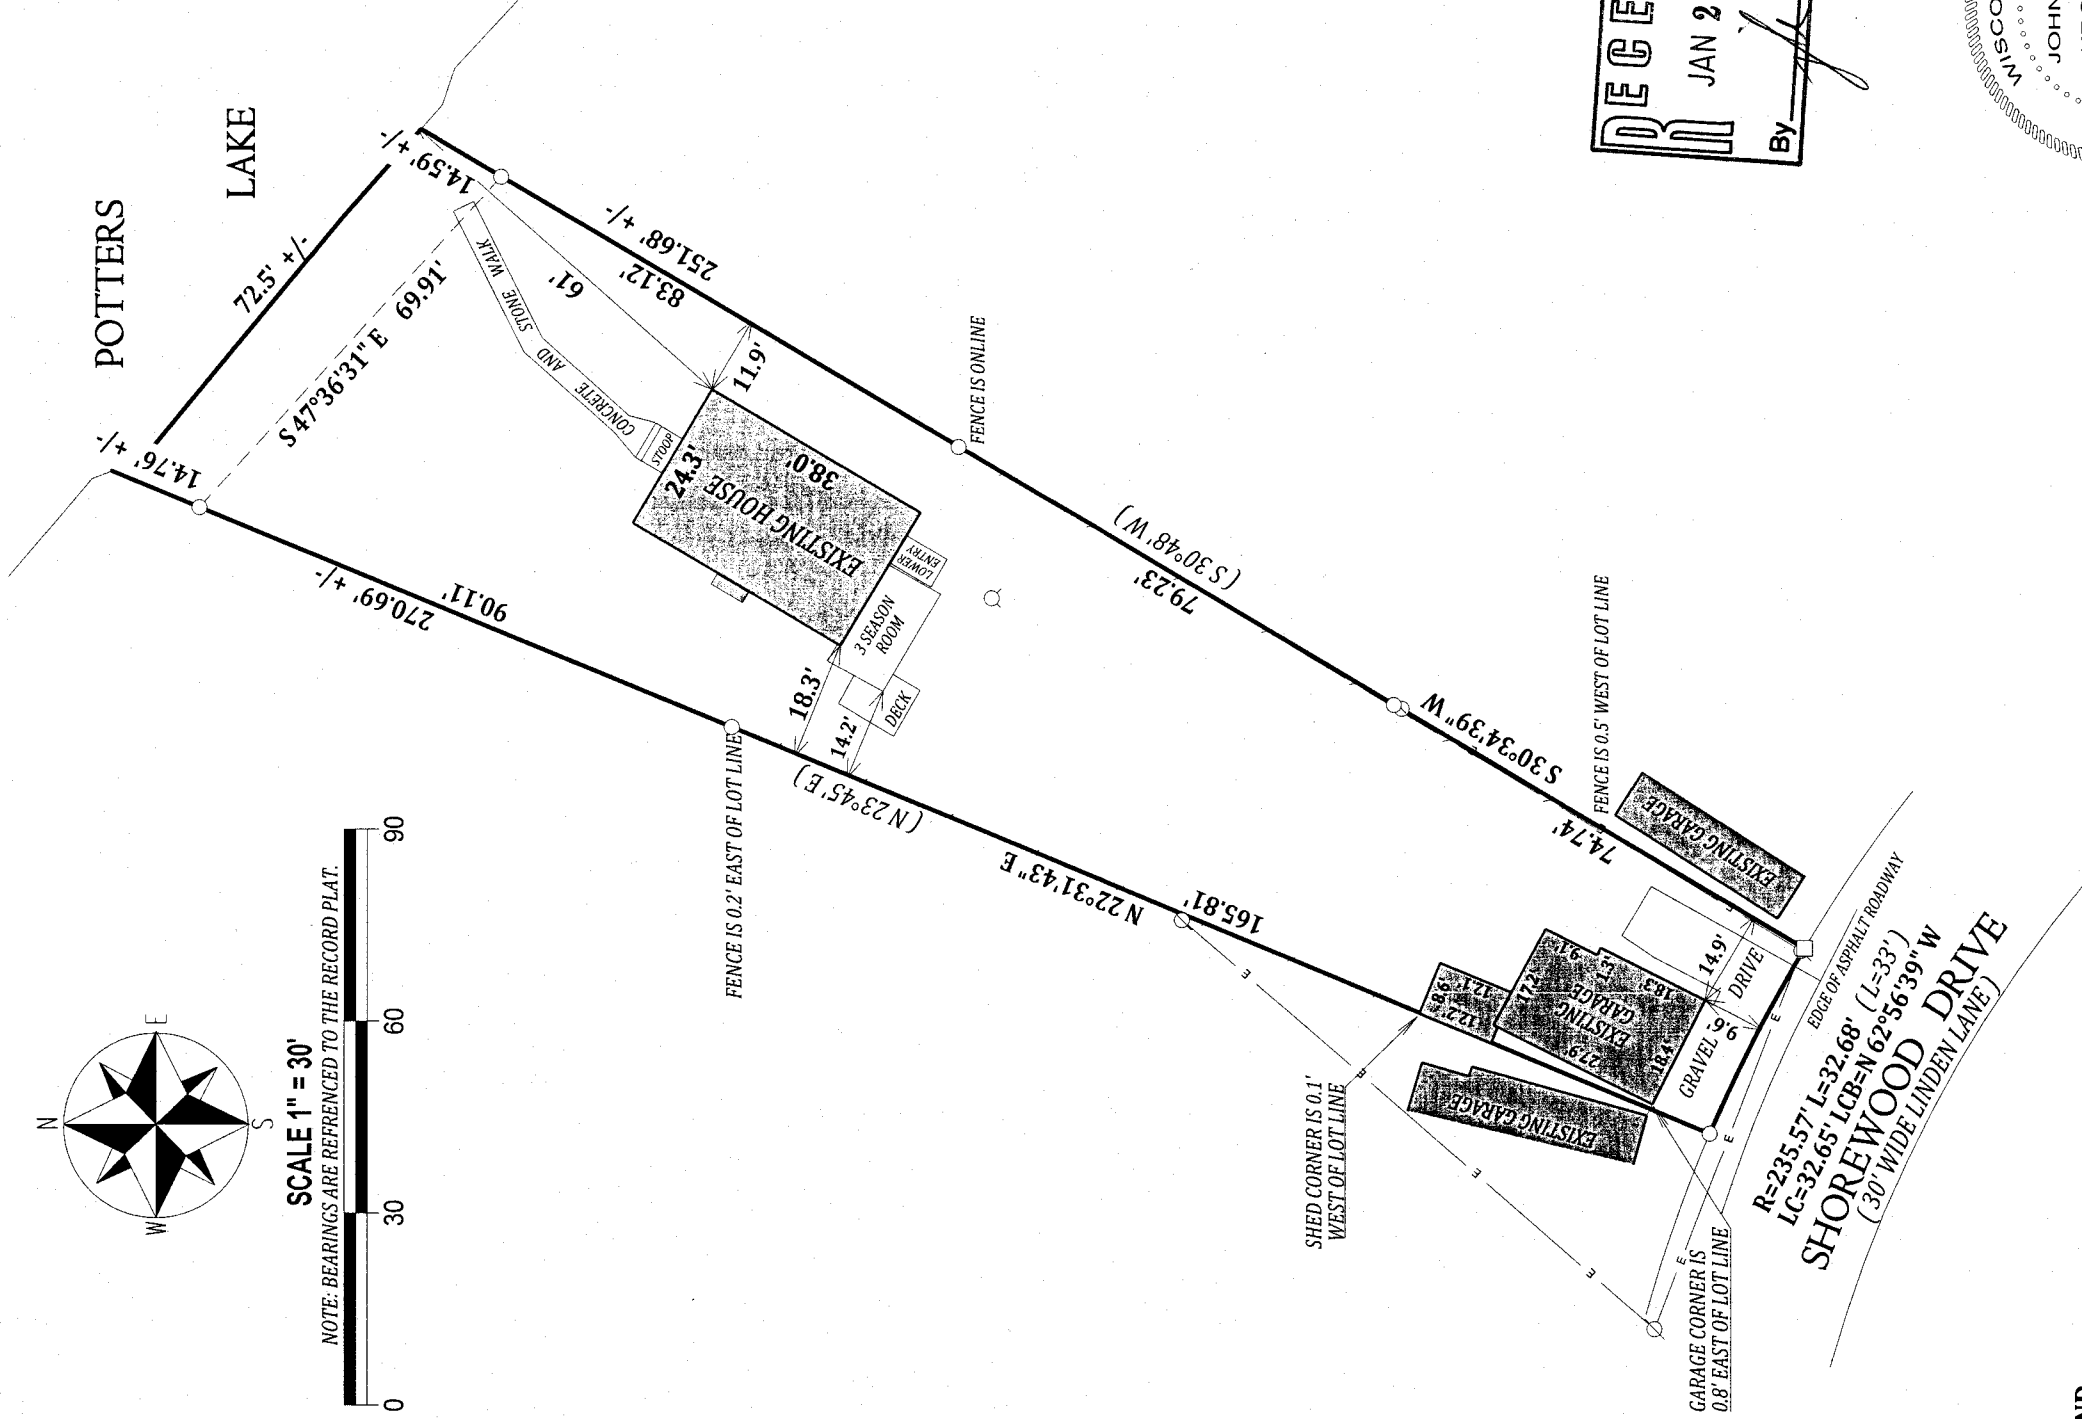


LEGEND

- FOUND IRON PIPE
- FOUND IRON BAR
- ⊙ WELL
- ⊗ UTILITY POLE
- OVER HEAD WIRES
- WOOD FENCE

(XX) RECORDED AS
TAX ID # PS00037

JOB # 13-161

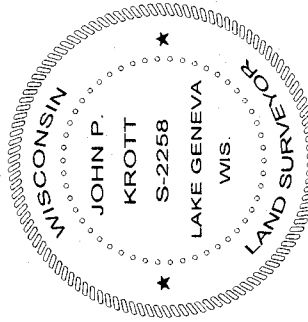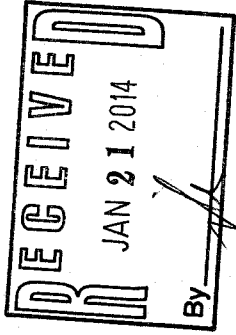

DATED THIS 25th DAY OF OCTOBER 2013

I have surveyed the above-described property and the above map is a true representation thereof and shows the size and location of the property, its exterior boundaries, the location and dimensions of all structures thereon, fences apparent easements and roadways and visible encroachments, if any.

This survey is made for the exclusive use of the present owners of the property, and also those who purchase, mortgage, or insure the title thereto within one (1) year from date hereof; and as to them I warrant the accuracy of said survey map.

John P. Krott

JOHN P. KROTT S-2258
WISCONSIN REGISTERED LAND SURVEYOR
(NOTE: THIS IS NOT A CERTIFIED COPY
UNLESS SIGNED IN RED INK)