

AS-BUILT SURVEY



5492 S. WESTRIDGE DR.
NEW BERLIN, WI 53151
262-402-3040


DATE: 9-20-13

FOR: MICHAEL POLSKY TRUST

LEGAL DESCRIPTION

LOT 10, LAKE BEULAH ESTATES, ACCORDING TO THE RECORDED PLAT THEREOF, RECORDED AS DOC. #169988, BEING A REDIVISION OF LOTS 4, 5 AND PART OF LOT 3 OF STEVENS SUBDIVISION LOCATED IN GOVERNMENT LOT 1 IN THE NE 1/4 OF SECTION 8, TOWN 4 NORTH, RANGE 18 EAST, TOWN OF EAST TROY, WALWORTH COUNTY, WISCONSIN, EXCEPTING THEREFROM LANDS DESCRIBED IN GUT CLAIM DEED, DOCUMENT NO. 196498.

LEGEND



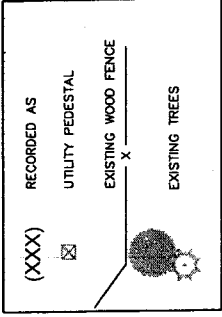


NOTES:

1. BASIS OF BEARING-- THE SOUTH LINE OF LOT 10 WAS TAKEN TO BEAR S89°23'56"E, AS PER LAKE BEULAH ESTATES FINAL PLAT, DOC. NO.: 169988
2. IN ACCORDANCE WITH SS. AE 7.01 (2) THE OWNER, MICHAEL P. POLSKY, TRUSTEE, HEREBY WAIVES MONUMENTATION OF THIS PLAT OF SURVEY, WAIVER HELD IN OFFICE FILES.




HOUSE DETAIL

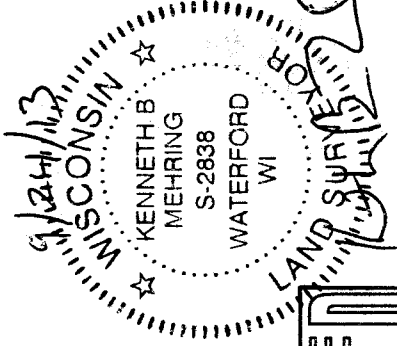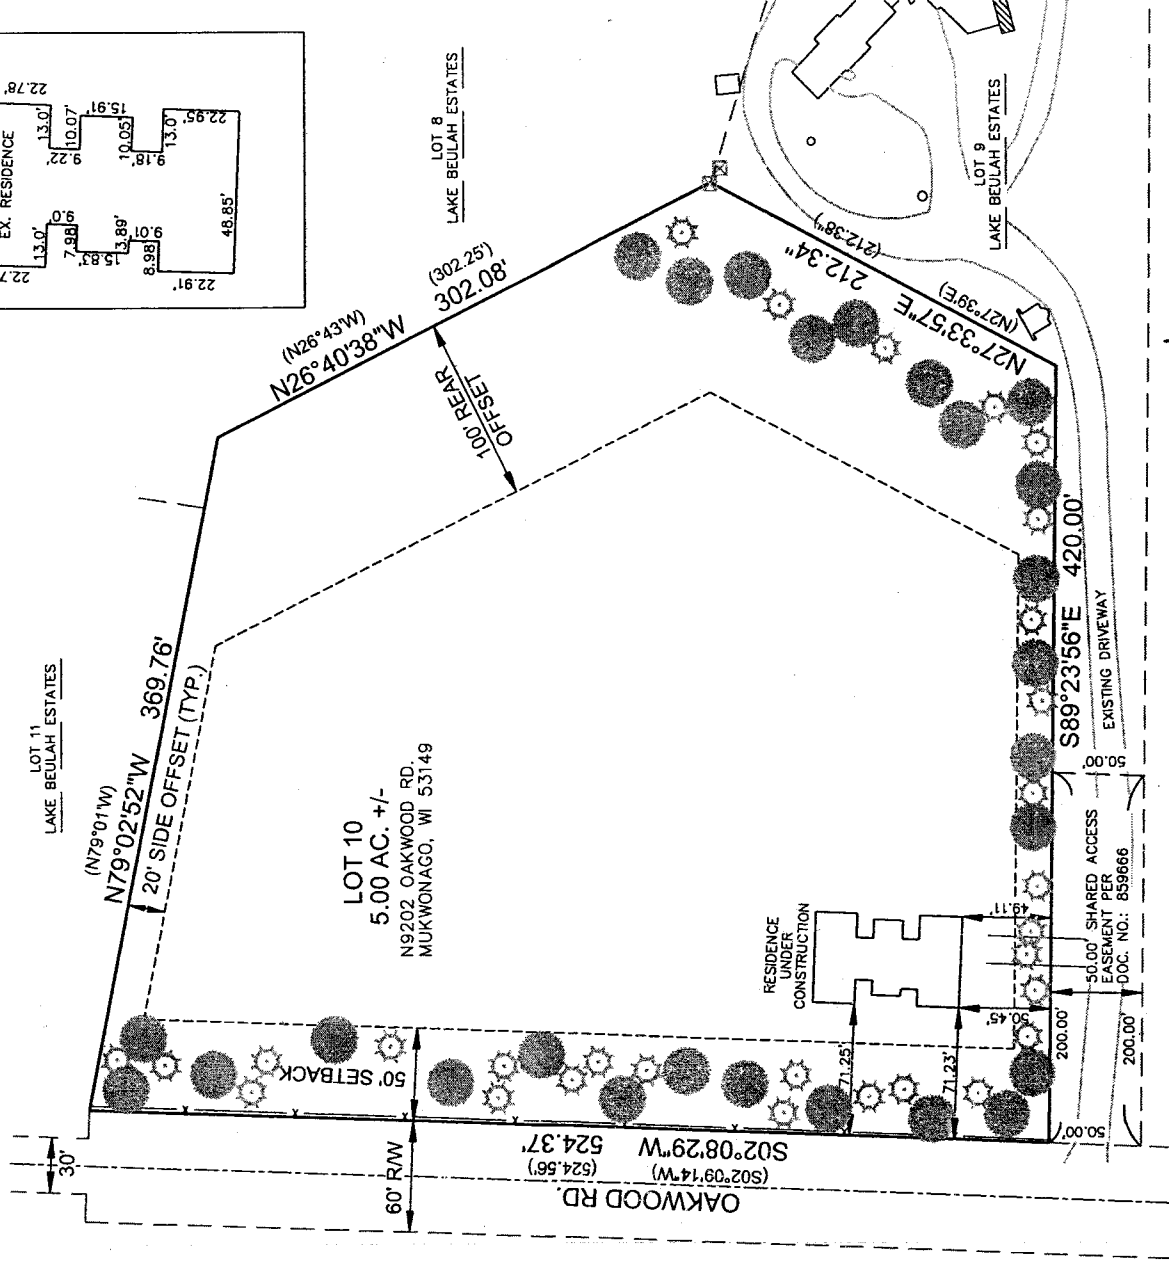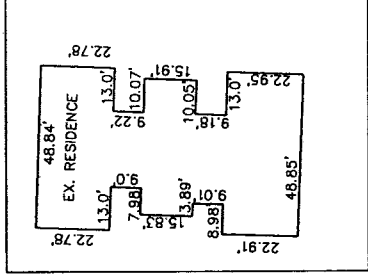

SURVEYOR'S CERTIFICATE:
THIS SURVEY IS MADE FOR THE USE OF THE PRESENT OWNERS OF THE PROPERTY, AND ALSO THOSE WHO MORTGAGE OR GUARANTEE TITLE TO WITHIN ONE (1) YEAR FROM DATE HERETO

I, KENNETH B. MEHRING, #2838, HEREBY CERTIFY THAT THIS SURVEY WAS MADE IN ACCORDANCE WITH THE MINIMUM STANDARDS FOR PROPERTY SURVEYS (CHAPTER AE-7) FOR THE STATE OF WISCONSIN AND HAS BEEN PREPARED UNDER MY DIRECTION AND CONTROL AND IS CORRECT TO THE BEST OF MY KNOWLEDGE.

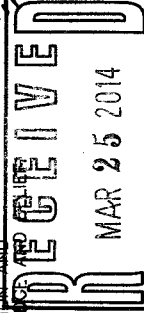

KENNETH B. MEHRING, R.L.S. S-2838

By *fc*

PLBE -10

418-2398

DATE 9/20/2013
SHEET 1 OF 1
DWG#13-011