


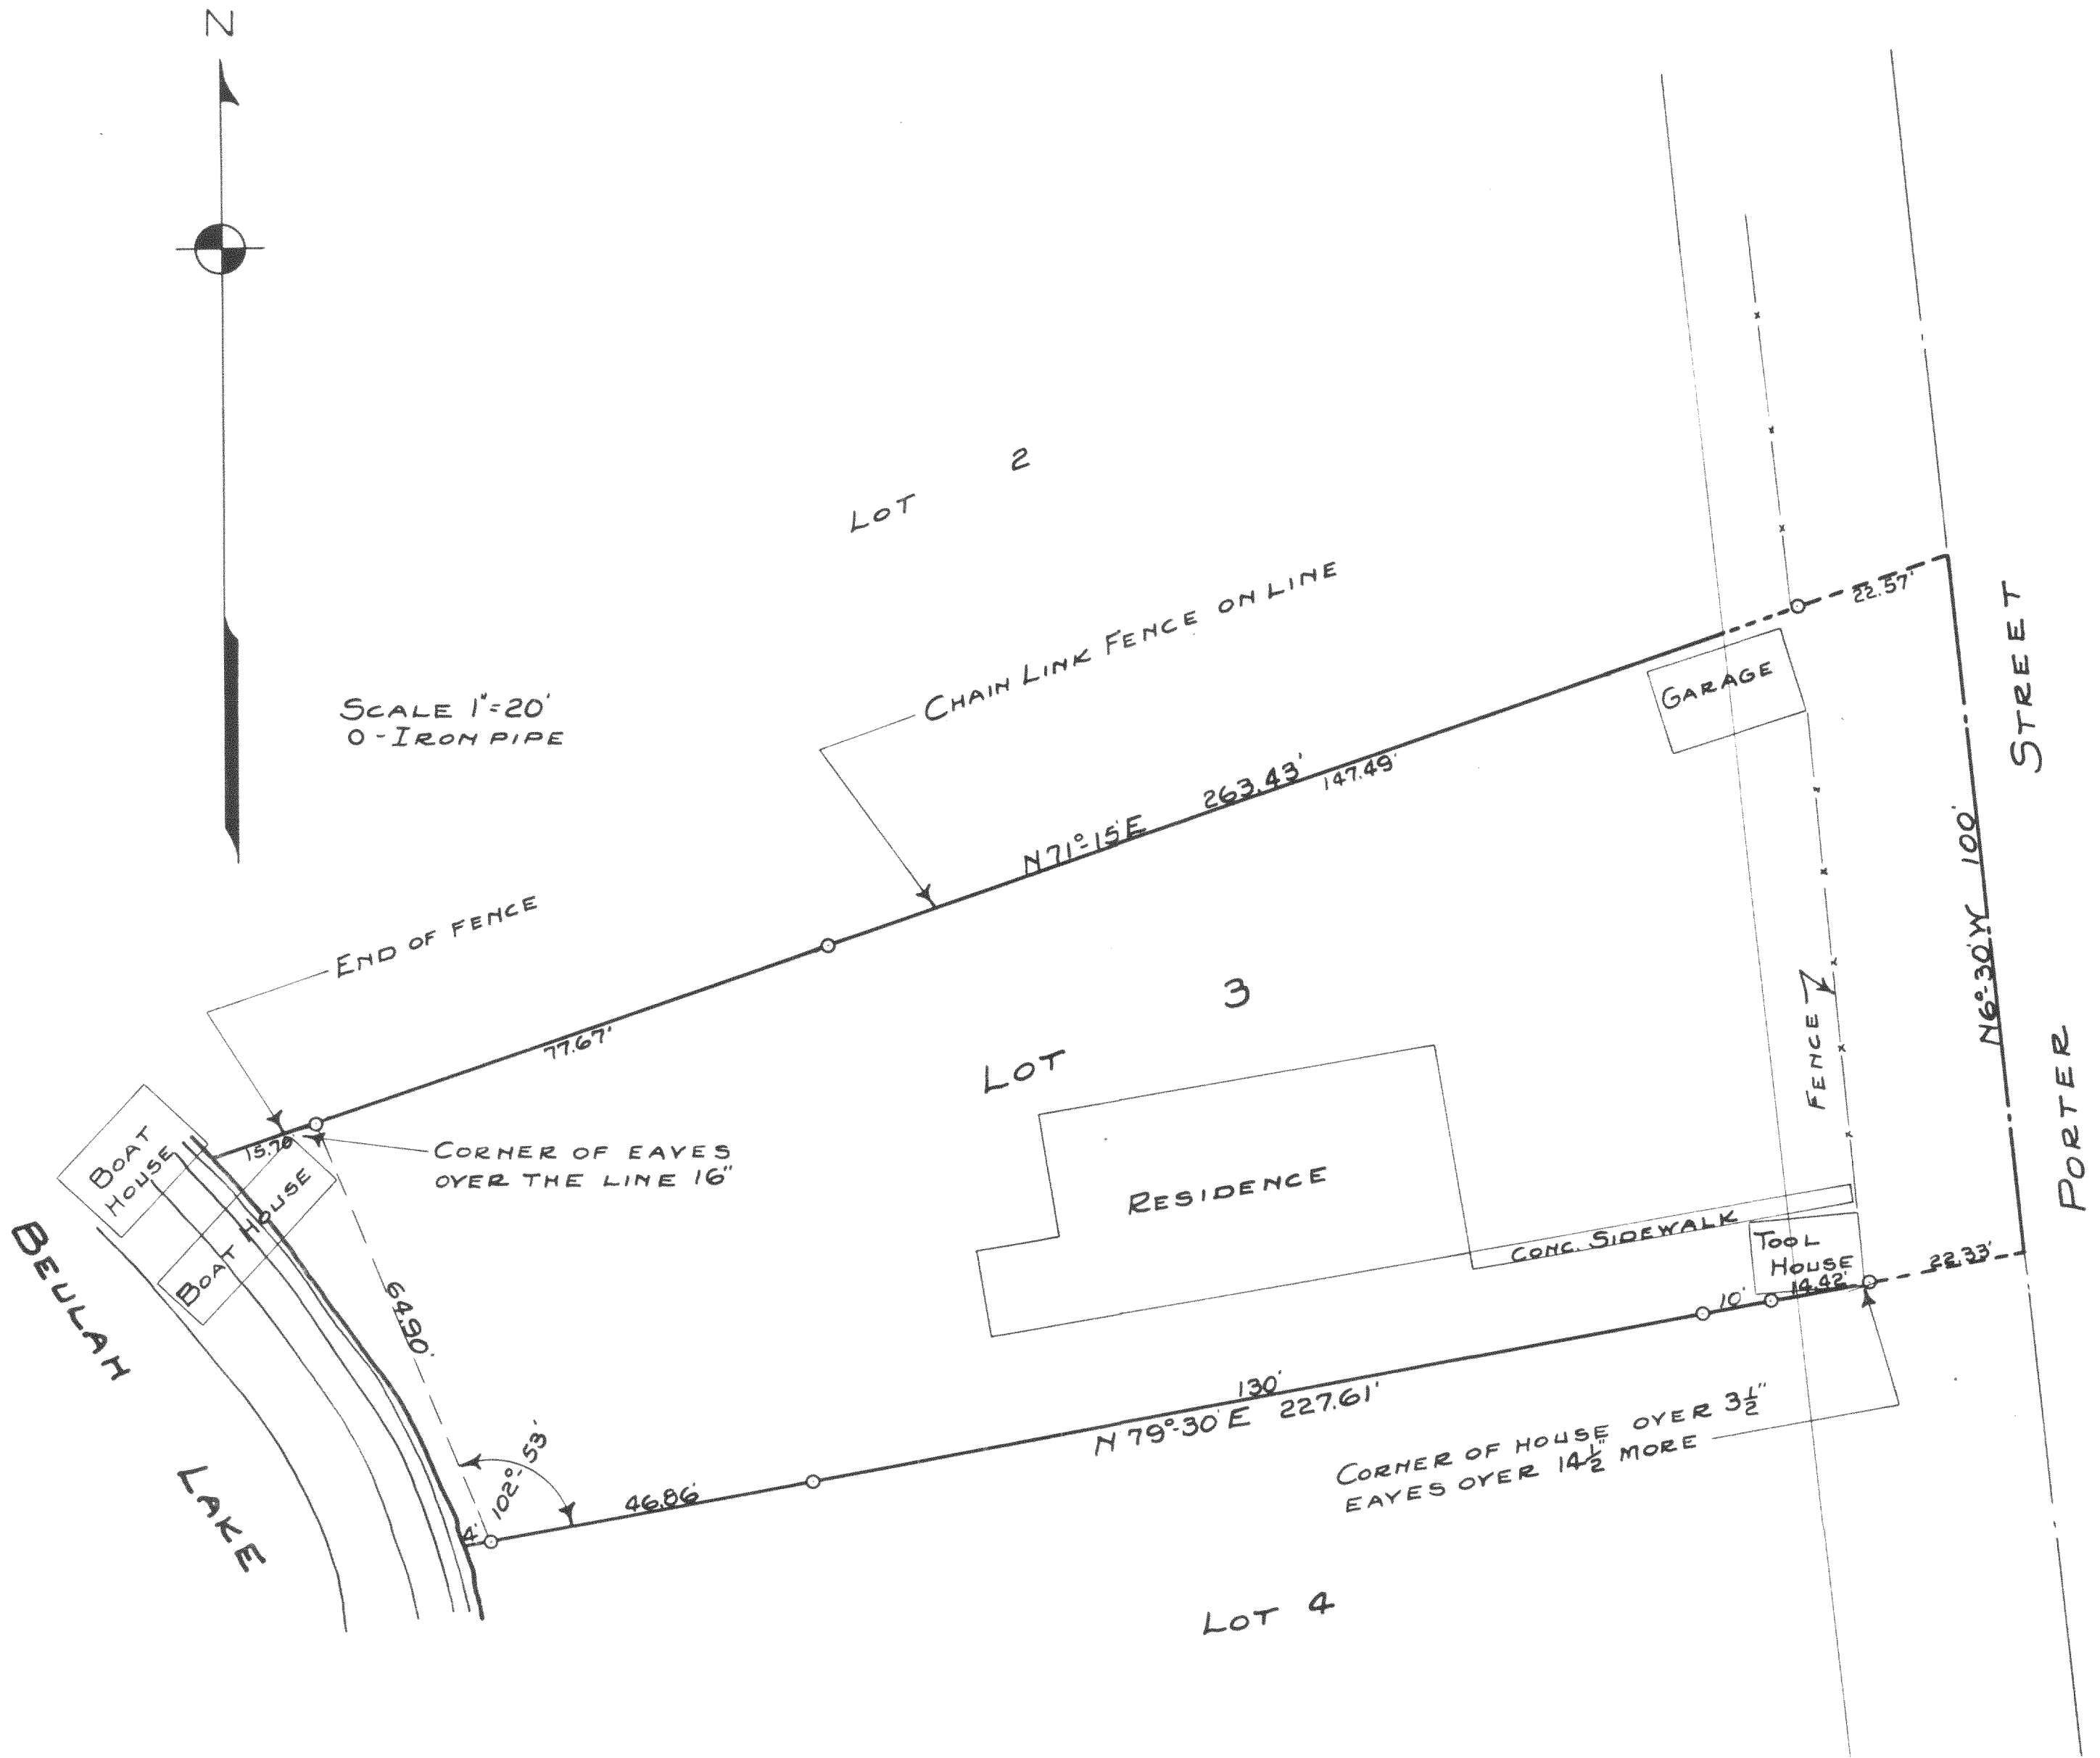

PLAT OF SURVEY OF LOT 3 OF BLOCK 2 OF FREE'S
 PARK, A SUBDIVISION LOCATED IN SECTION 4, T4N
 R18E OF WALWORTH COUNTY WISCONSIN.

NOV. 1943

Lloyd L. Jensen
 COUNTY SURVEYOR

418-23J