



PLAT OF SURVEY

LOT 34 OF BLOCK 1 IN WILMER GROVE BEACH SUBDIVISION AND LOT 8 OF DIVISION "A" OF WILMER GROVE BEACH SUBDIVISION, BEING LOCATED IN THE EAST ½ OF SECTION 18, TOWNSHIP 4 NORTH, RANGE 18 EAST, TOWN OF EAST TROY, WALWORTH COUNTY, WISCONSIN.

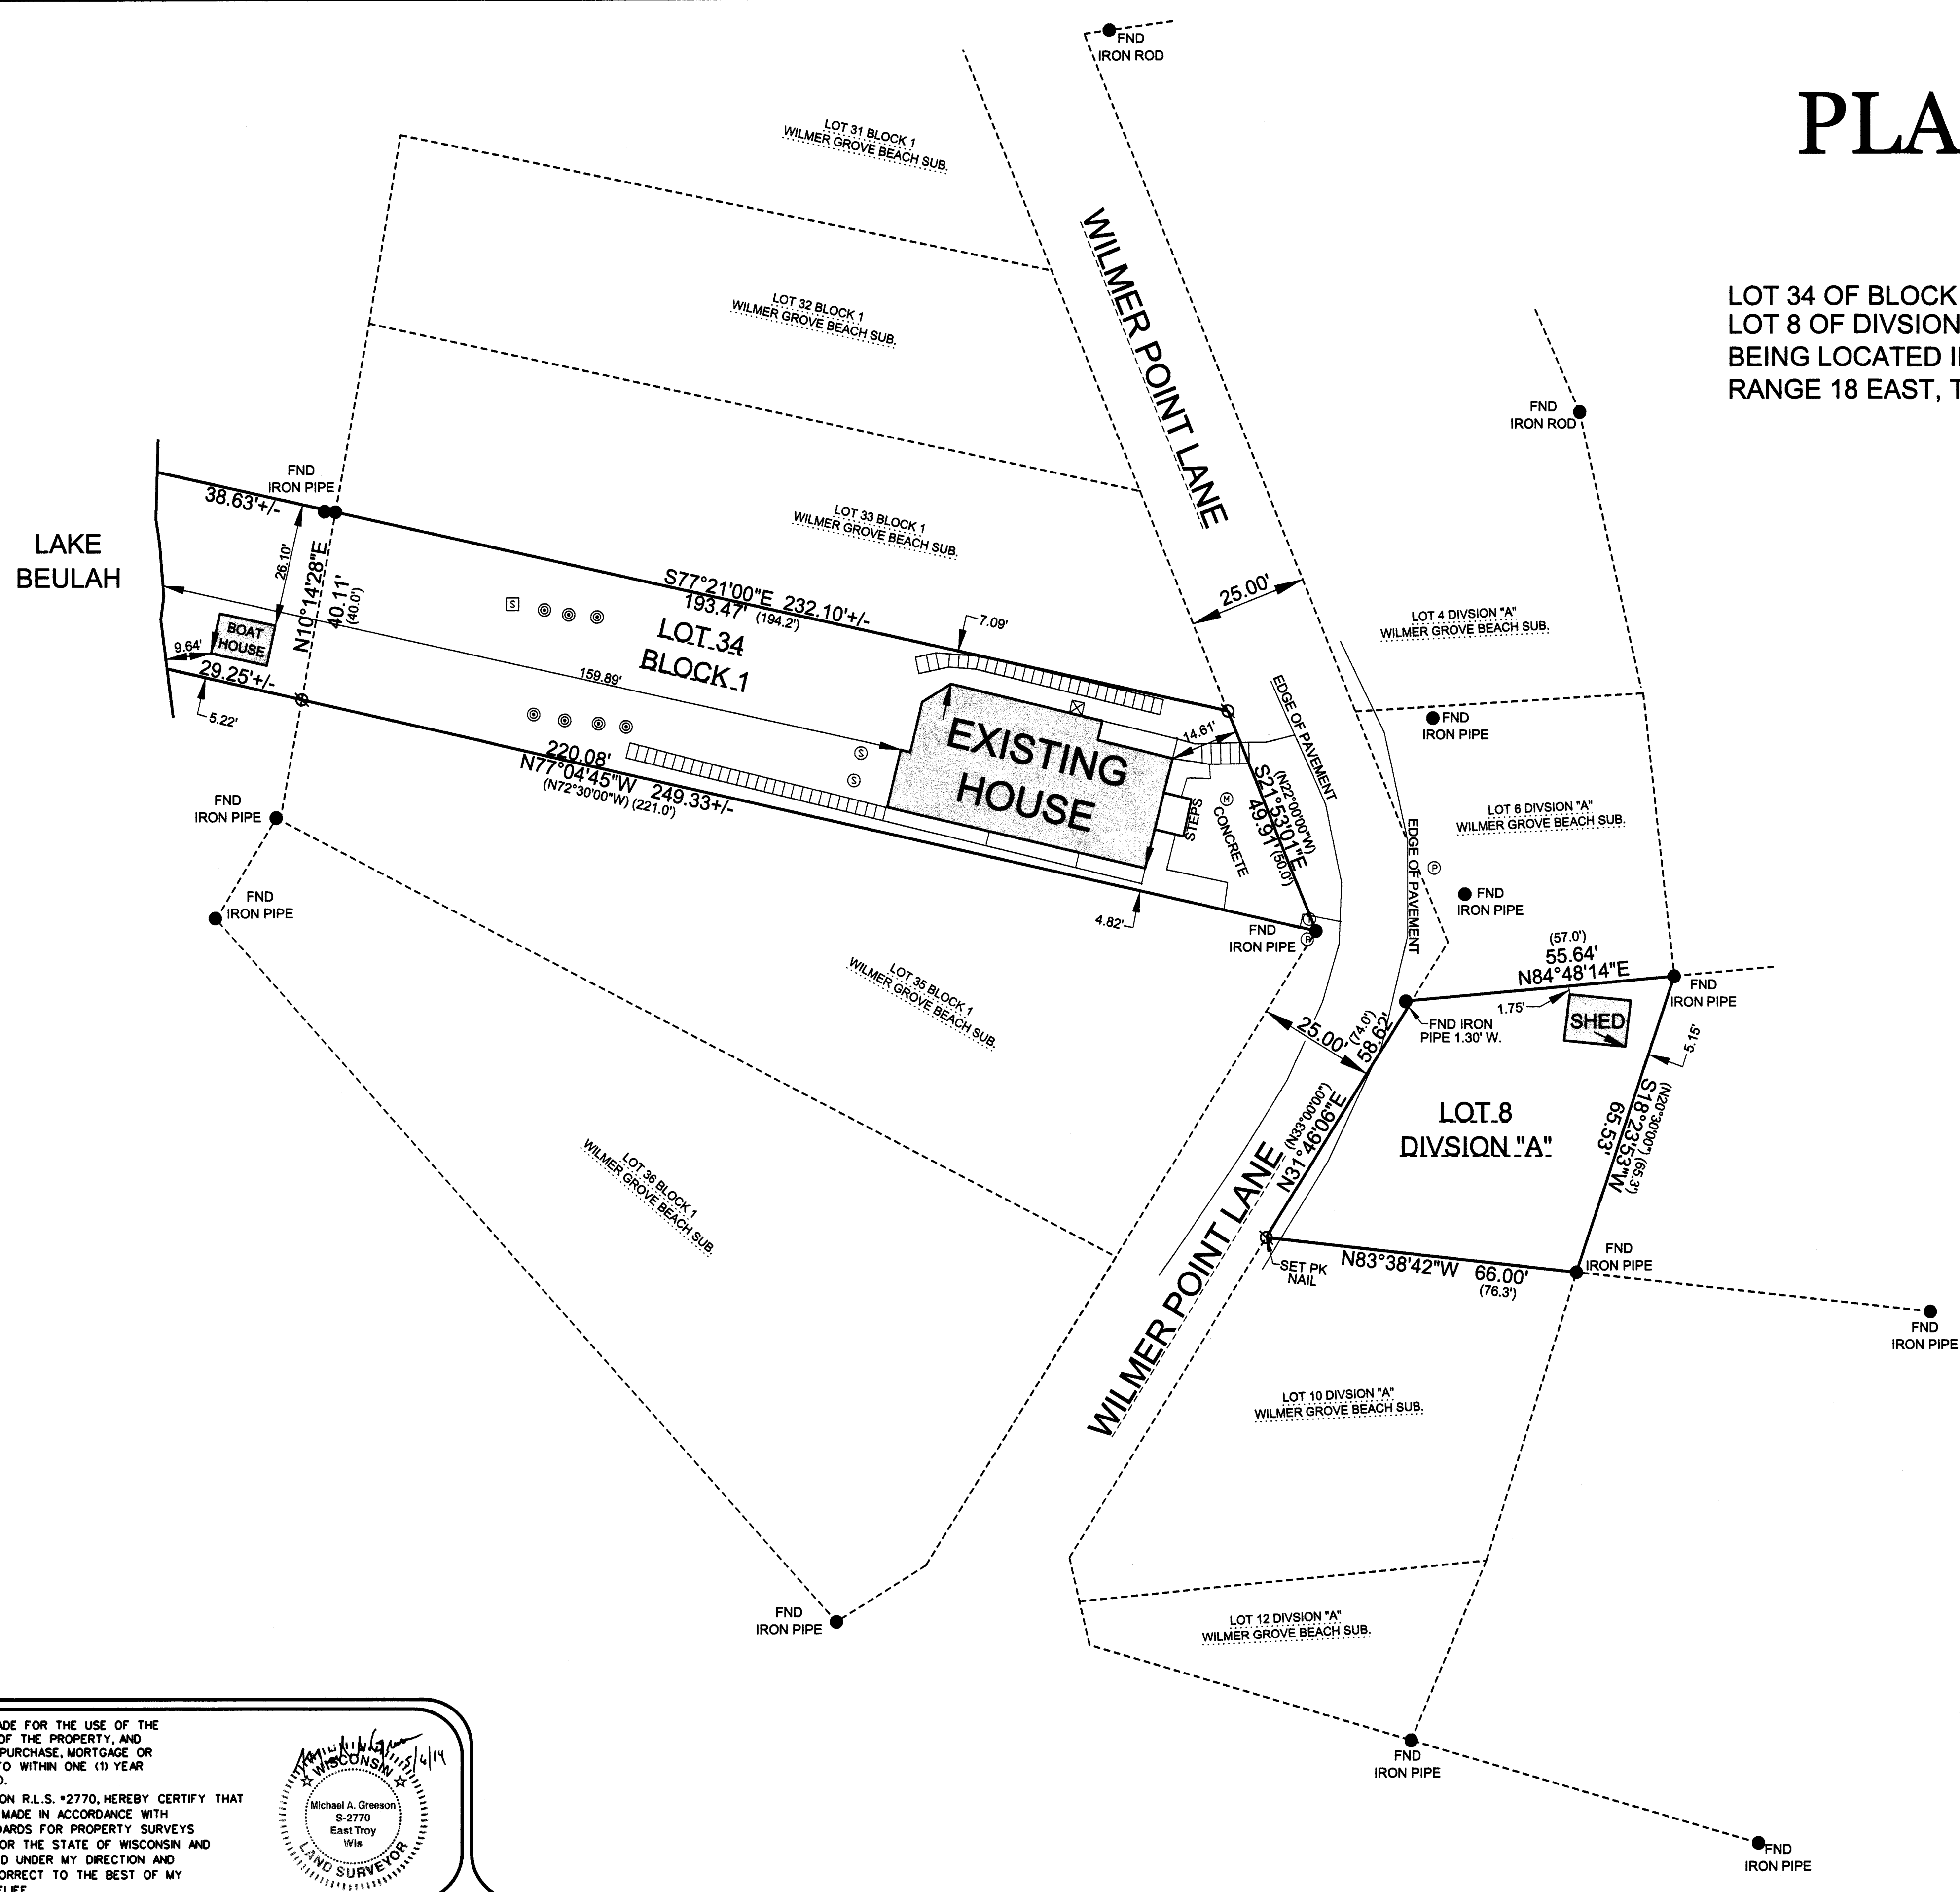

LEGEND:

(100.00')	RECORDED DISTANCE
100.00'	MEASURED DISTANCE
●	1" FOUND IRON PIPE, UNLESS NOTED
⊗	3/4" x 18" IRON PIPE SET, 1.13 lbs./l.f.
⊙	SEPTIC TANK
⊠	SEPTIC VENT
⊕	SEPTIC CLEAN OUT
⊖	MANHOLE
⊙	POWER POLE
⊖	PEDESTAL
⊗	AIR CONDITIONER

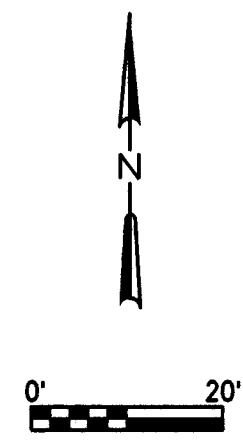


SURVEY DATE: 5/6/2014
SURVEY MADE FOR:
ALEXANDRA BERNARDI
N8776 WILMERS POINT LANE
EAST TROY, WI 53120

THIS SURVEY IS MADE FOR THE USE OF THE PRESENT OWNERS OF THE PROPERTY, AND ALSO THOSE WHO PURCHASE, MORTGAGE OR GUARANTEE TITLE TO WITHIN ONE (1) YEAR FROM DATE HERETO.

I, MICHAEL A. GREESON R.L.S. #2770, HEREBY CERTIFY THAT THIS SURVEY WAS MADE IN ACCORDANCE WITH THE MINIMUM STANDARDS FOR PROPERTY SURVEYS (CHAPTER A-E 7) FOR THE STATE OF WISCONSIN AND HAS BEEN PREPARED UNDER MY DIRECTION AND CONTROL AND IS CORRECT TO THE BEST OF MY KNOWLEDGE AND BELIEF.

V²G
SURVEYING, LLC
550 BAYVIEW ROAD SUITE B
WILKESBORO, NC 28696
(703) 378-1287

Michael A. Greeson
S-2770
East Troy
Wis
LAND SURVEYOR

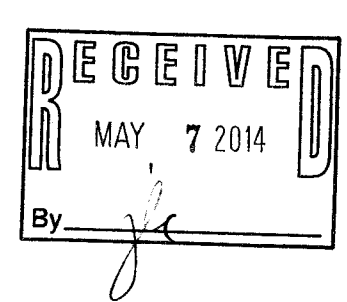

PwW -26B
PwW -48
418-2407