


Plat of Survey

Survey For: Linda Rose Zuemer

Location: #N8784 Stringers Bridge Road, Town of East Troy, Walworth County, Wisconsin

Description: The South line of Certified Survey Map No. 498 as recorded in the Walworth County Register of Deeds Office in Volume 2 of Certified Survey Maps on Pages 327 and 328, recorded as Document Number 693068. Being a part of the SE 1/4 of the NW 1/4 and the SW 1/4 of the NE 1/4 of Section 18, T4N, R18E, Town of East Troy, Walworth County, Wisconsin.

Subject to all rights, reservations, restrictive covenants, and easements recorded or unrecorded.

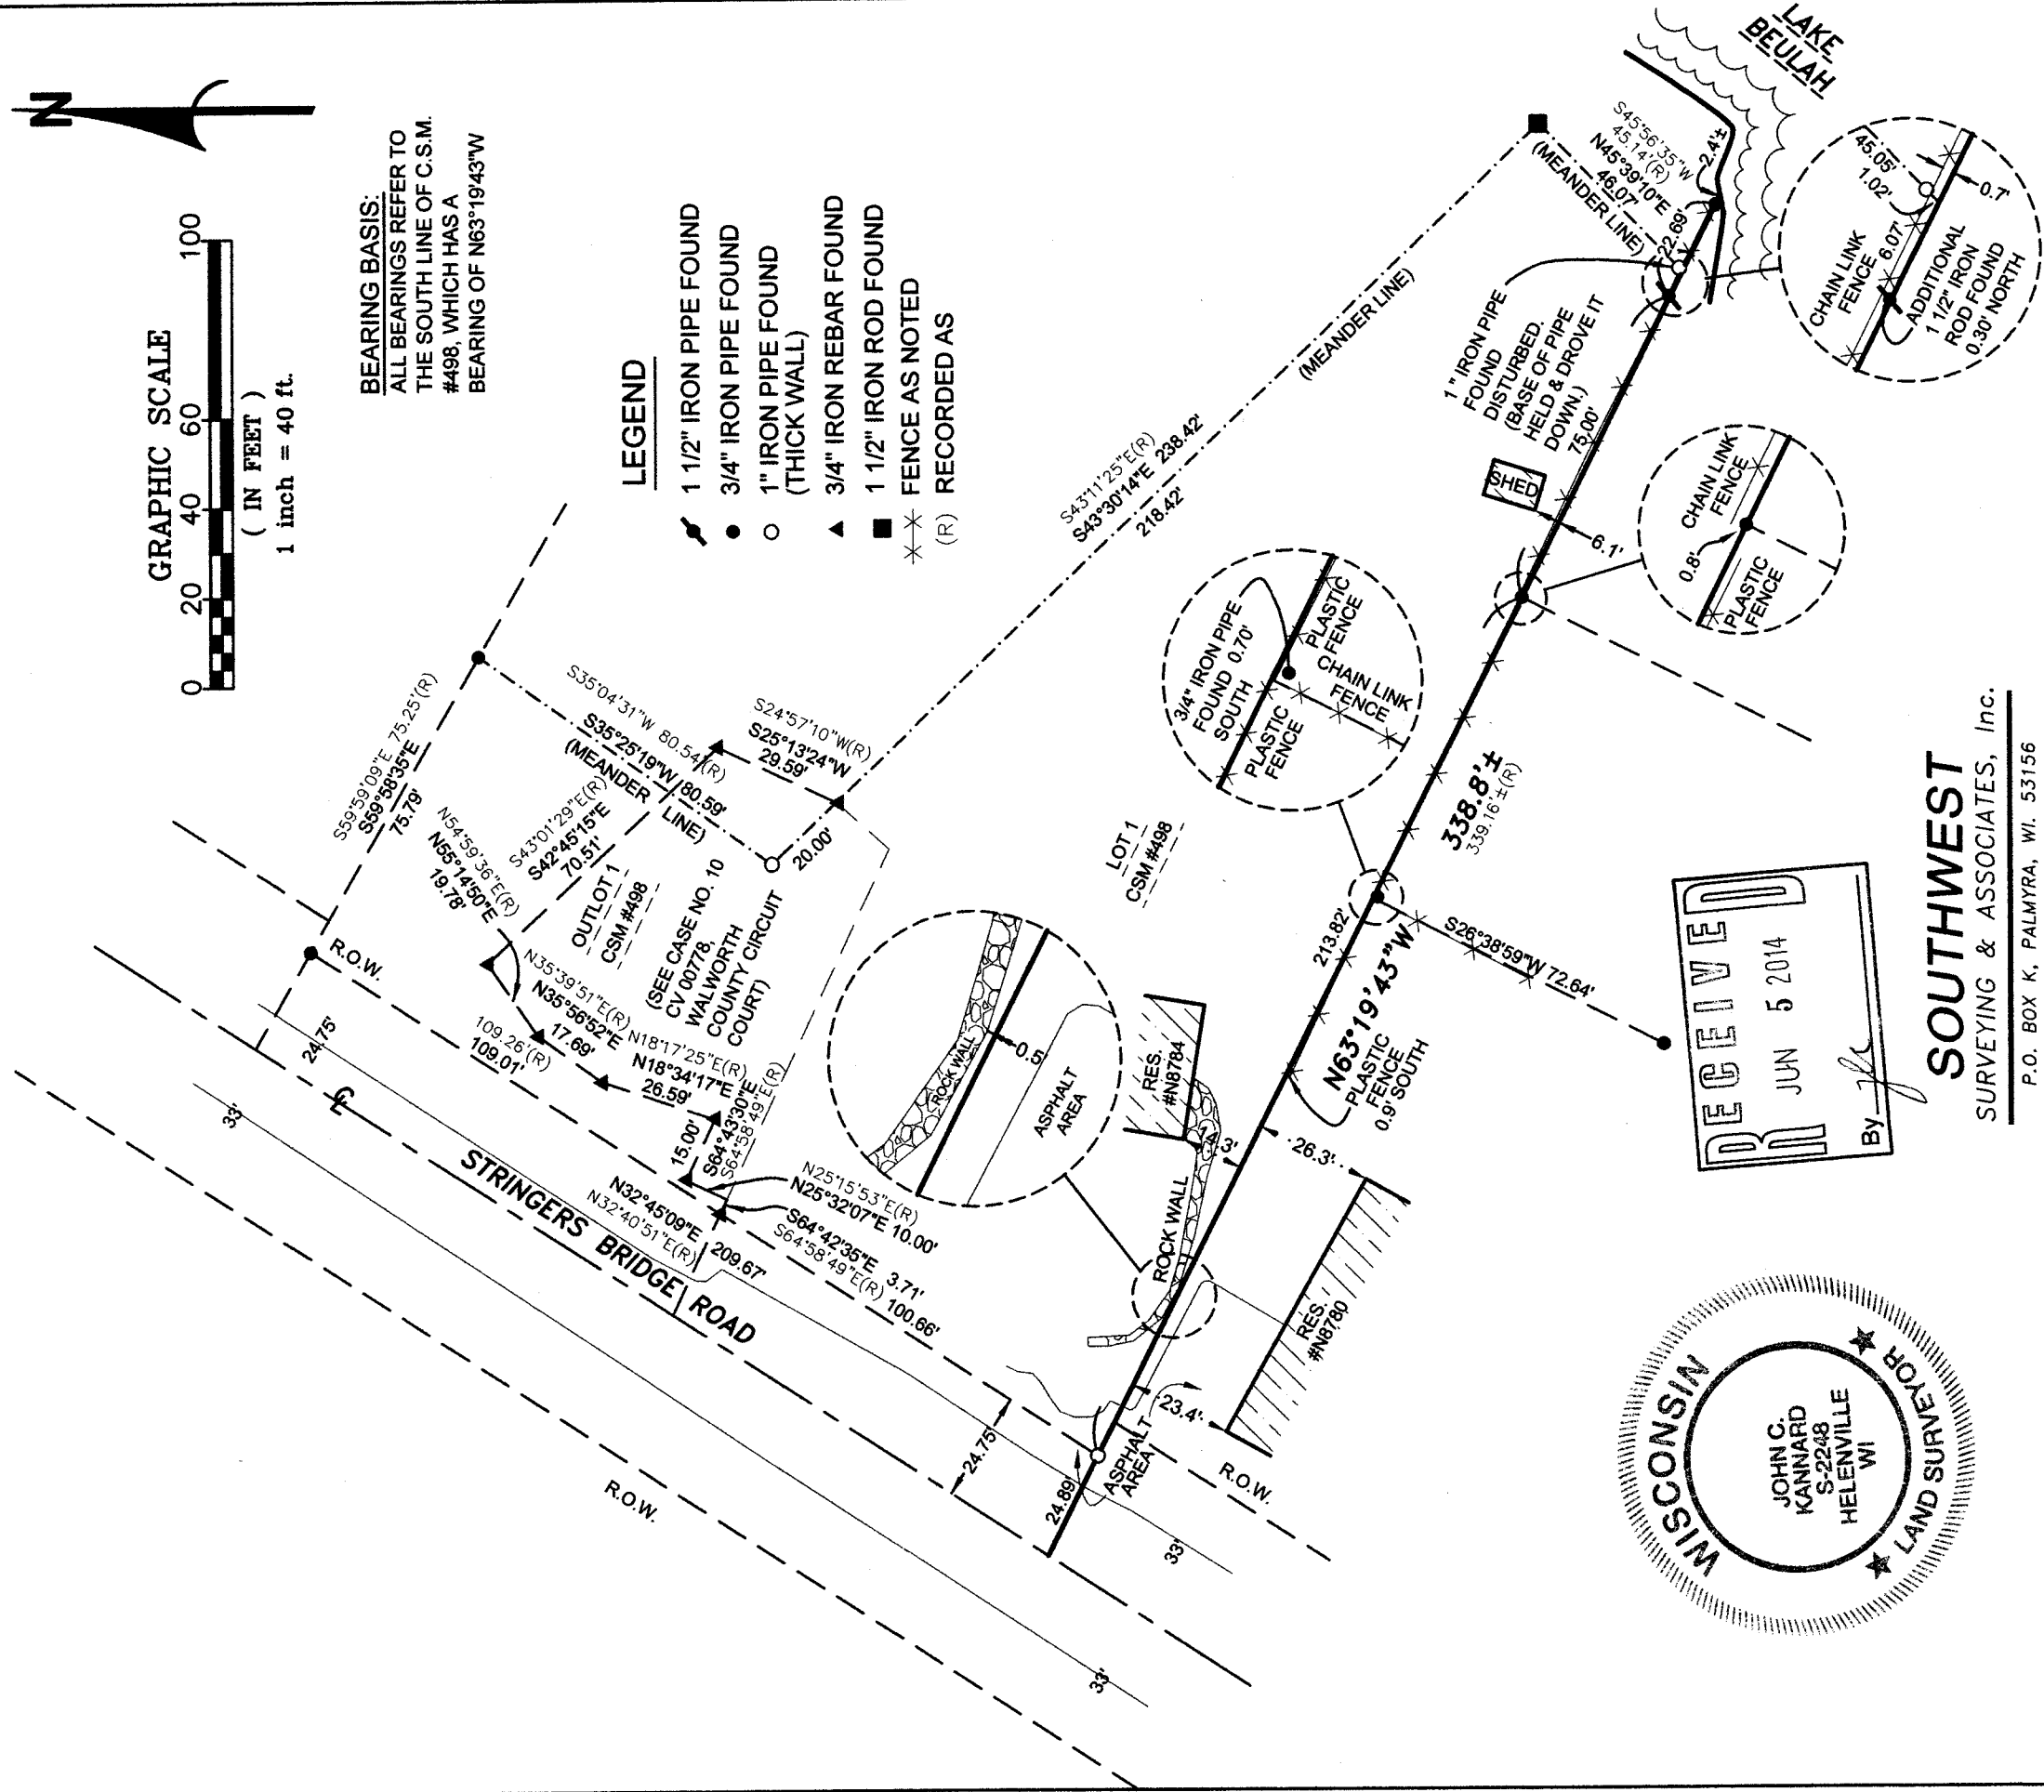

I, the undersigned, do hereby certify that I have surveyed the above described (property) and the above map is a true representation thereof and shows the size and location of the property, its exterior boundaries, fences, apparent easements and roadways and visible encroachments, if any to the best of my knowledge and belief.

THIS IS A JOHN C. KANNARD AUTHORIZED PRINT ONLY IF SIGNATURE APPEARS IN RED INK ON BLACK LINE PRINT.

JOHN C. KANNARD, Registered Land Surveyor

PA 498-1

418-2411

SHEET 1 OF 1
DATE: NOVEMBER 4, 2013
JOB NO: Z-213132