

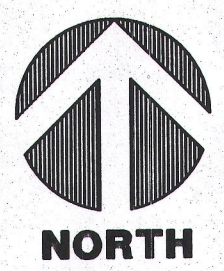


LEGAL DESCRIPTION:
LOT 4 OF CERTIFIED SURVEY MAP NO. _____
BEING A PART OF THE SOUTHWEST 1/4 AND THE SOUTHEAST 1/4
OF THE NORTHWEST 1/4 AND THE SOUTHWEST 1/4 OF THE
NORTHEAST 1/4 OF SECTION 13, TOWN 4 NORTH, RANGE 18 EAST,
IN THE TOWN OF EAST TROY, COUNTY OF WALWORTH, STATE OF
WISCONSIN.

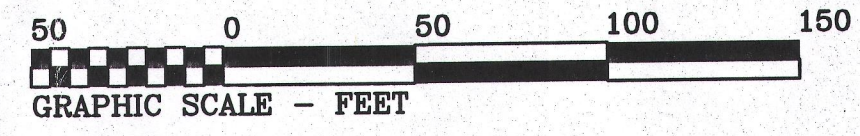

STATE OF WISCONSIN
COUNTY OF RACINE
The above-described property has been surveyed under my direction and
the above map is a correct representation thereof.
DATED AT: NORTH CAPE, THIS 21ST DAY OF OCTOBER, 2015.
Pete L. Bailey
AMERICAN SURVEYING COMPANY, INC.
PETE L. BAILEY, RLS NO. 1398
RECERTIFIED this _____ day of _____, 2015.

S 89°00'22"E 1396.01'

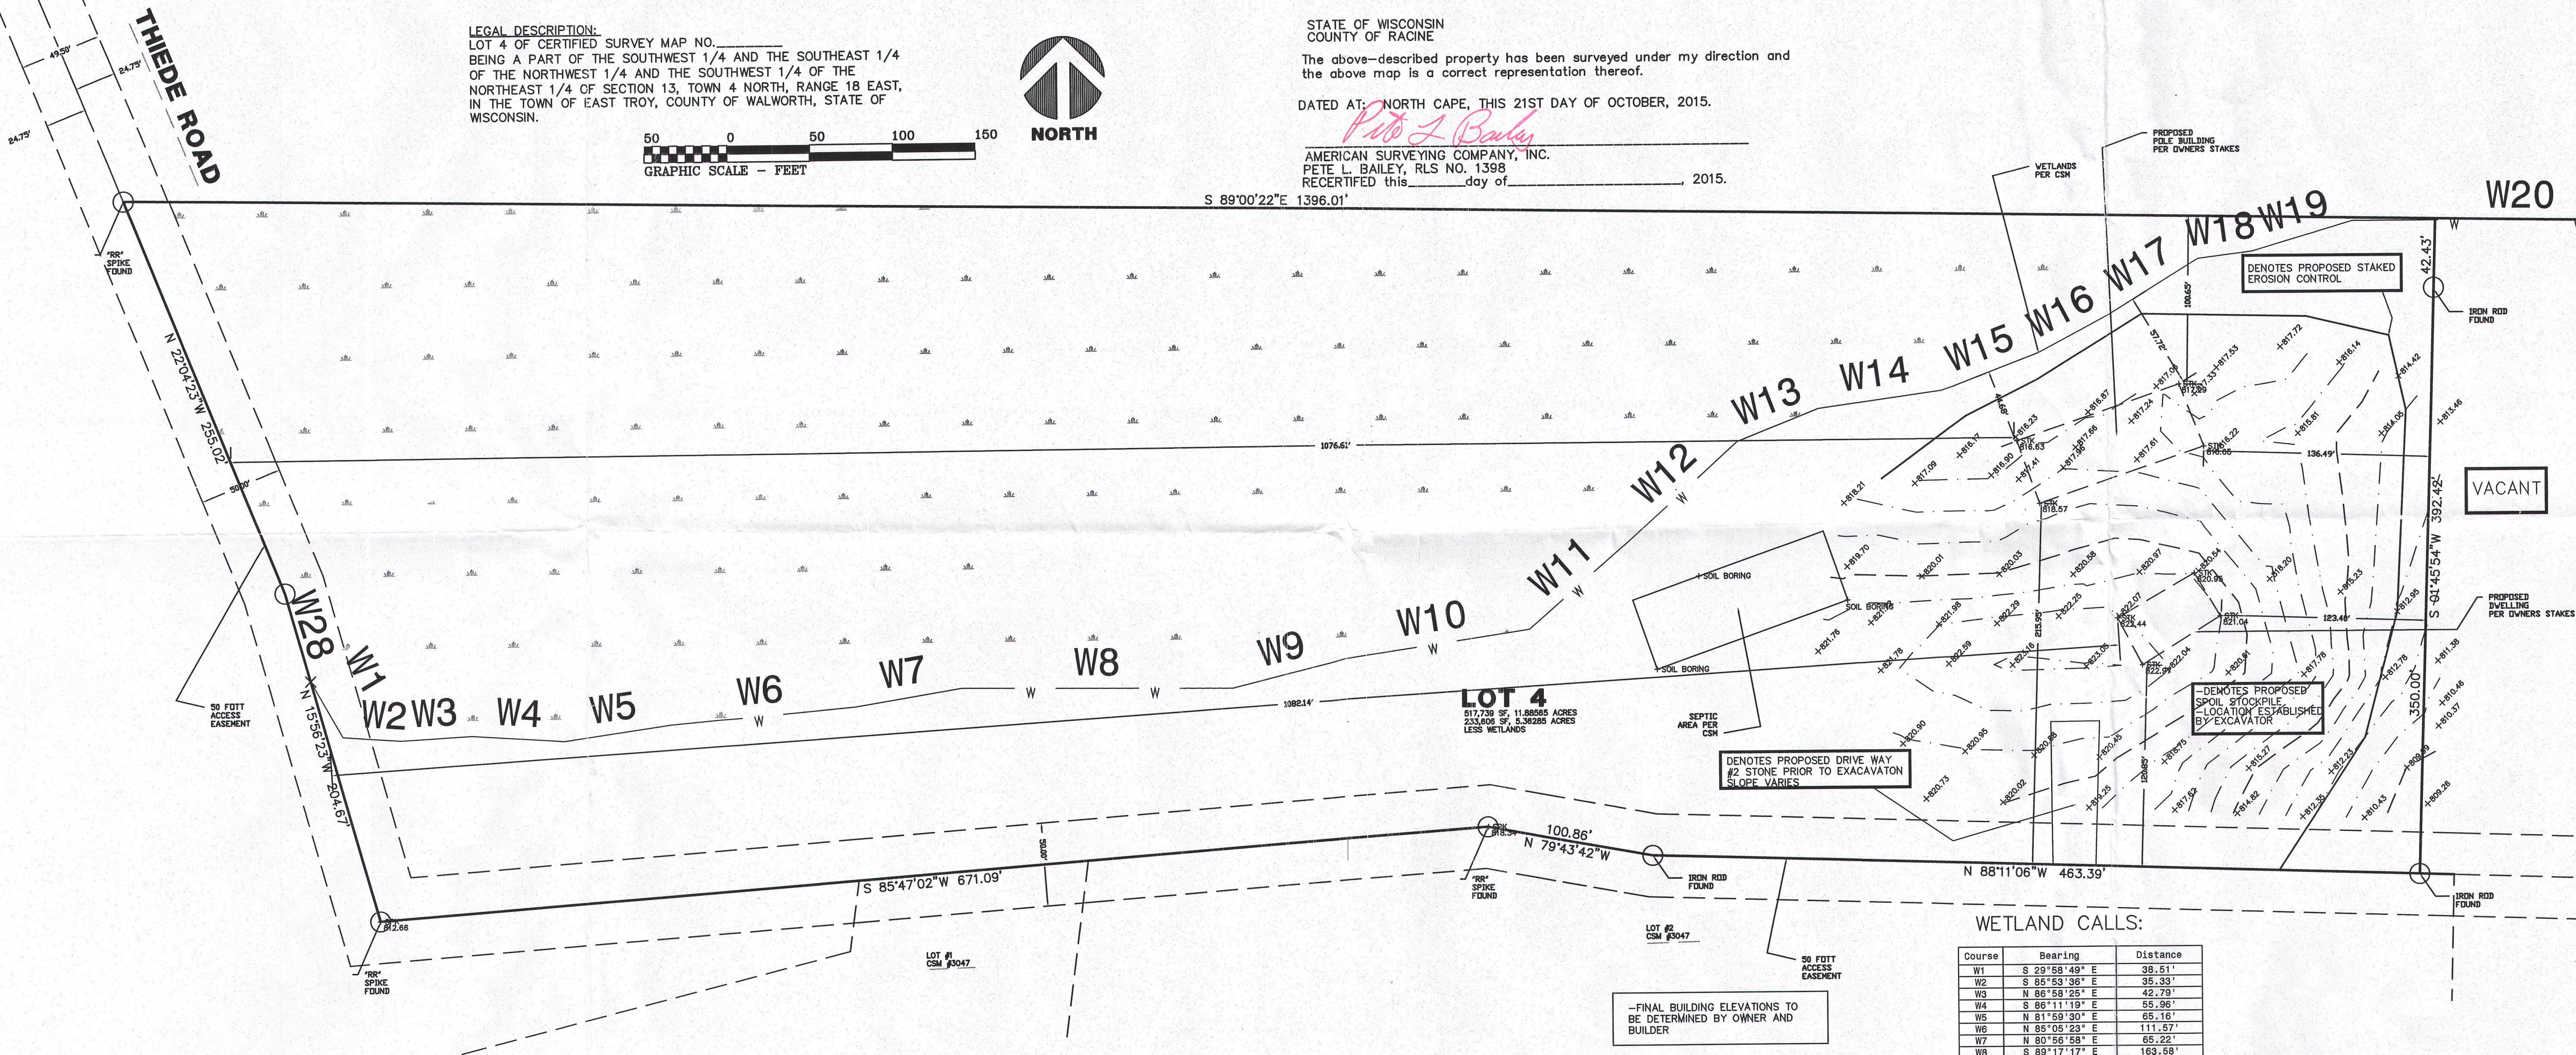

WETLAND CALLS:

Course	Bearing	Distance
W1	S 29°58'49" E	38.51'
W2	S 85°53'36" E	35.33'
W3	N 86°58'25" E	42.79'
W4	S 86°11'19" E	55.96'
W5	N 81°50'30" E	65.16'
W6	N 85°05'23" E	111.57'
W7	N 80°56'58" E	65.22'
W8	S 89°17'17" E	163.58'
W9	N 76°24'41" E	69.41'
W10	N 81°23'11" E	113.50'
W11	N 49°05'31" E	79.08'
W12	N 47°55'54" E	89.15'
W13	N 68°34'28" E	52.77'
W14	N 82°14'57" E	74.85'
W15	N 69°09'21" E	85.25'
W16	N 62°08'43" E	48.02'
W17	N 58°32'41" E	63.73'
W18	N 82°39'56" E	32.93'
W19	N 73°36'05" E	63.13'
W20	S 89°20'34" E	203.94'
W21	S 88°06'50" E	340.01'
W22	S 69°33'28" E	76.08'
W23	N 89°00'34" E	64.30'
W24	S 38°24'59" E	67.41'
W25	N 17°49'15" E	33.67'
W26	N 89°50'48" E	25.00'
W27	N 46°32'34" E	68.20'
W28	S 15°56'23" E	54.78'

