

PLAT OF SURVEY


August 5, 2015

Survey No. 150056R
Trustway Homes


LOCATION: _____ Troy Hill Court, East Troy, Wisconsin

LEGAL DESCRIPTION:


LOT 16, TROY HILL ESTATES, being the part of the Northwest 1/4, Northeast 1/4, Southwest 1/4, and Southeast 1/4 of the Southwest 1/4 of section 30, Town 4 North, Range 18 East, in the Town of East Troy, Walworth County, Wisconsin.

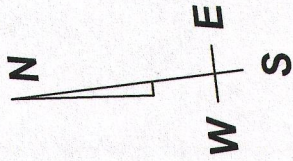

SETBACK REQUIREMENTS:
FRONT YARD: 58.62'
REAR YARD: 40'
SIDE YARD: 15'

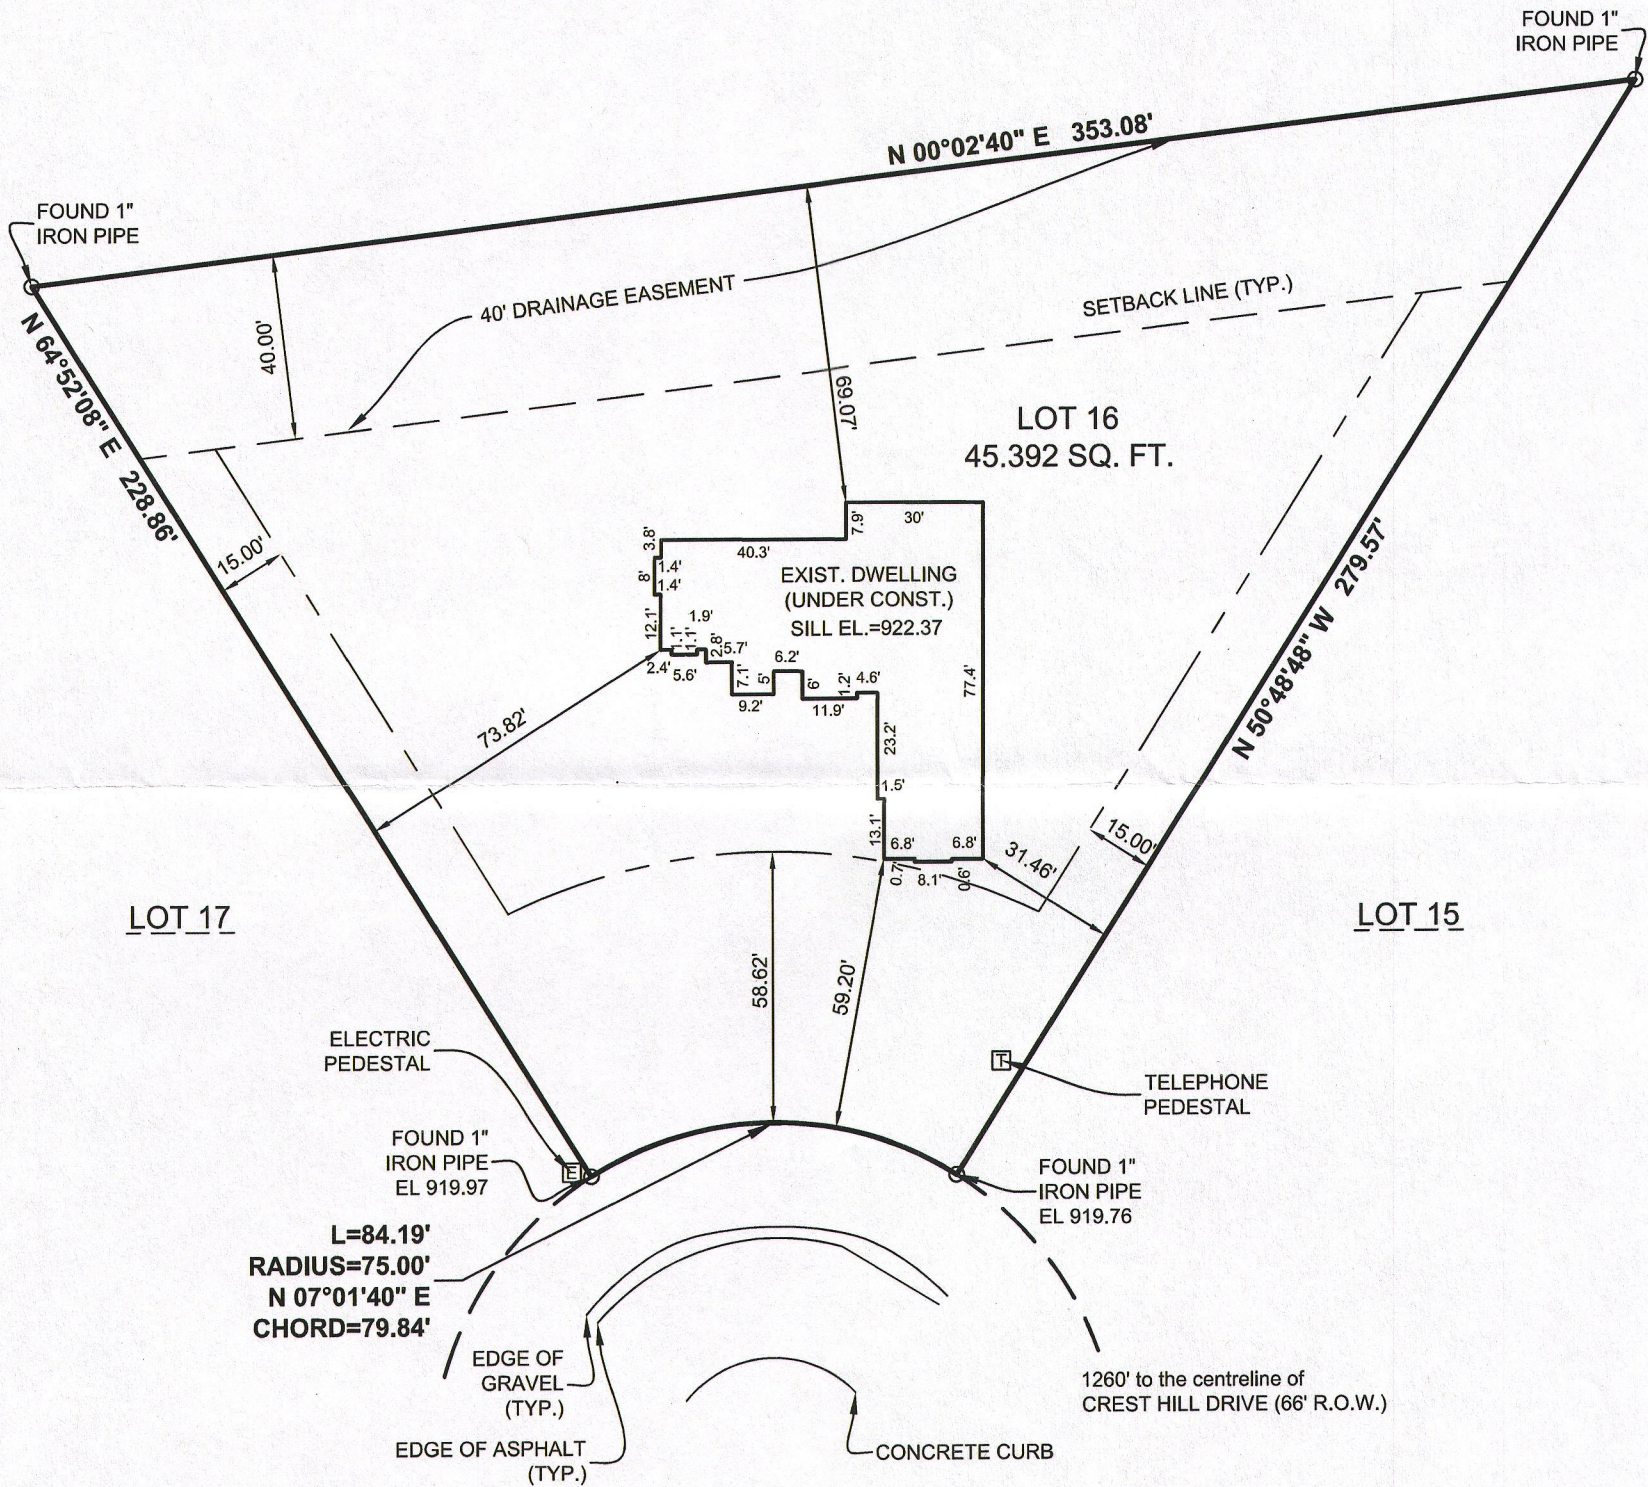


GRAPHIC SCALE

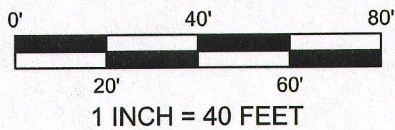


TROY HILL COURT

(66' R.O.W.)

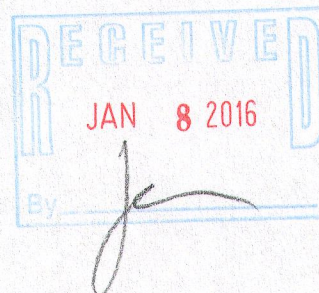

DRAWING BY: OV
FIELD WORK BY: DHS

DAAR
ENGINEERING, INC.
ENGINEERS PLANNERS SURVEYORS
518 West Cherry Street, Milwaukee, WI 53212
PHONE (414) 604-0674 FAX (414) 604-0677
www.daarcorp.com

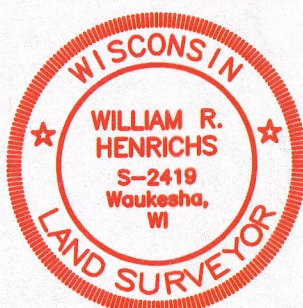

I HEREBY CERTIFY THAT I HAVE SURVEYED THE ABOVE DESCRIBED PROPERTY AND THAT THE ABOVE MAP IS A TRUE REPRESENTATION THEREOF AND SHOWS THE SIZE AND LOCATION OF THE PROPERTY, ITS EXTERIOR BOUNDARIES, THE LOCATION OF ALL VISIBLE STRUCTURES AND DIMENSIONS OF ALL PRINCIPAL BUILDINGS THEREON, BOUNDARY FENCES, APPARENT EASEMENTS AND ROADWAYS AND VISIBLE ENCROACHMENT, IF ANY.

THIS SURVEY IS MADE FOR THE EXCLUSIVE USE OF THE PRESENT OWNERS OF THE PROPERTY, AND ALSO THOSE WHO PURCHASE, MORTGAGE, OR GUARANTEE THE TITLE THERETO WITHIN ONE (1) YEAR FROM THE DATE HEREOF.

SIGNED William R. Henrichs
William R. Henrichs, Professional Land Surveyor S-2419