


PLAT OF SURVEY -OF-

LOT 4 OF DUTCHLAND ACRES, A SUBDIVISION
LOCATED IN THE NORTHEAST 1/4 OF SECTION 21,
TOWNSHIP 4 NORTH, RANGE 18 EAST OF THE
FOURTH PRINCIPAL MERIDIAN, IN THE TOWNSHIP
OF EAST TROY, COUNTY OF WALWORTH AND
STATE OF WISCONSIN.

SURVEY FOR: GRESL LIVING TRUST
SURVEY LOCATION: N8357-59 GREENWALD COURT

NOTE: BEARINGS HEREON RELATE TO THE NORTH LINE
OF LOT 4 OF DUTCHLAND ACRES, ASSUMED BEARING
NORTH 88°58'40" EAST.

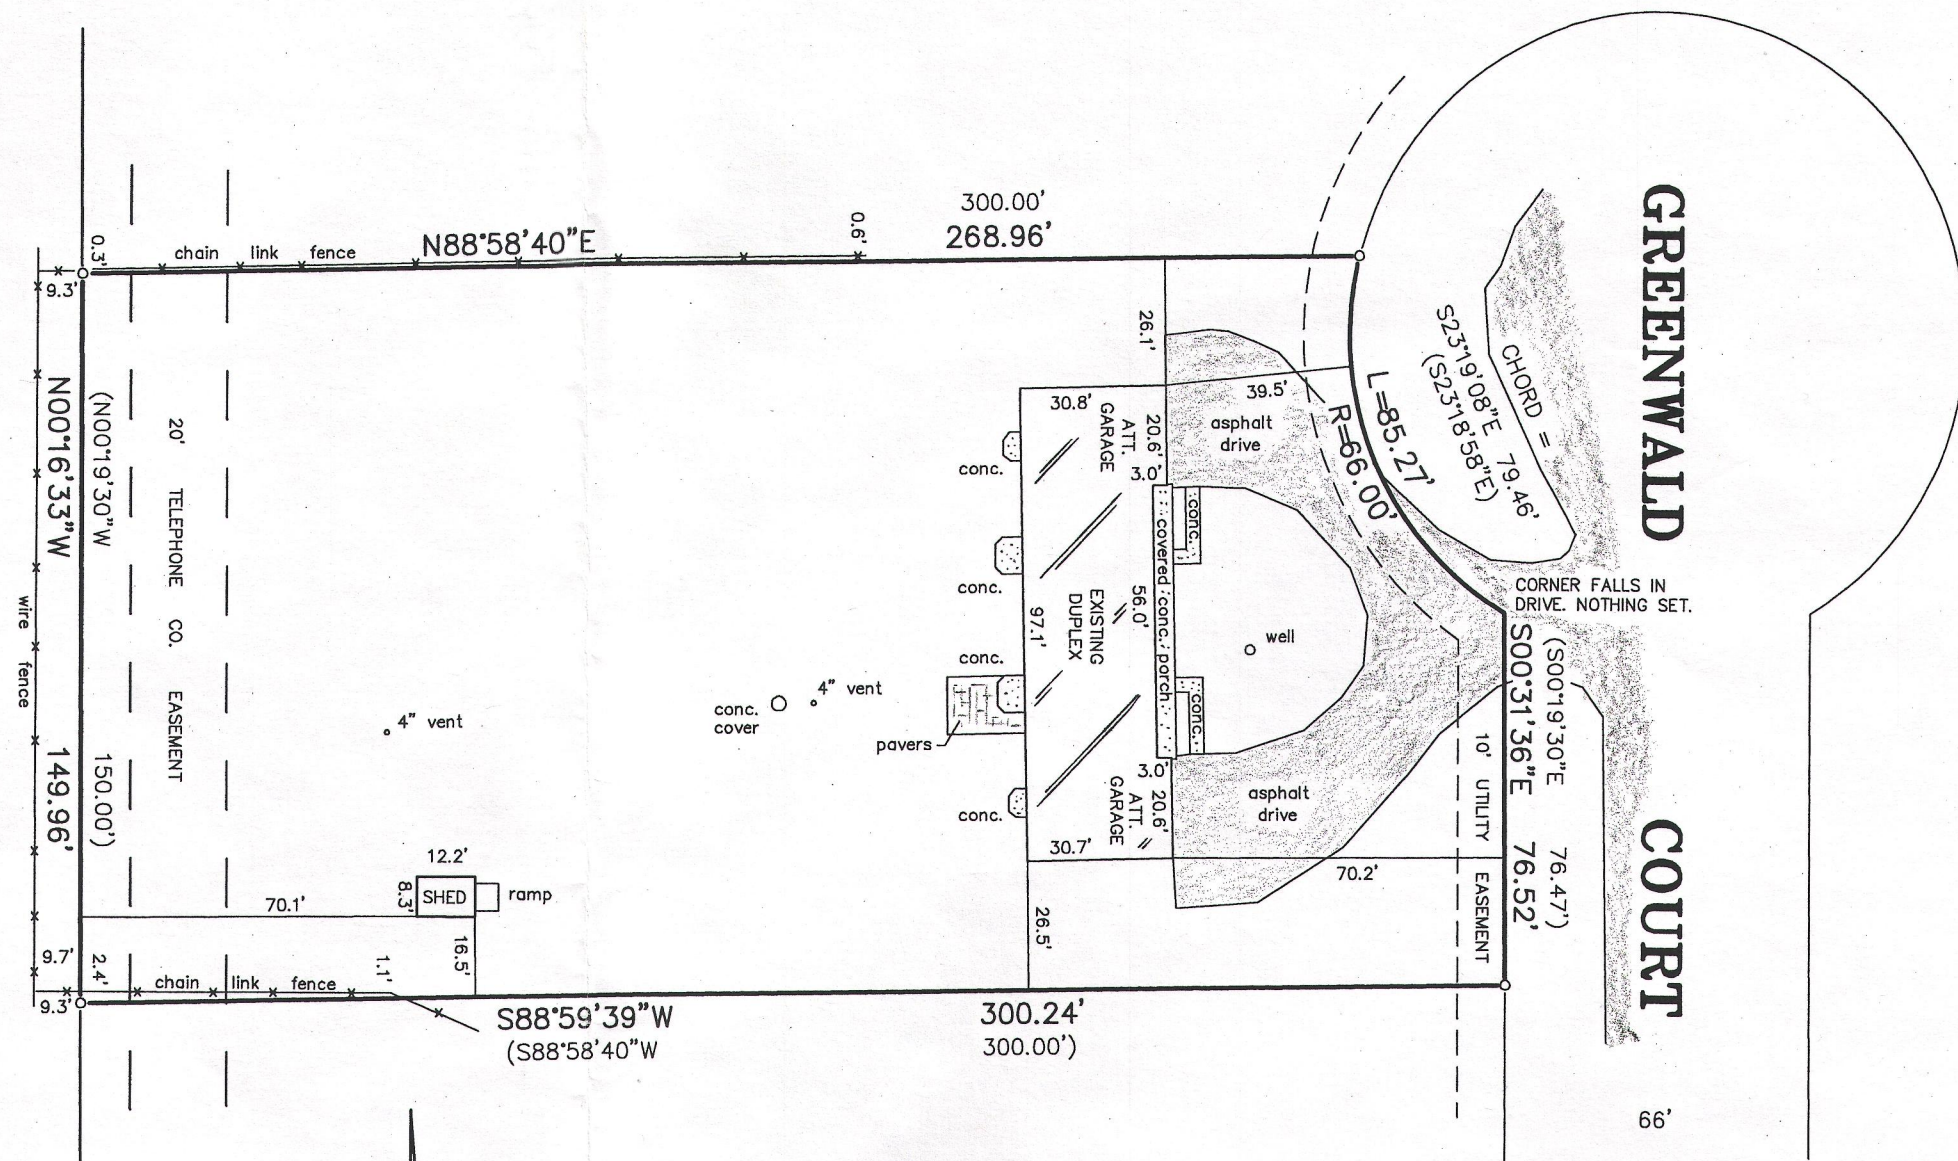

"I hereby certify that I have surveyed the above described
property and that the above map is a correct representation thereof
and shows the size and location of the property, its exterior
boundaries, the location of all visible structures and dimensions
of all principal buildings thereon, boundary fences, apparent
easements, roadways and encroachments, if any."

"This survey is made for the use of the present owners of the
property, and those who purchase, mortgage, or guarantee the
title thereto within one year from date hereof."



SCALE:

1" = 40'

LEGEND

- FOUND IRON PIPE
- SET IRON PIPE
- () RECORDED AS

GRAPHIC SCALE

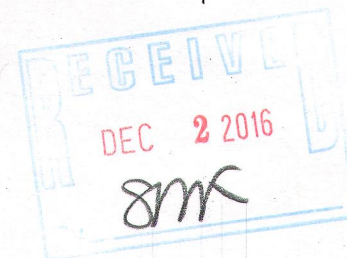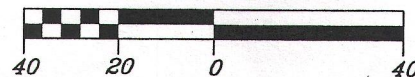


THIS IS NOT AN ORIGINAL PRINT
UNLESS THIS SEAL IS RED.

Robert J. Wetzel
ROBERT J. WETZEL S-1778

MARCH 7, 2016
DATE

9069
JOB NUMBER

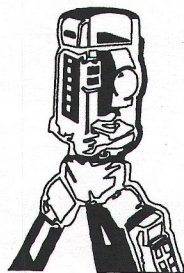

B.W. SURVEYING, INC.

LAND SURVEYS
MAPPING AND PLANNING
412 N. PINE STREET
BURLINGTON, WI 53105
(262)-767-0225

PD-4

418-2529