


PLAT OF SURVEY

LOT 31, BLOCK 1 WILMER GROVE BEACH

A subdivision located in the Northeast 1/4 of Section 18,
Town 4 North, Range 18 East, Town of East Troy,
Walworth County, Wisconsin.

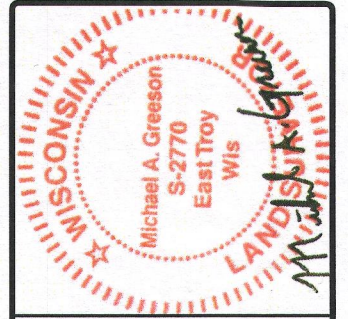


THIS SURVEY IS MADE FOR THE USE OF THE PRESENT OWNERS
OF THE PROPERTY, AND ALSO THOSE WHO PURCHASE, MORTGAGE
OR GUARANTEE TITLE TO WITHIN ONE (1) YEAR FROM DATE HERETO.

I, MICHAEL A. GREESON R.L.S. #2770, HEREBY CERTIFY THAT THIS
SURVEY WAS MADE IN ACCORDANCE WITH THE MINIMUM STANDARDS
FOR PROPERTY SURVEYS (CHAPTER A-E 7) FOR THE STATE OF WISCONSIN
AND HAS BEEN PREPARED UNDER MY DIRECTION AND CONTROL AND IS
CORRECT TO THE BEST OF MY KNOWLEDGE AND BELIEF.

SURVEY DATE: 07/13/2016

SURVEY MADE FOR:

Thomas Schurer
1226 Spruce Drive
Glenview, Illinois 60025

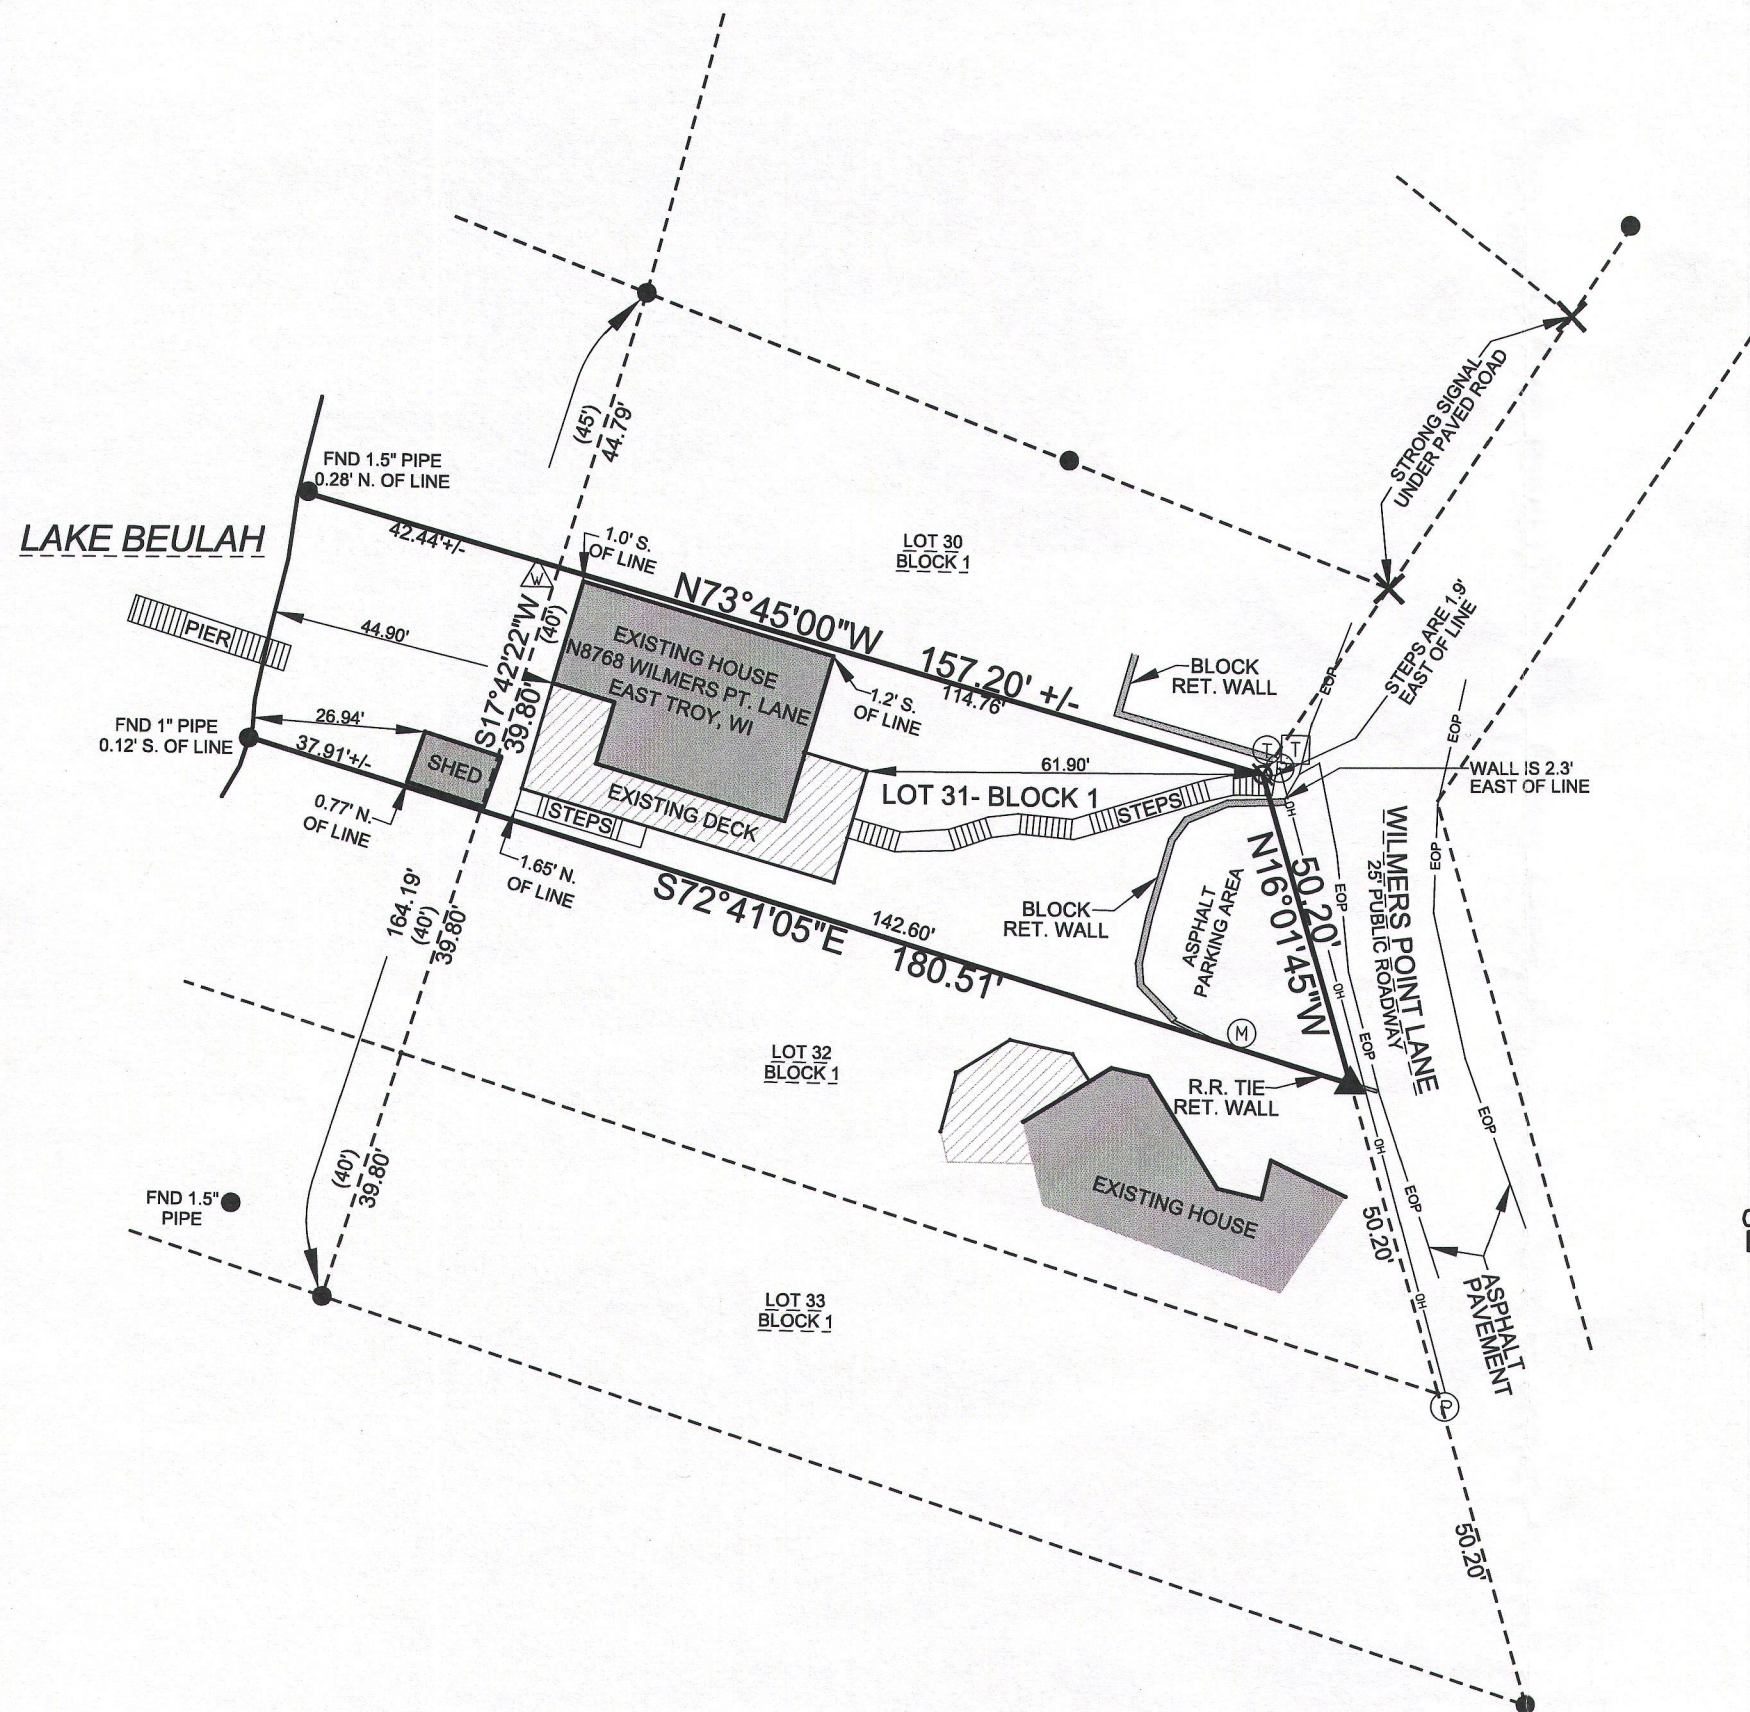

LEGEND:

(100.00') RECORDED DISTANCE

100.00' MEASURED DISTANCE

● 1" FOUND IRON PIPE,
UNLESS NOTED

Ø 3/4" x 18" IRON PIPE SET,
1.13 lbs./L.F.

Ⓟ POWER POLE

 WELL

(M) MANHOLE COVER

T TELEPHONE PEDESTAL

⑦ CABLE TV BOX

0' 30'
SCALE 1" = 30'

RESERVE
DEC 18 2016
SMF

PLOT DATE: 7/6/2016 - REV. 7/13/2016

V2G JOB#: 2016-049

PWN-25

418-2538