

Plat Of Survey

Property Address: N9281 Rhonda Circle, Mukwonago, Wisconsin

Property Description: Parcel 2, CERTIFIED SURVEY MAP NO. 189, being a part of the Northeast 1/4 of Section 10, Township 4 North, Range 18 East, Town of East Troy, Walworth County, Wisconsin.




October 16, 2017

Survey No. 17119

Prepared For:
Steven Fredrick

Legend

- = Found Iron Pipe
- AC = Air Conditioner Unit
- W = Well
- S = Septic Tank
- V = Septic Vent
- ⊕ = Power Pole
- = Overhead Wires

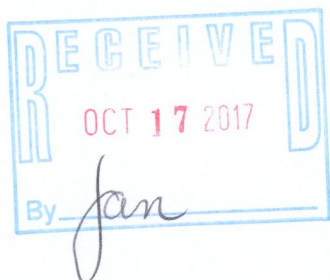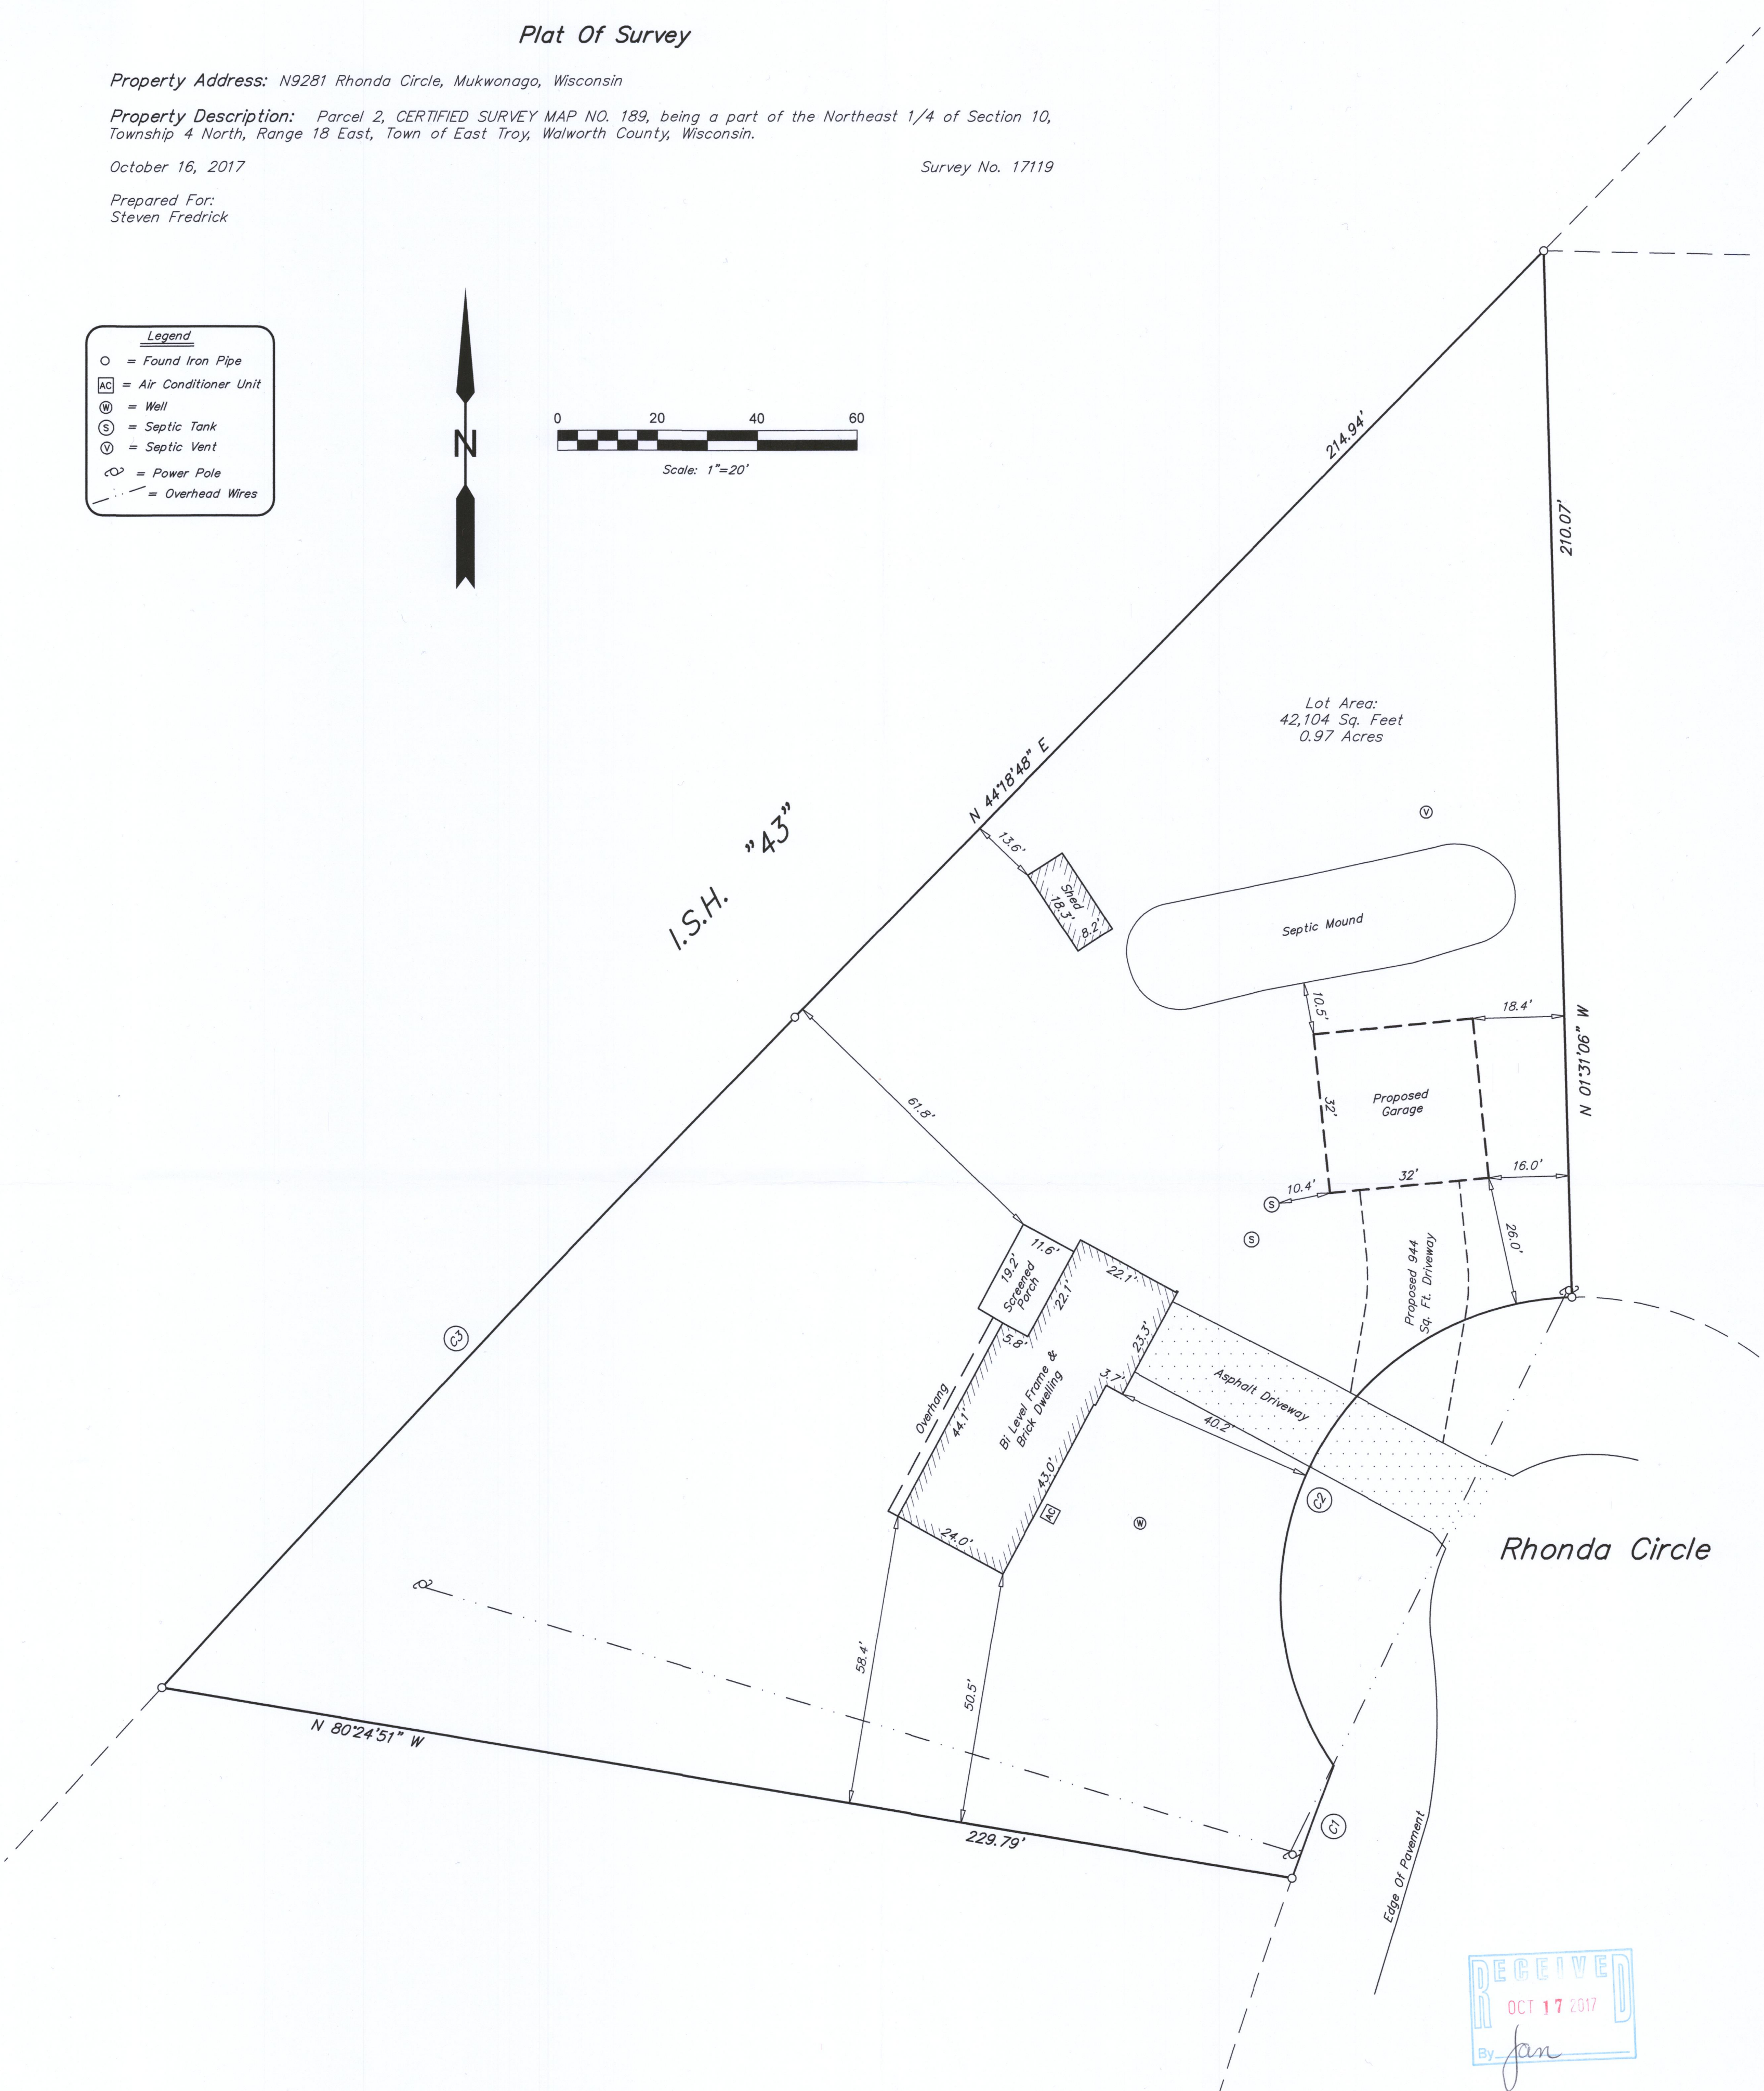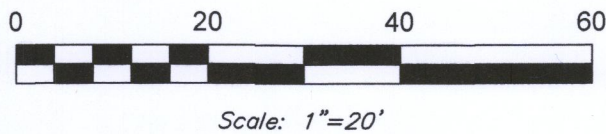

Southeast Survey LLC
Professional Land Surveyors
W207 S8240 Hillendale Drive
Muskego, WI 53150
Phone: 414-429-4862
Email: Mike@surveyse.com
Website: surveyse.com

Curve Table				
Curve	Radius	Arc Length	Chord Length	Chord Bearing
C1	1266.00'	23.99'	23.99'	N 20°19'47" E
C2	60.00'	128.91'	105.51'	N 26°55'49" E
C3	5539.58'	184.99'	184.98'	N 43°21'24" E



I HEREBY CERTIFY THAT I HAVE SURVEYED THE ABOVE DESCRIBED PROPERTY AND THAT THE ABOVE MAP IS A TRUE REPRESENTATION THEREOF AND SHOWS THE SIZE AND LOCATION OF THE PROPERTY, ITS EXTERIOR BOUNDARIES, THE LOCATION OF ALL VISIBLE STRUCTURES AND PRINCIPAL BUILDINGS THEREON, BOUNDARY FENCES, ROADWAYS AND VISIBLE ENCROACHMENT, IF ANY.
THIS SURVEY IS MADE FOR THE EXCLUSIVE USE OF THE PRESENT OWNERS OF THE PROPERTY, AND ALSO THOSE WHO PURCHASE, MORTGAGE, OR GUARANTEE THE TITLE THERETO WITHIN ONE (1) YEAR FROM THE DATE HEREOF. NO TITLE WAS PROVIDED, THEREFORE EASEMENTS THAT MAY EXIST PER TITLE ARE NOT SHOWN.

Signed *Michael P. Casey*
Michael P. Casey
Professional Land Surveyor S-2482

PA 189-2 418-2580