


PLAT OF SURVEY

**LOT 36, BLOCK 1, IN MIRAMAR SUBDIVISION
BEING A SUBDIVISION LOCATED IN SECTIONS
TEN AND ELEVEN, TOWN 4 NORTH, RANGE 18
EAST, EAST TROY TOWNSHIP, WALWORTH
COUNTY, WISCONSIN.**

**OWNER:
JONES TRUST
N50W17494 GREENVIEW AVE.
MENOMONEE FALLS, WI 53051**

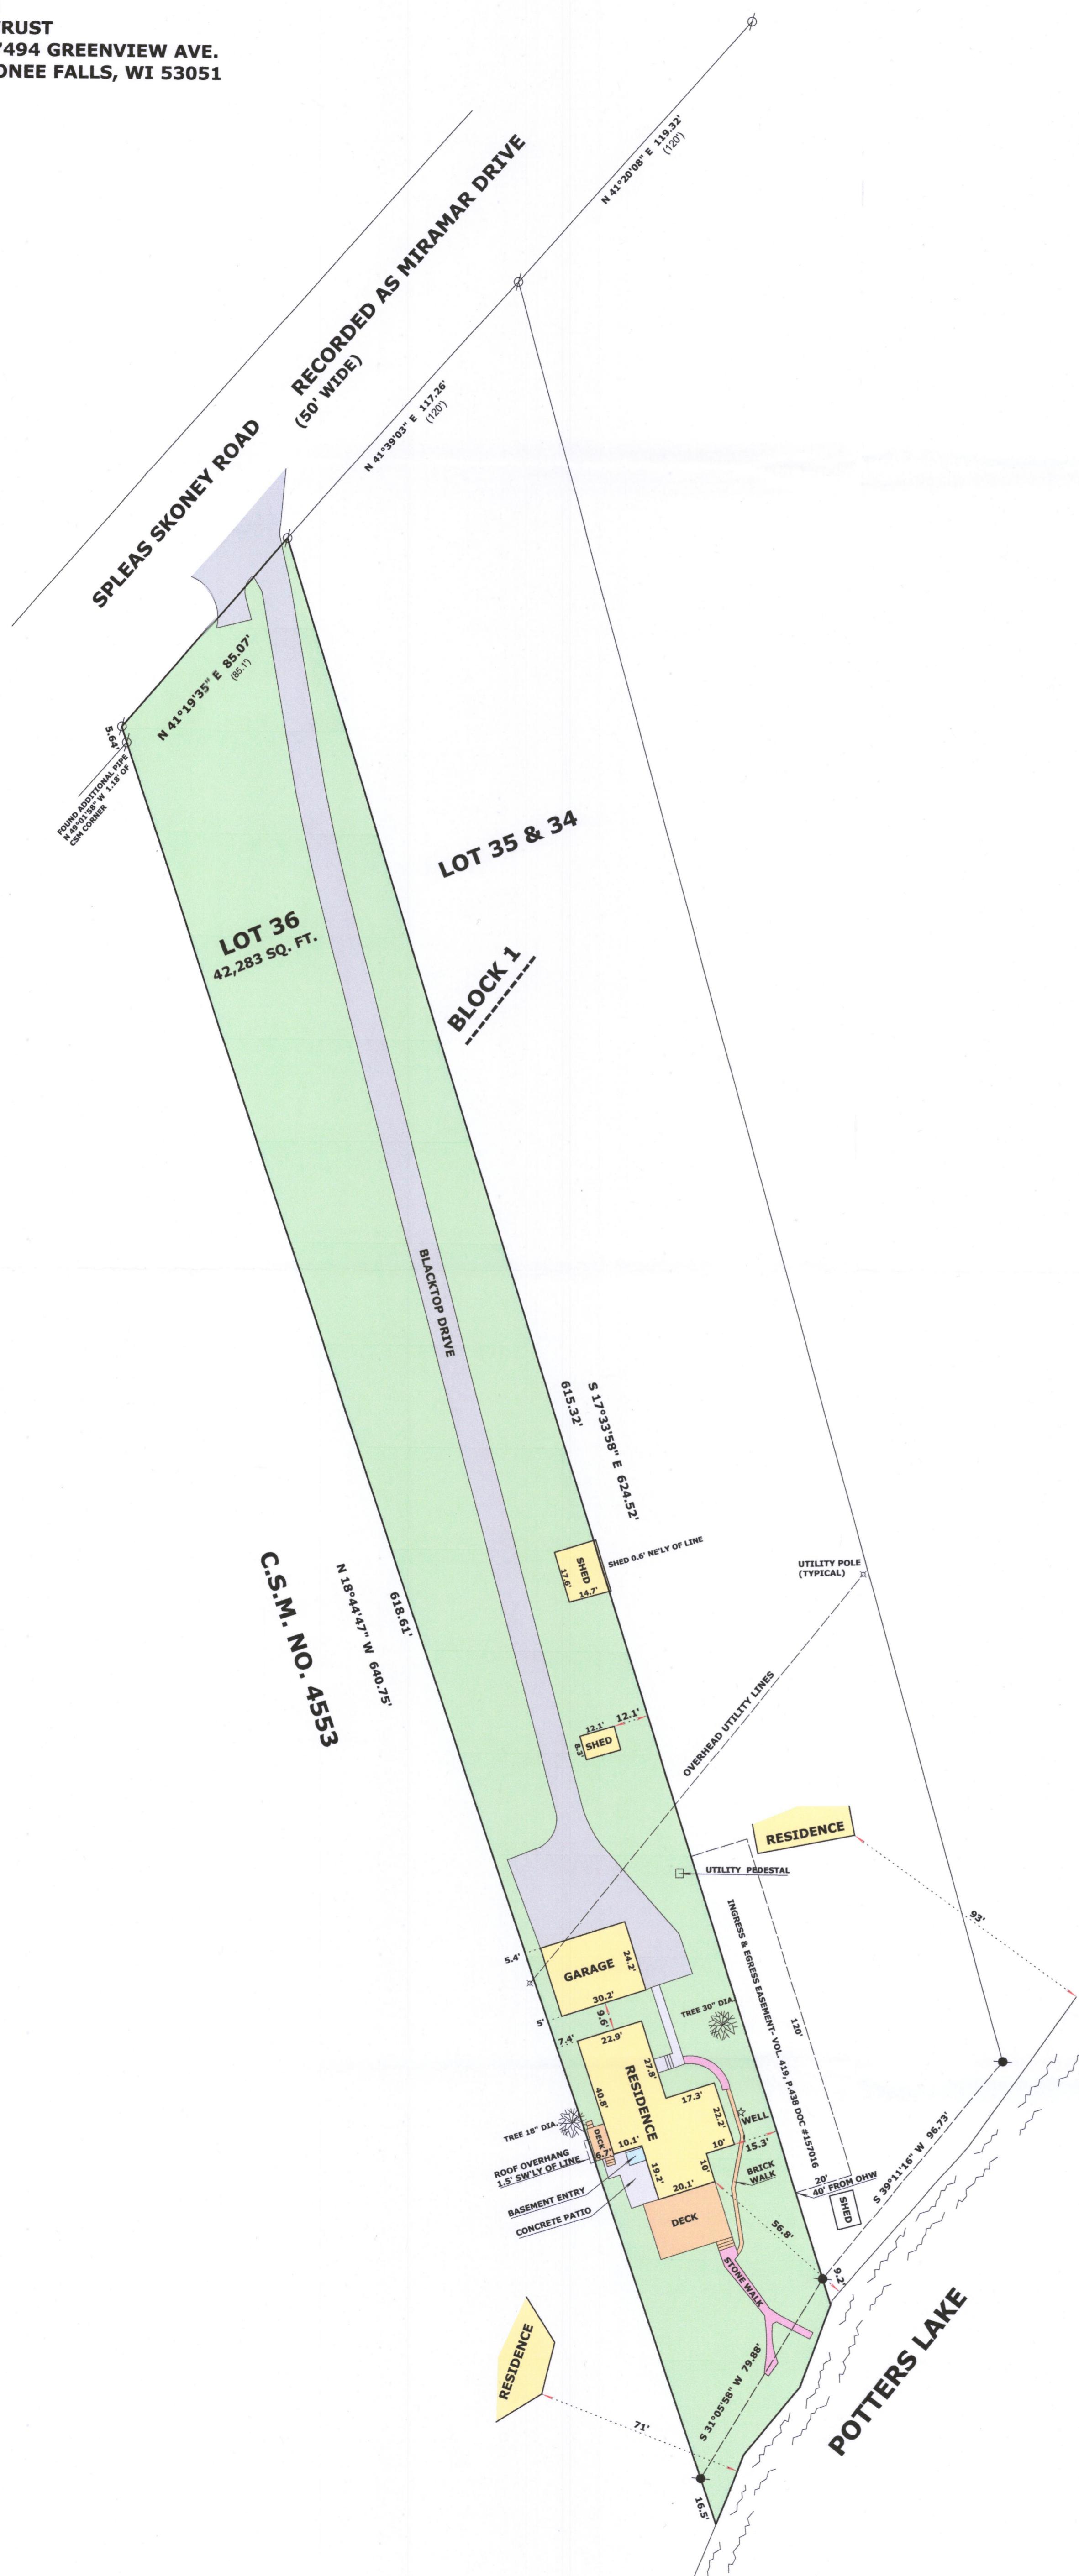


IMPERVIOUS SURFACE CALCULATION 30

RESIDENCE.....	163
SHEDS.....	362
GARAGE.....	734
BLACKTOP.....	598
DECKS.....	607
CONCRETE.....	339
STONE & BRICK....	323

**ZONED R-2
BUILDING SETBACKS
SIDEYARD..... 10'
SHOREYARD.... 75'
STREET..... 25'**

THE EAST LINE OF CSM NO. 455
WAS ASSUMED N $18^{\circ}44'47''$ W

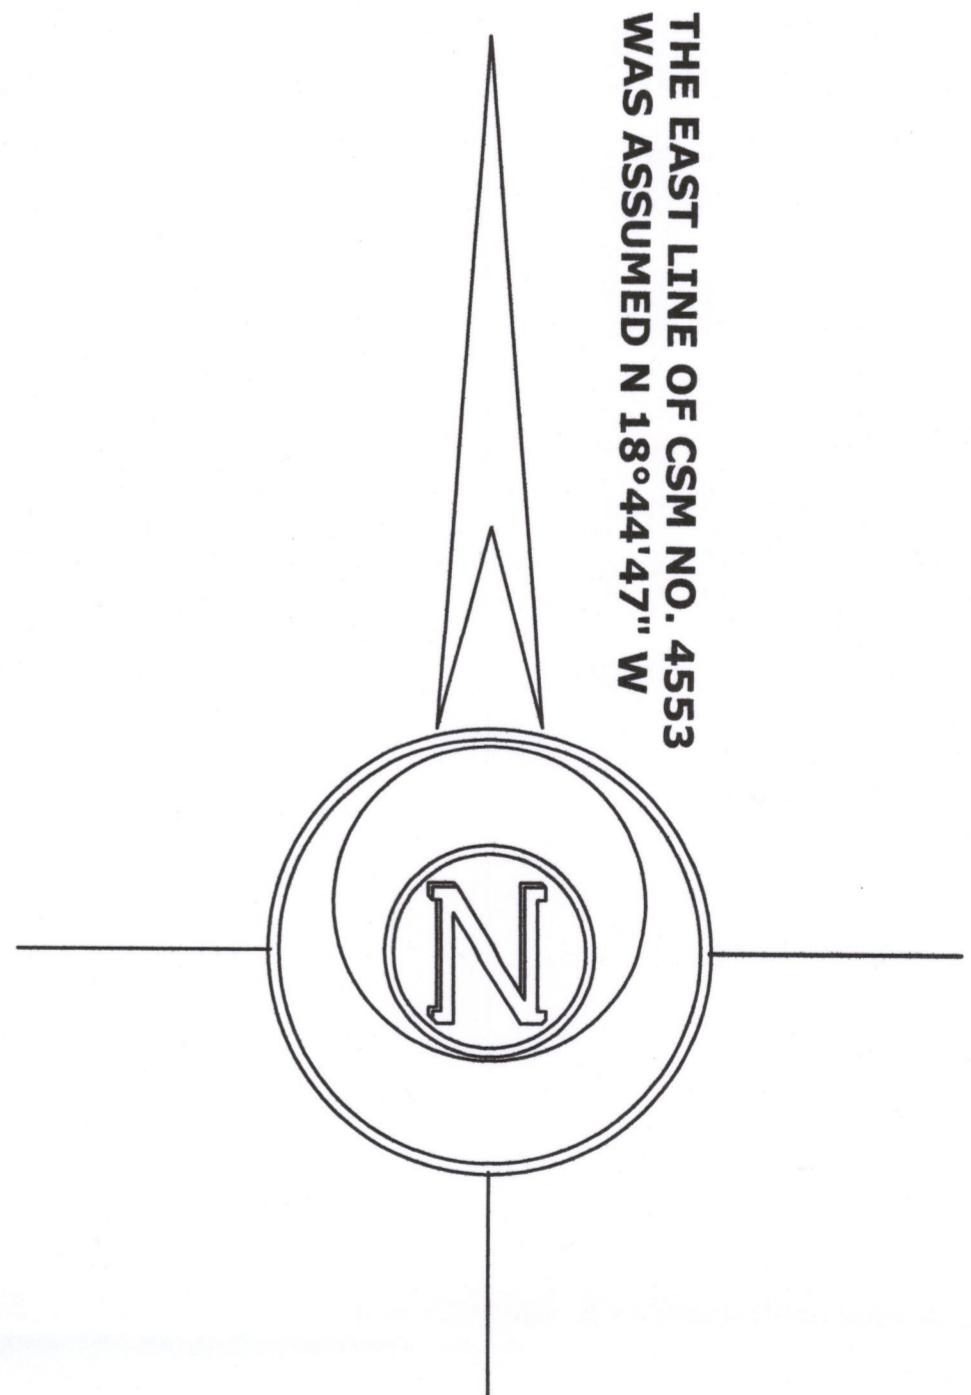

LEGEND

(x x) **RECORDED AS DIMENSION**

SCALE: 1 INCH = 30 FEET

RECEIVED
FEB 23 2018

