


MIRAMAR

DR.

MAPLE ST. (40' WIDE)

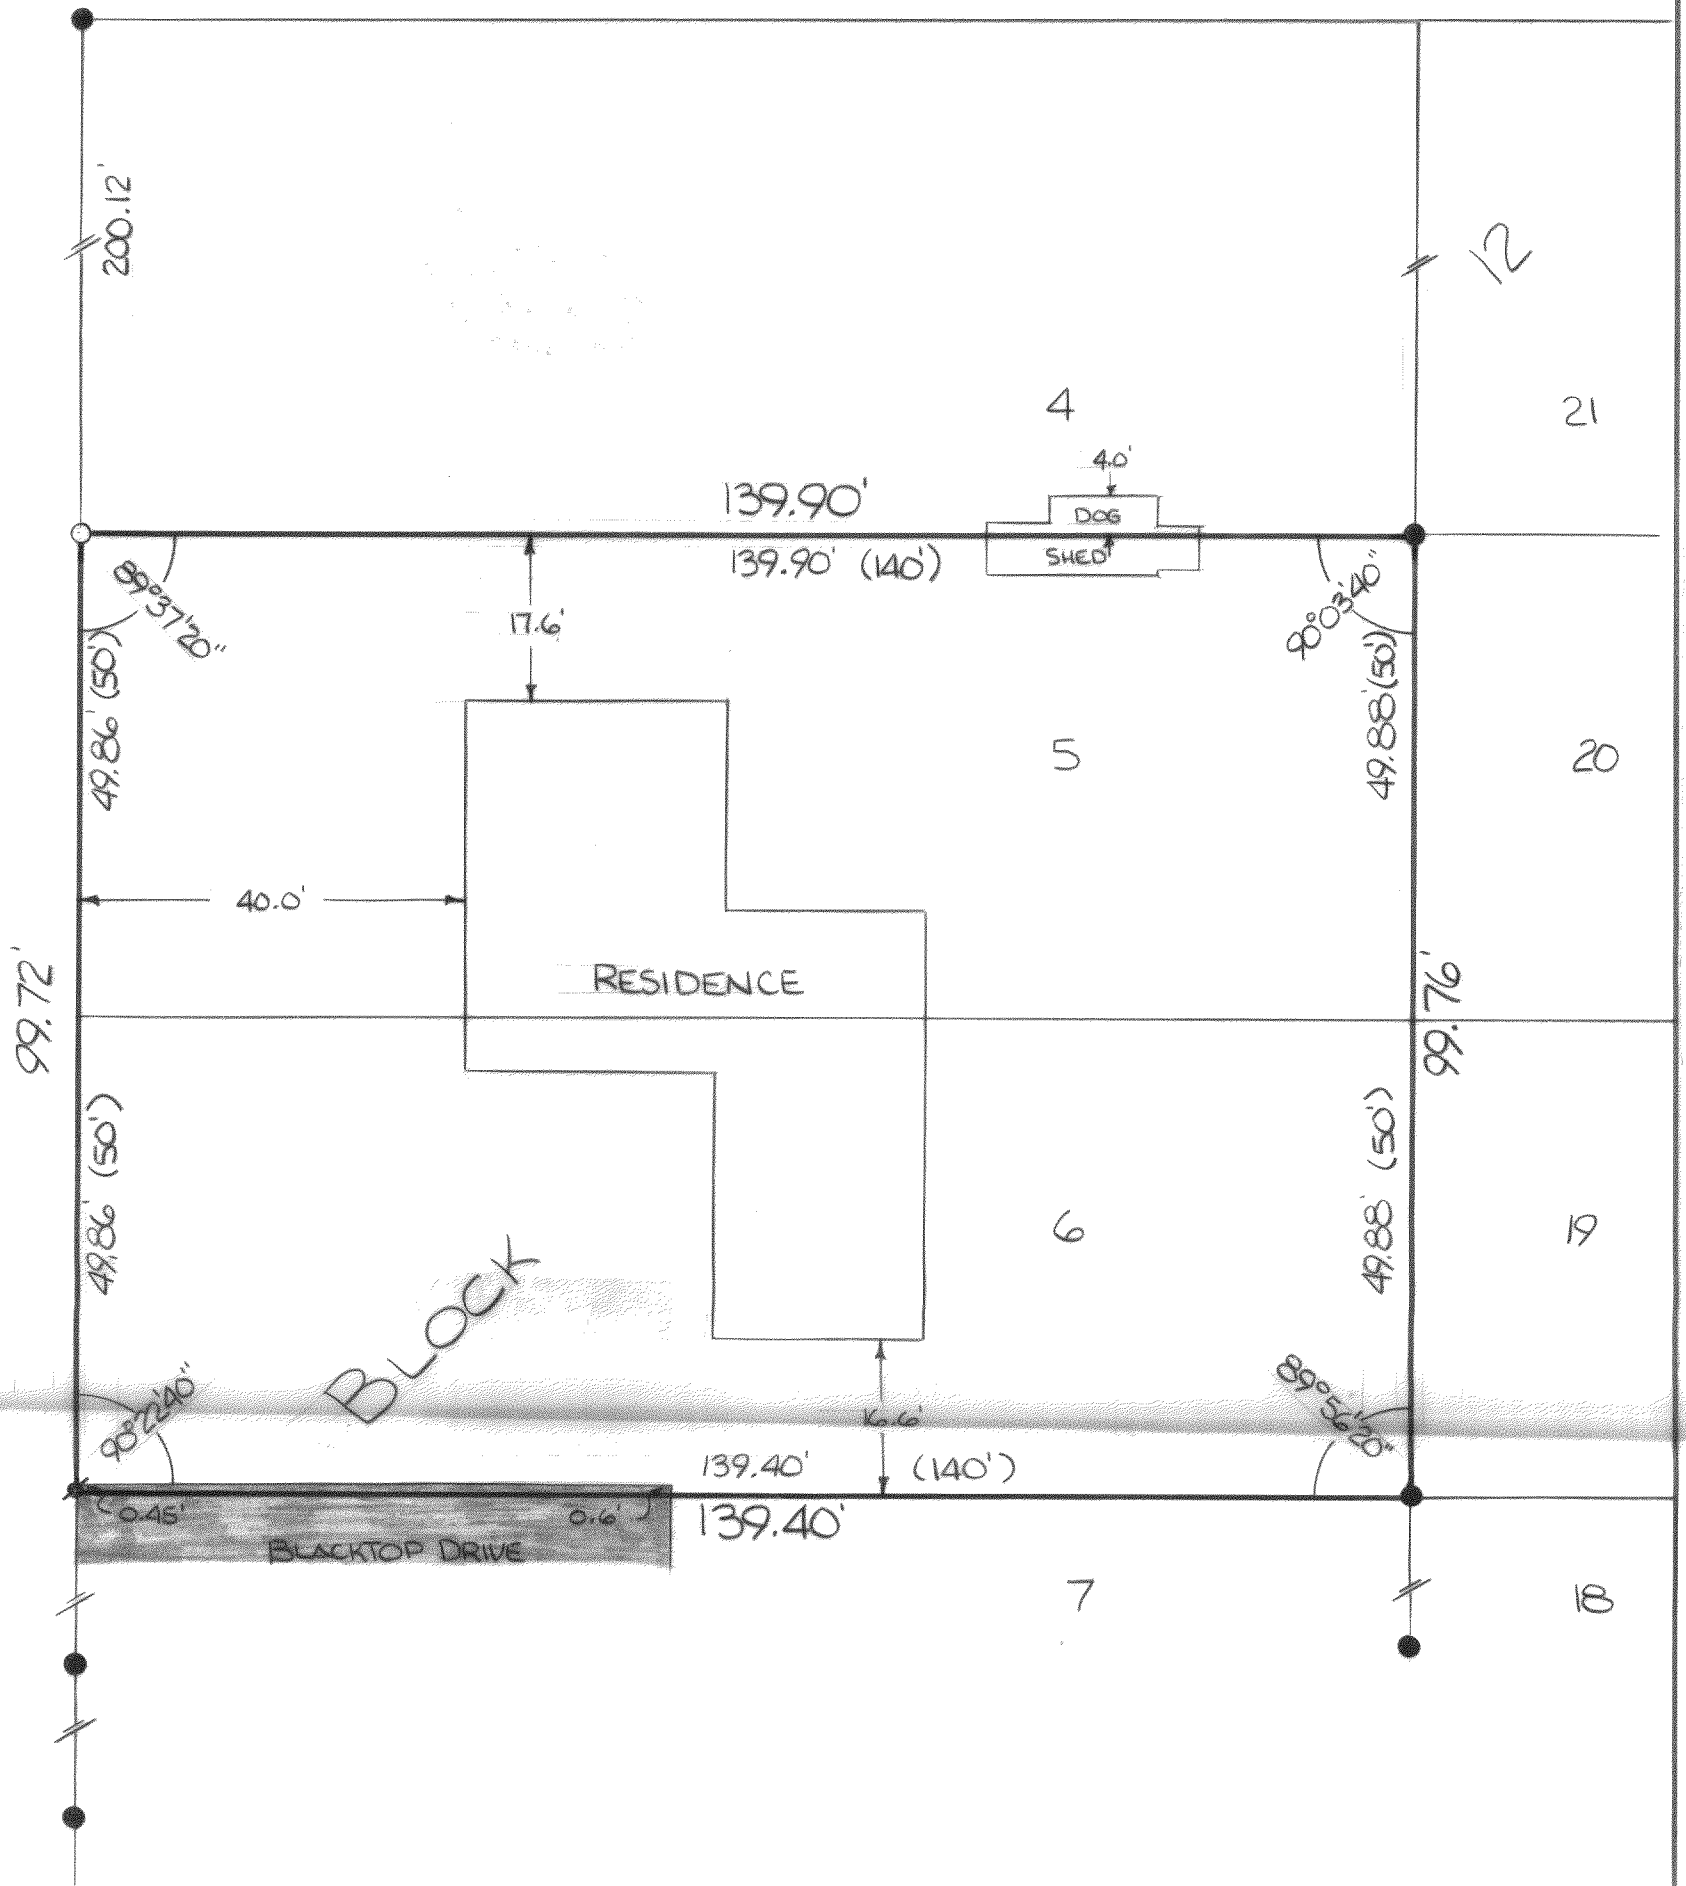

LEGEND

- IRON PIPE FOUND
- IRON PIPE SET 1 1/4" x 24"
- CONC. NAIL SET
- () RECORDED AS

DESCRIPTION:


LOTS 5 & 6 OF BLOCK 12 OF MIRAMAR SUBDIVISION,
A SUBDIVISION LOCATED IN SECTION 10, T4N, R18E,
WALWORTH COUNTY, WISCONSIN.

CERTIFICATE:

I, JOSEPH M. BIAGI, SURVEYOR, DO HEREBY CERTIFY THAT
I HAVE SURVEYED THE LAND HEREON DESCRIBED.

DATE:

DECEMBER 5, 1975

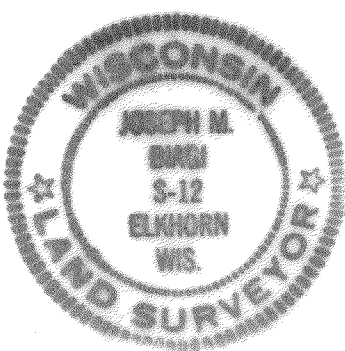

Joseph M. Biagi
JOSEPH M. BIAGI 5-12

RONALD ZERNER		
LOTS 5 & 6 BLK 12 MIRAMAR SUB.		
DRAWN BY <i>GW</i>	SCALE 1" = 20'	122-75
	DATE 12/5/75	

DR.




- IRON PIPE FOUND
- IRON PIPE SET 1/4" x 24"
- ✱ CONC. NAIL SET
- () RECORDED AS

LOTS 5 & 6 OF BLOCK 12 OF MIRAMAR SUBDIVISION,
A SUBDIVISION LOCATED IN SECTION 10, T4N, R18E,
WALWORTH COUNTY, WISCONSIN.

CERTIFICATE:
I, JOSEPH M. BIAGI, SURVEYOR, DO HEREBY CERTIFY THAT
I HAVE SURVEYED THE LAND HEREON DESCRIBED.

DATE:
DECEMBER 5, 1975

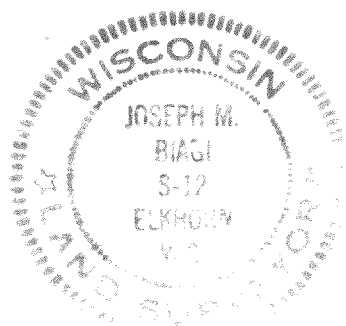

~~JOSEPH A. BIAGI~~

5-12

RONALD ZERNER		
LOTS 5&6 BLK 12 MIRAMAR SUB.		
DRAWN BY GW	SCALE 1"=20'	
	DATE 12/5/75	
		122-75

418-269