


BLOCK 10



ASH STREET 40' WIDE

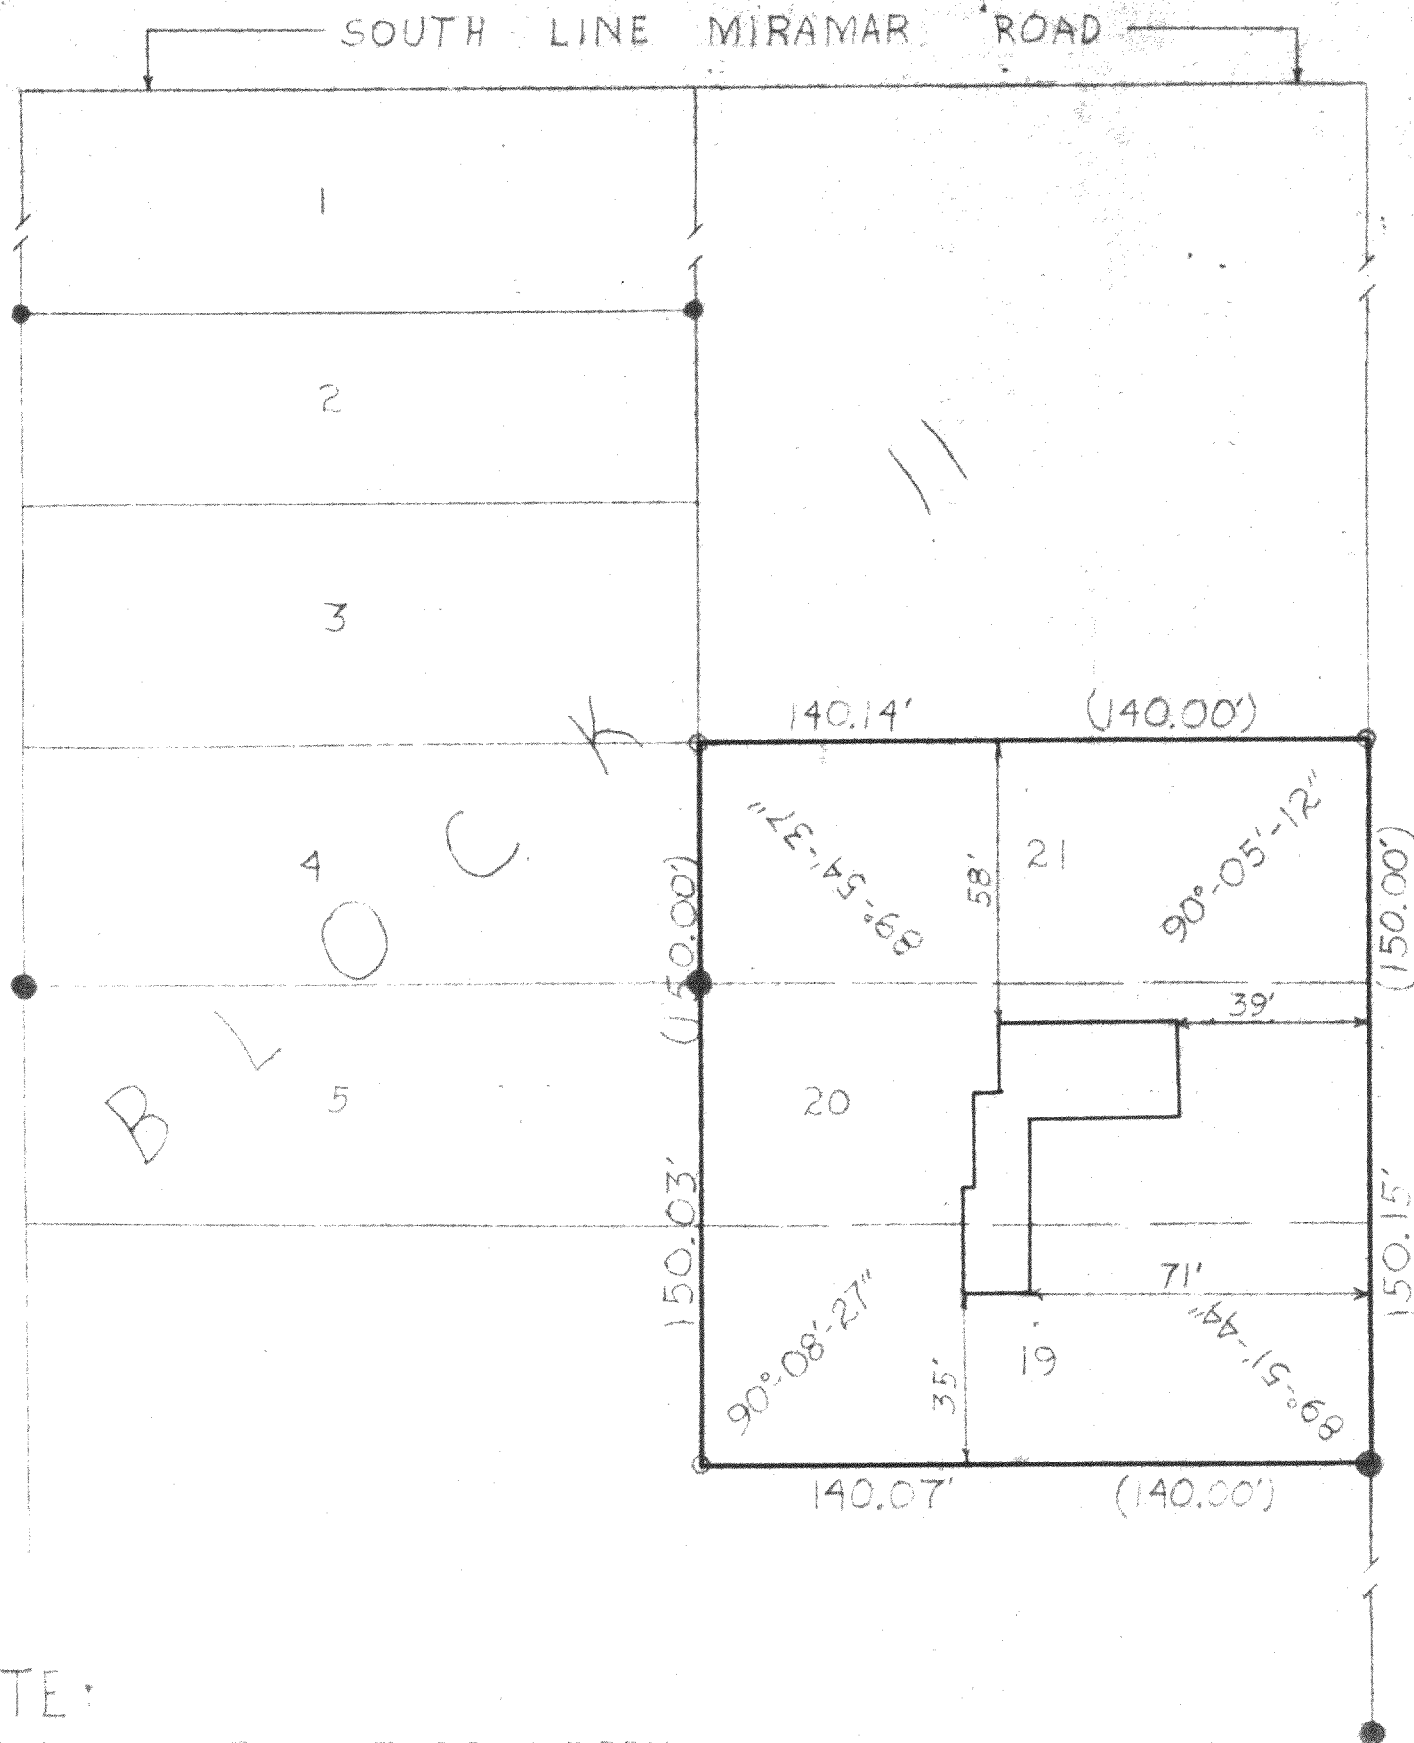

MAPLE STREET 40' WIDE

BLOCK 12

HICKORY STREET 40' WIDE

### DESCRIPTION:

LOTS 19, 20, AND 21 IN BLOCK 11 IN MIRAMAR SUBDIVISION, LOCATED IN SECTION 10, TOWN 4 NORTH, RANGE 18 EAST, WALWORTH COUNTY, WISCONSIN.

### LEGEND


- IRON PIPE FOUND
- IRON ROD FOUND
- IRON PIPE SET
- ( ) RECORDED AS

DATE: DECEMBER 9, 1975

### CERTIFICATE:

I JOSEPH M. BIAGI, SURVEYOR, DO HEREBY CERTIFY THAT I HAVE SURVEYED THE LANDS HEREON DESCRIBED.

*Joseph M. Biagi*  
JOSEPH M. BIAGI R.L.S. #12

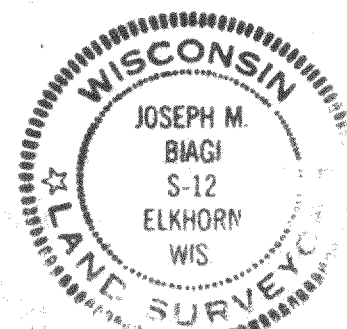

| REVISIONS |      |    | ERVIN RICHARDS                                           |          |             |
|-----------|------|----|----------------------------------------------------------|----------|-------------|
| NO.       | DATE | BY | LOTS 19-21, BLOCK 11, MIRAMAR SUB, WALWORTH COUNTY, WIS. |          |             |
| 1         |      |    | DRAWN BY                                                 | SCALE    | MATERIAL    |
| 2         |      |    | HWG                                                      | 1" = 40' |             |
| 3         |      |    | CHK'D                                                    | DATE     | DRAWING NO. |
| 4         |      |    |                                                          | 12-9-75  | #123-75     |
| 5         |      |    | TRACED                                                   | APP'D    |             |

