


LOTS 11 AND 12 IN LAKE BEULAH MANOR, ACCORDING TO THE RECORDED PLAT THEREOF AND BEING IN THE WEST ½ OF SECTION 9, TOWNSHIP 4 NORTH, RANGE 18 EAST, OF THE FOURTH PRINCIPAL MERIDIAN IN THE TOWN OF EAST TROY, WALWORTH COUNTY, WISCONSIN.

(100.00')	RECORDED DISTANCE
100.00'	MEASURED DISTANCE
●	1" FOUND IRON PIPE, UNLESS NOTED
⊗	¾" x 18" IRON PIPE SET, 1.13 lbs./L.F.
△ _W	WELL
⊙	SEPTIC TANK
⊙	SEPTIC VENT
⊗	LIGHT POLE
⊞	ELECTRIC TRANSFORMER
⊙	ELECTRIC PEDESTAL
⊞	TELEPHONE PEDESTAL
⊙	CABLE TV PEDESTAL

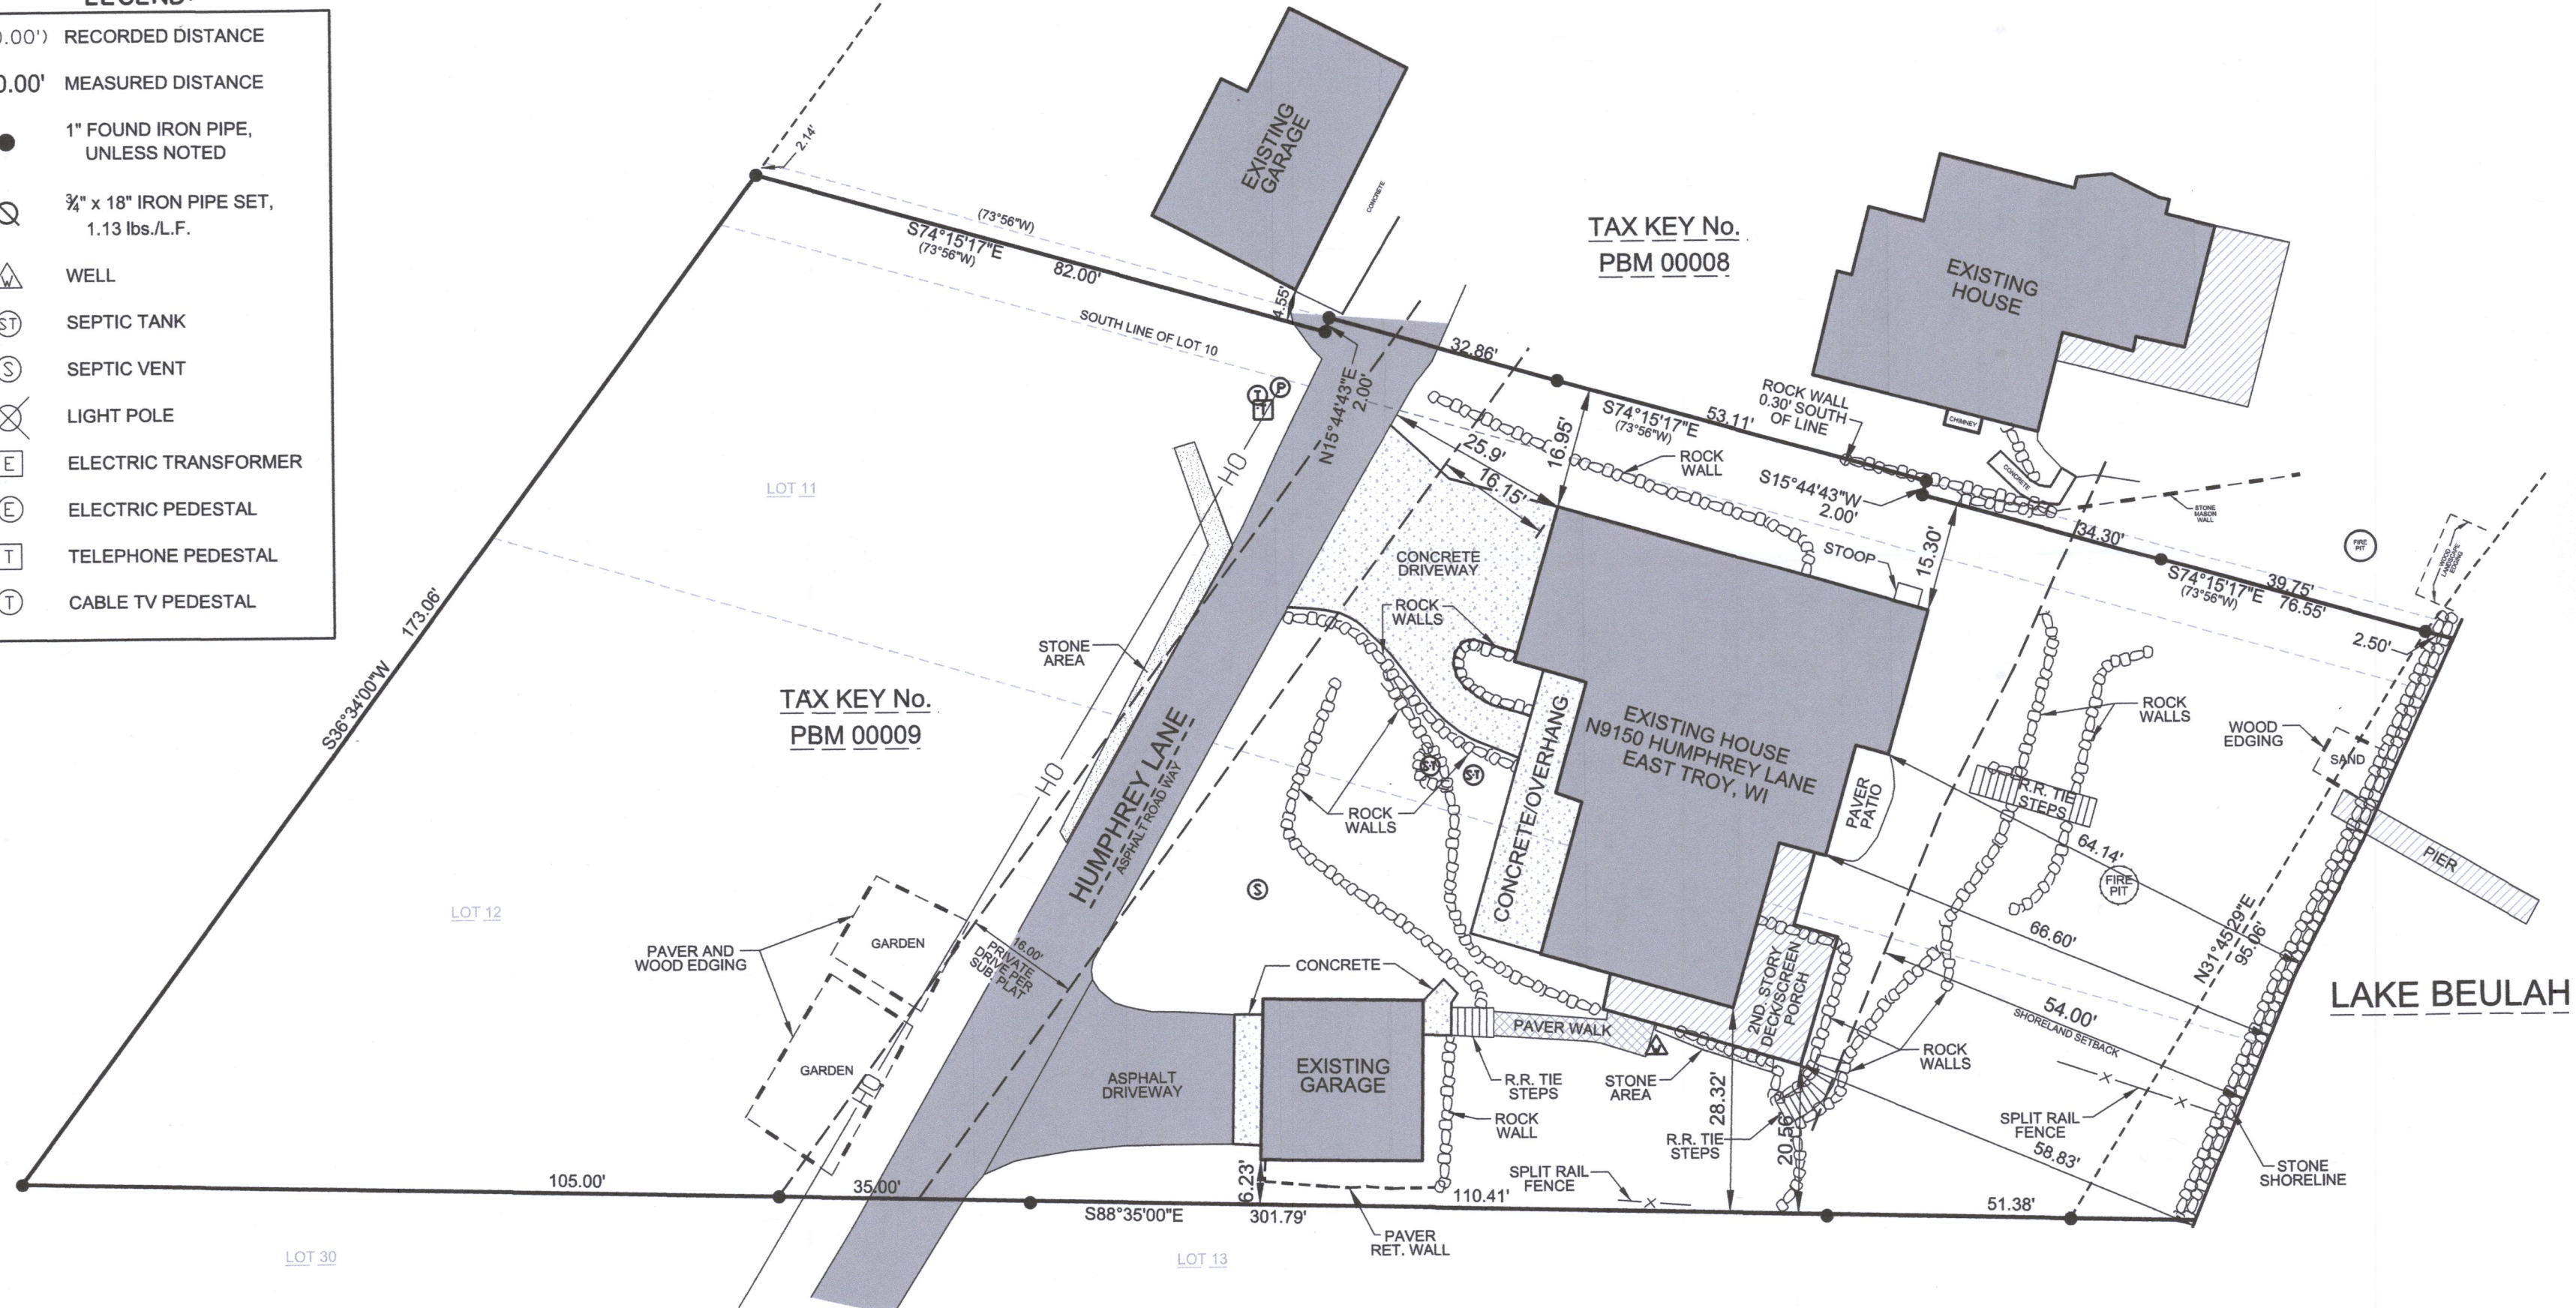

I, MICHAEL A. GREESON P.L.S. #2770, HEREBY CERTIFY THAT THIS SURVEY WAS DONE UNDER MY DIRECTION AND THAT THE ABOVE MAP IS A TRUE REPRESENTATION THEREOF AND SHOWS THE SIZE AND LOCATION OF THE PROPERTY, ITS EXTERIOR BOUNDARIES, THE LOCATION OF ALL VISIBLE STRUCTURES AND DIMENSIONS OF ALL PRINCIPAL BUILDINGS THEREON, BOUNDARY FENCES, APPARENT EASEMENTS, ROADWAYS AND VISIBLE ENCROACHMENTS, IF ANY.

THIS SURVEY IS MADE FOR THE USE OF THE PRESENT OWNERS OF THE PROPERTY, AND ALSO THOSE WHO PURCHASE, MORTGAGE OR GUARANTEE TITLE TO WITHIN ONE (1) YEAR FROM DATE HERETO.

SURVEY DATE: 08/11/2020
SURVEY MADE FOR:
 JOHN RUSSEL
 434 N. CANAL ST
 CHICAGO, IL 60654

V²G
 SURVEYING, LLC
 128 WOODRIDGE AVE
 INDIANAPOLIS, IN 46219
 (262) 378-5097

PLOT DATE: 7/29/2020

PBM -9

418-2728

V2G JOB # 2020-120 JOHN RUSSEL N9150 HUMPHREY LN.DGN