


418-276


PLAT OF SURVEY OF

LOT 8 AND LOT 9 OF FAIRWAY SUBDIVISION,
BEING A RESUBDIVISION OF PART OF WILLIAMS
PARK SUBDIVISION, LOCATED IN THE SW $\frac{1}{4}$ NE $\frac{1}{4}$
AND THE SE $\frac{1}{4}$ NW $\frac{1}{4}$ OF SEC. 4, T4N-R18E, WALWORTH
COUNTY, WISCONSIN

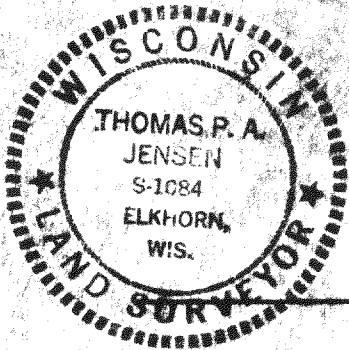

NOTE: ALL PROPERTY
CORNERS ALONG HWY.
"J" ARE MISSING OR
BENT FROM HWY. CONST.

4 HIGHWAY "J"
66' WIDE

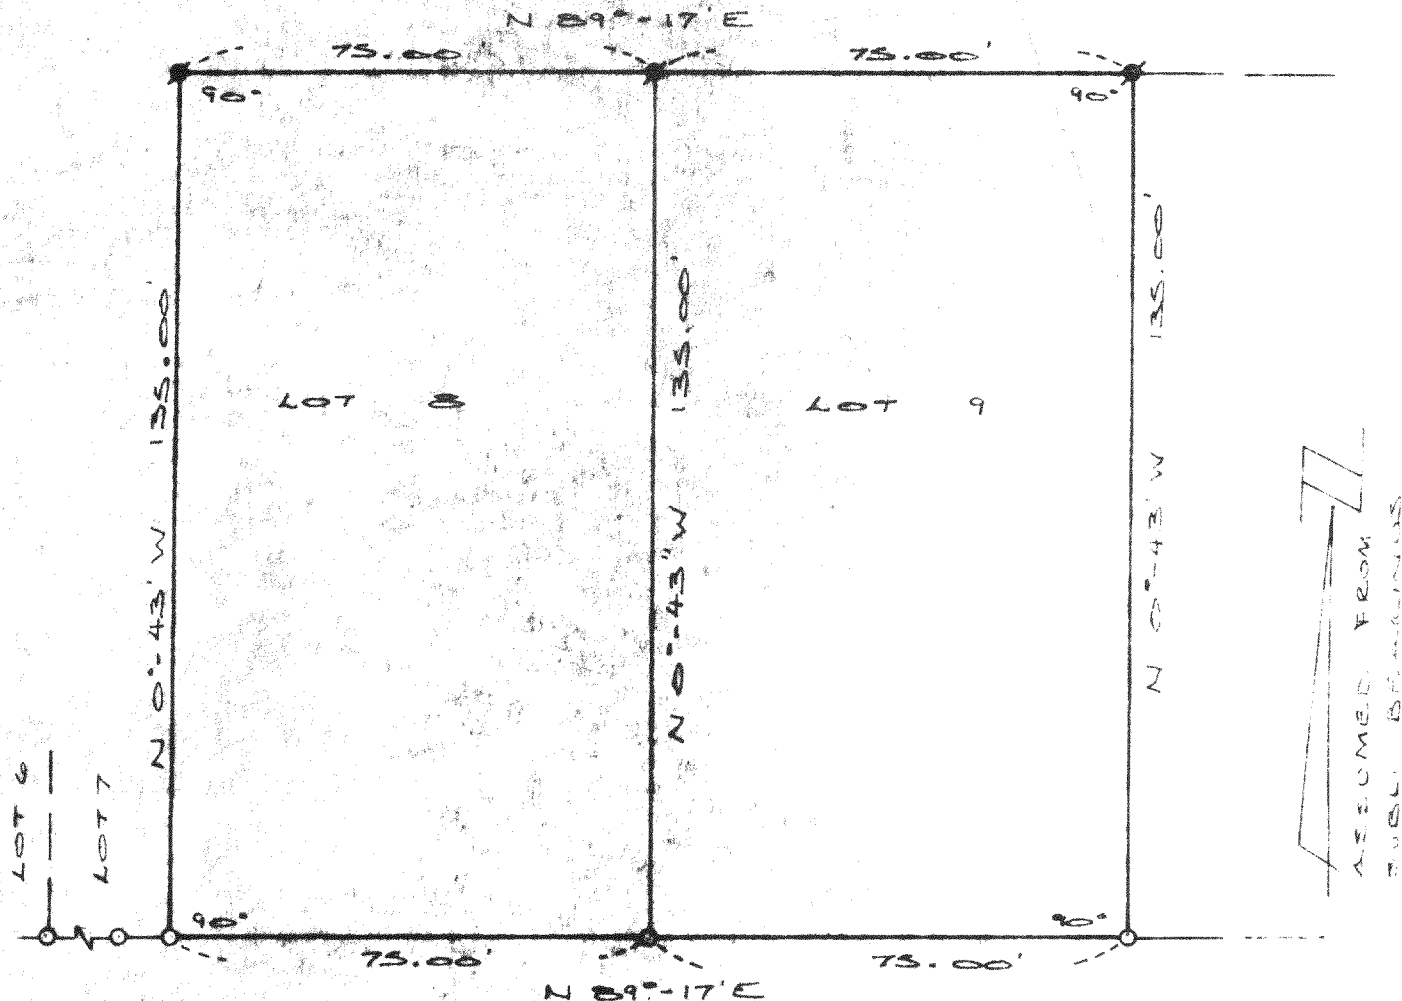

SURVEYED FOR: BIELINSKI REALTY, INC.

2910 N. GRANDVIEW BLVD SURVEY AND PLAT BY
WAUWATOSA, WIS. 53186

JENSEN & JOHNSON, INC.
CIVIL ENGINEERS AND SURVEYORS

Elkhorn, Wisconsin

LEGEND

- — Iron Pipe FOUND
- — Concrete Monument

Scale 1" = 30'

● - $\frac{3}{4}$ " DIA. X 24" LONG
IRON ROD SET

WE CERTIFY: That we have surveyed the above described property and
that the plat shown hereon is an accurate survey and a true representation
thereof and correctly shows the exterior boundary lines and all divisions of
said property.

Date MAR 24, 1976

Thomas P. A. Jensen

Wisconsin Registered Land Surveyor, No. 1084

PF-8, 9

418-276