
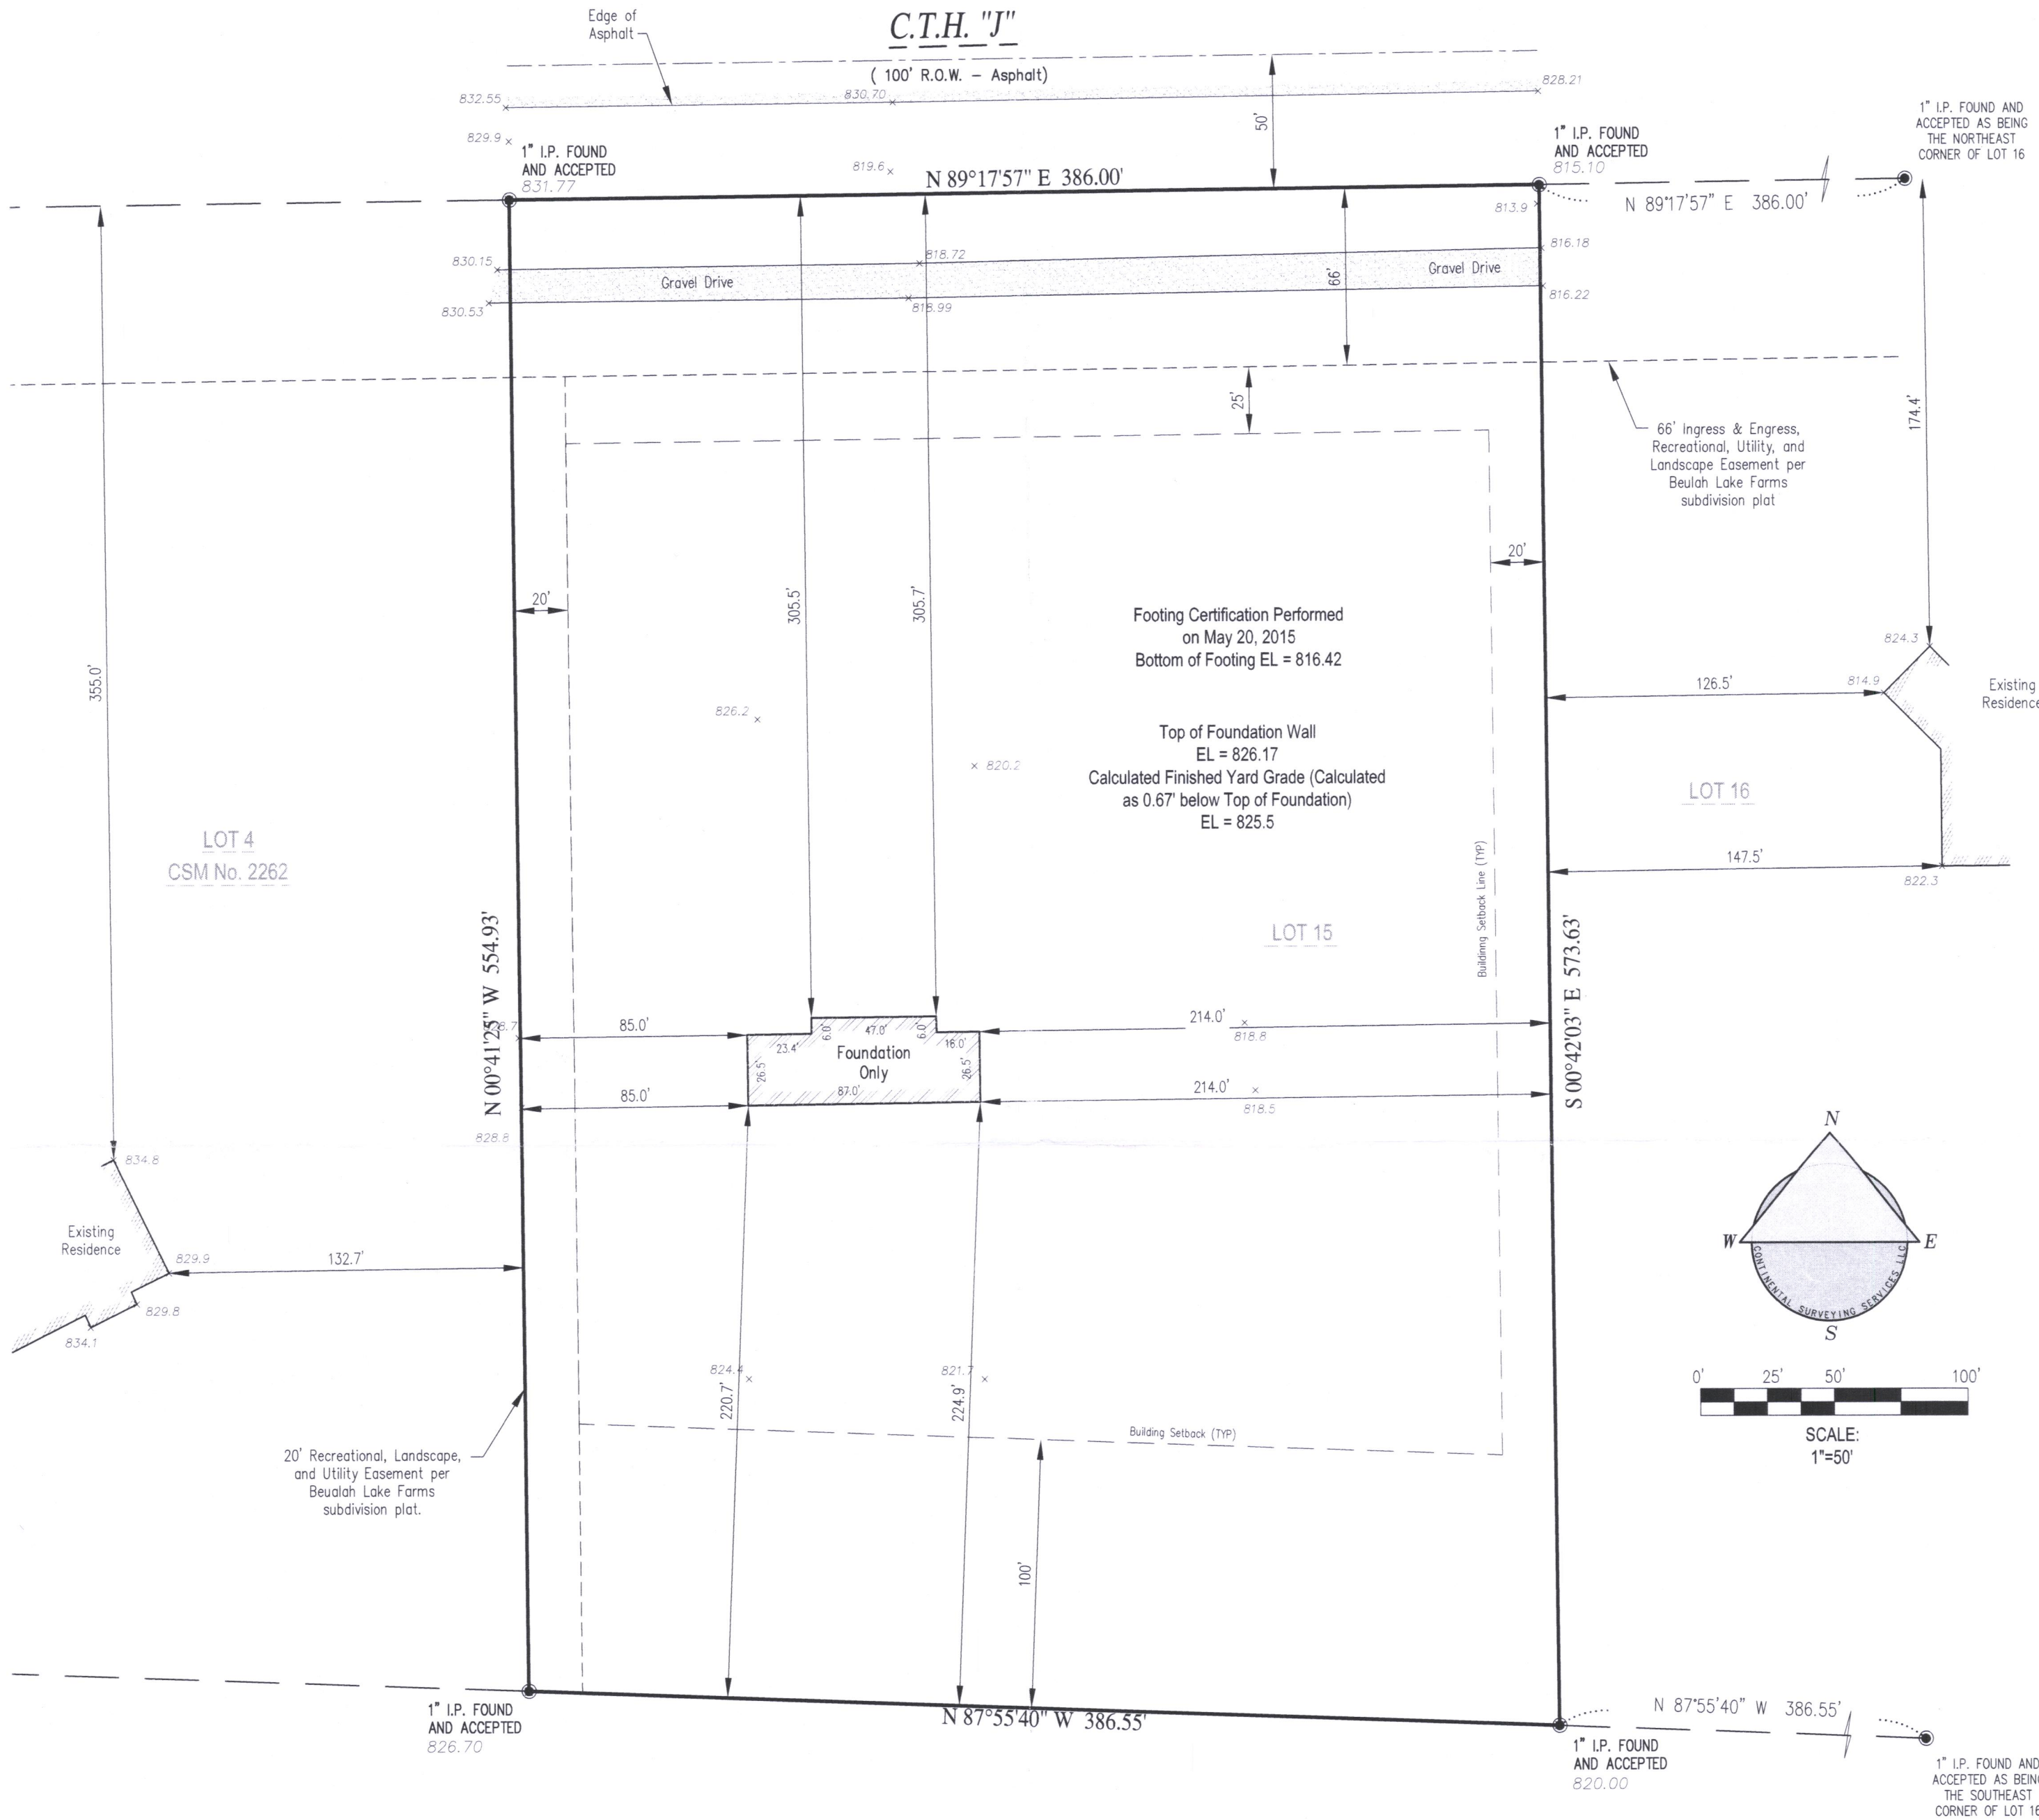


PLAT OF SURVEY

PROPERTY DESCRIPTION: (Per Document No.:887286)

PARCEL 1: Lot 15 of Beulah Lake Farms, a subdivision located in part of the Northwest, Northeast, Southwest and Southeast Quarters of the Northwest Quarter and part of the Northeast, Northwest, Southeast and Southwest Quarters of the Northeast Quarter of Section 3, T4N, R18E, Town of East Troy, Walworth County, Wisconsin.

PARCEL 2: Together with a non-exclusive perpetual easement for ingress and egress over Lot 4 of Certified Survey Map No. 2262, recorded in Volume 11 of Certified Survey Maps, on Page 67, as Document No. 250970, as shown on the said plat of Beulah Lake Farms, Town of East Troy, Walworth County, Wisconsin.

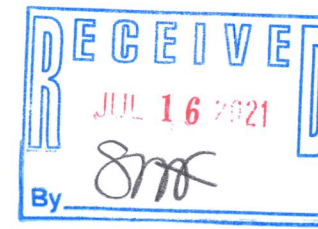

Conversion to Inches	
0.083'	= 1"
0.166'	= 2"
0.250'	= 3"
0.333'	= 4"
0.416'	= 5"
0.500'	= 6"
0.583'	= 7"
0.666'	= 8"
0.750'	= 9"
0.833'	= 10"
0.916'	= 11"
1.000'	= 1 Foot

CONTINENTAL
SURVEYING
SERVICES LLC

Registered Land Surveyors, Surveying Since 1987

Focusing on You!

We are your Land Surveyor and Land Surveying Resource

2059 Hwy 175, Suite "A"
Richfield, WI 53076
Phone: (262) 389-9200
Website: www.csssurveys.com
Email: survey@csssurveys.com

CLIENT:
Cobblestone Builders
N86 W14041 Beacon Street
Menomonee Falls, WI 53052

PROPERTY ADDRESS:
Lot 15 C.T.H. "J"
East Troy,
Wisconsin 53120

PARCEL INFO:
TAX KEY NUMBER: PBF 00015
SURVEY NO.: 20150616_BSE0001
PROJECT NO.: 20150312_BS00002

For questions regarding underground utilities please contact:

DIGGERS HOTLINE
PHONE: Wisconsin 1 Call center 1 (800) 242-8511

NOTE:

Bearings are referenced to the South Line of
C.T.H. "J" as being N 89°17'57" E

NOTE: Underground Utilities

Location of Underground utilities are not
part of the agreement made between the
Surveyor AND Client named on this map,
therefore none are shown.



I HEREBY CERTIFY THAT I HAVE SURVEYED THE ABOVE DESCRIBED PROPERTY AND IN MY PROFESSIONAL
OPINION THE ABOVE MAP IS A TRUE REPRESENTATION THEREOF AND SHOWS THE SIZE AND LOCATION
OF THE PROPERTY, ITS EXTERIOR BOUNDARIES, ROADWAYS, THE LOCATION OF ALL VISIBLE STRUCTURES
WITHIN OR NEAR SAID BOUNDARIES, AND APPARENT EASEMENTS, IF ANY.

THIS SURVEY IS MADE FOR THE EXCLUSIVE USE OF THE PRESENT OWNERS OF THE PROPERTY, AND
ALSO THOSE WHO PURCHASE, MORTGAGE OR GUARANTEE THE TITLE THERETO. THIS SURVEY COMPLIES
WITH WISCONSIN ADMINISTRATIVE CODE AE-7 EXCEPT FOR THOSE ITEMS WAIVED, IF ANY, AND IS
BOUND BY WISCONSIN STATE STATUTE 893.37 THAT DEFINES STATUTE OF LIMITATIONS IN REGARDS TO
SURVEYS.

Rick R. Hillmann S-3005

Dated this 17th Day of JUNE, 2015.