


LAKELAND SURVEYORS LLC
3714 SOUTH SHORE DRIVE
UNIT B
DELAVAN, WI 53115
262-475-9567
lakelandsurveyors@outlook.com

PLAT OF SURVEY



- OF -

PREPARED FOR:
STEVEN & DEBBIE ZDEB

Lot 1, DUTCHLAND ACRES, located in the Southeast 1/4 of the Northeast 1/4 of Section 21, Town 4 North, Range 18 East,
Town of East Troy, Walworth County, Wisconsin.

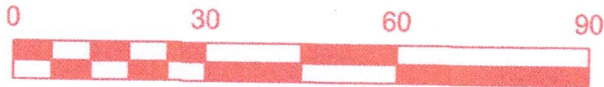

BASIS OF BEARING: THE US STATE PLANE COORDINATE SYSTEM
WISCONSIN SOUTH ZONE NAD 83 (2011)

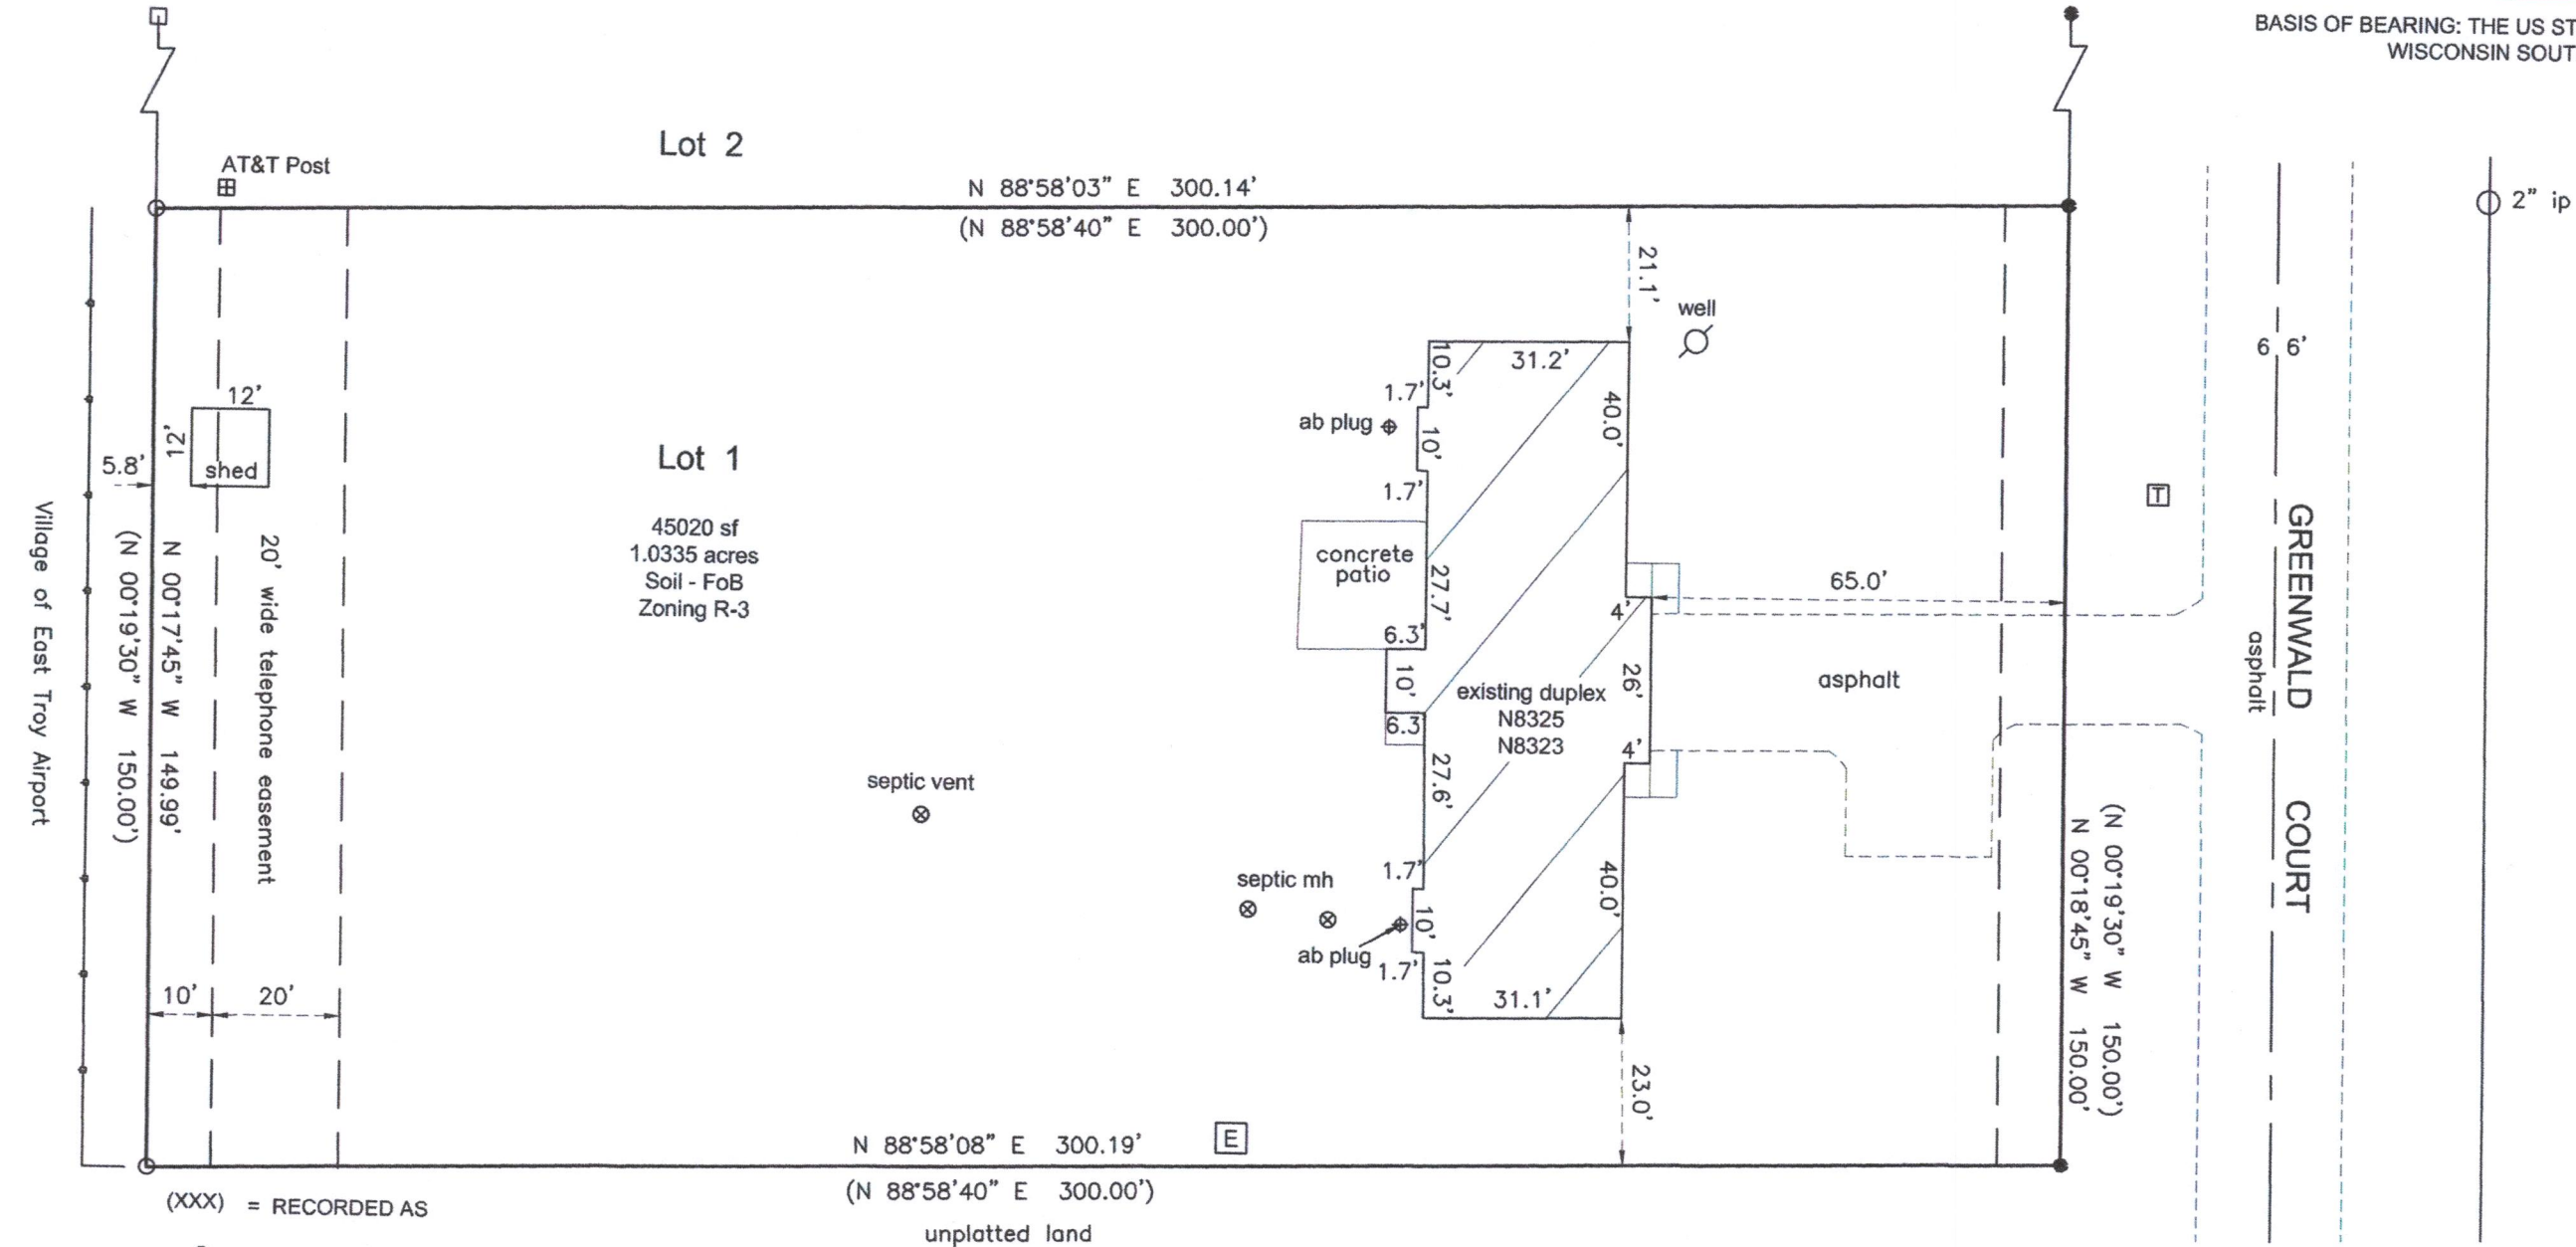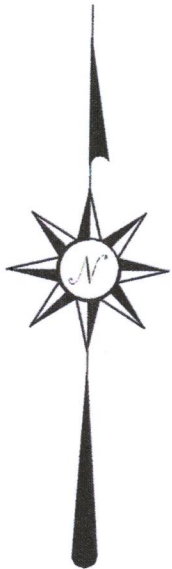


- (XXX) = RECORDED AS
○ = FOUND IRON PIPE
● = SET IRON PIPE 1" OD
□ = FOUND IRON BAR
[E] = TRANSFORMER
[T] = COMMUNICATIONS PEDESTAL

SCALE 1" = 30'

JOB NO. 2021-032

TAX ID # PD 00001

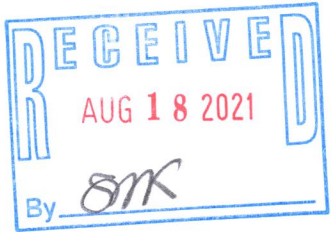

I HEREBY CERTIFY THAT I HAVE SURVEYED THE ABOVE DESCRIBED PROPERTY
AND THE ABOVE MAP IS A TRUE REPRESENTATION THEREOF AND SHOWS THE SIZE
AND LOCATION OF THE PROPERTY, ITS EXTERIOR BOUNDARIES, THE LOCATION AND
DIMENSIONS OF ALL STRUCTURES THEREON, FENCES, APPARENT EASEMENTS,
ROADWAYS, AND VISIBLE ENCROACHMENTS, IF ANY.

THIS SURVEY IS MADE FOR THE PRESENT OWNERS OF THE PROPERTY, AND THOSE
WHO PURCHASE, MORTGAGE, OR GUARANTEE THE TITLE THERETO WITHIN ONE YEAR
FROM THIS DATE HEREOF.

DATED THIS 19TH DAY OF JULY 2021



Steven L. Schmidt
STEVEN L. SCHMIDT S - 2813
Wisconsin Professional Land Surveyor

418-2780