


GEORGE T. DUNHAM
SURVEYING & SUBDIVIDING
DELAVER, WISCONSIN

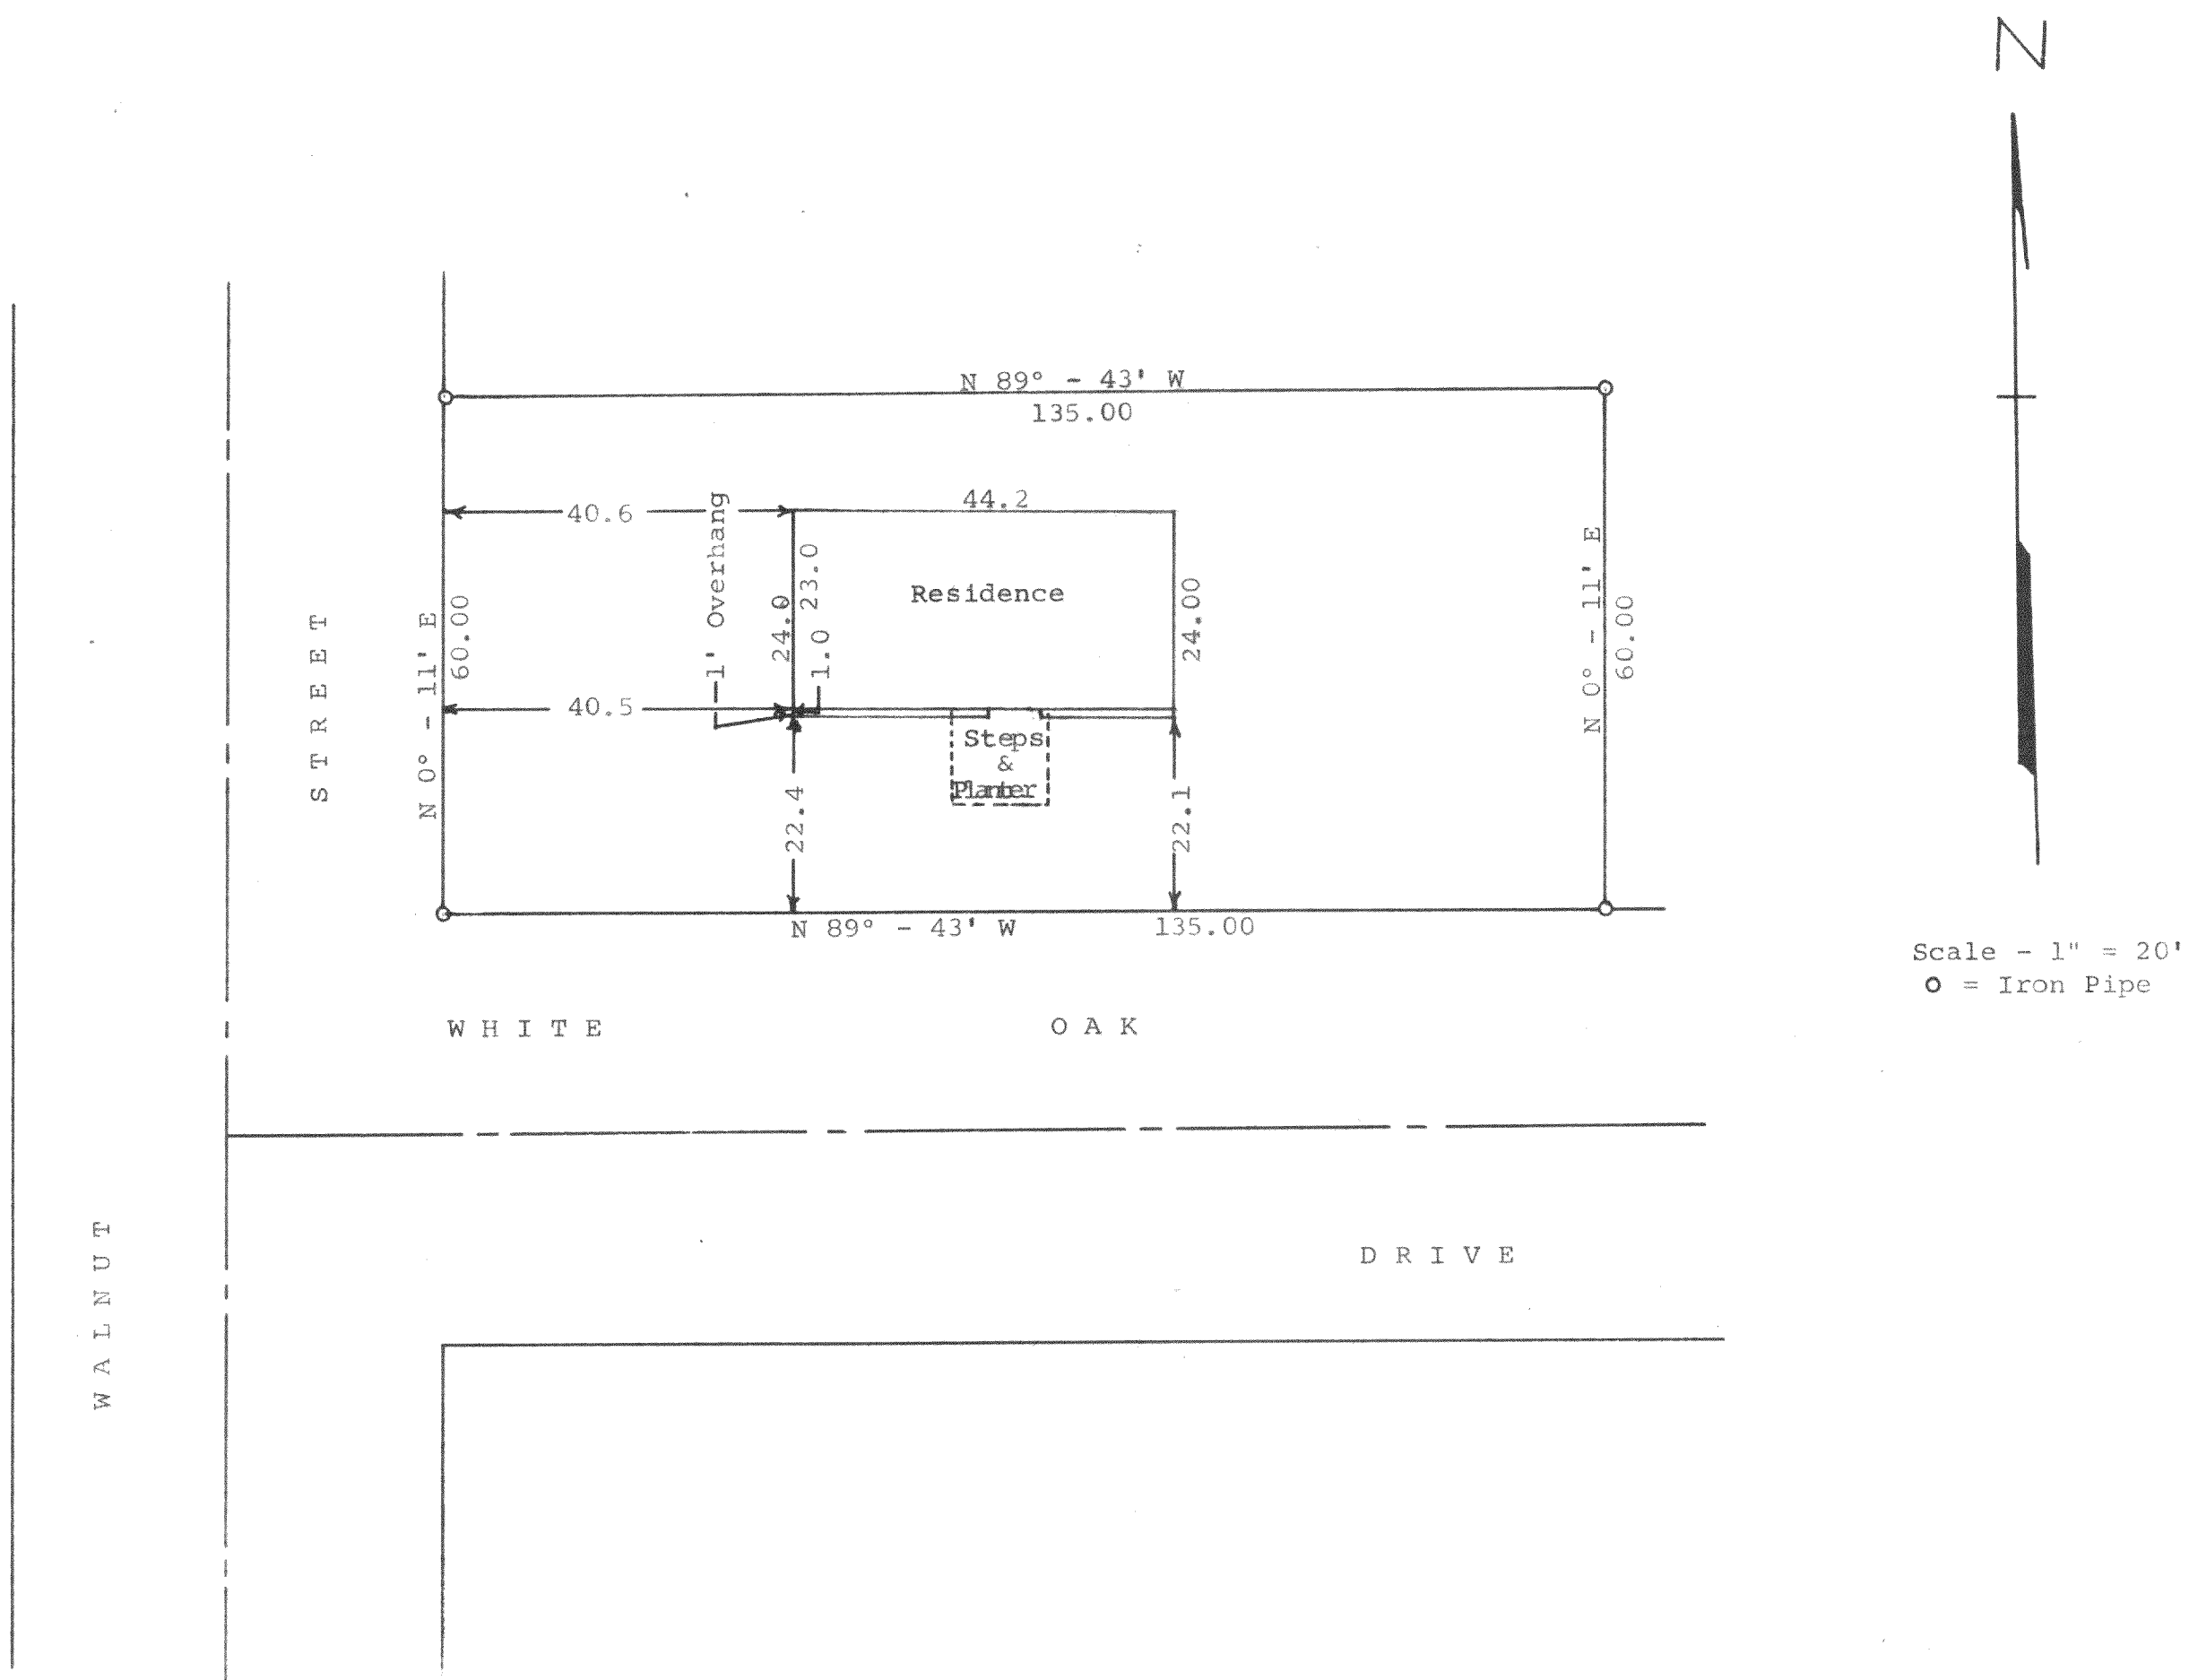

STATE OF WISCONSIN)
WALWORTH COUNTY) SS

I, George T. Dunham, Surveyor, certify that I have surveyed the property described as follows,
Lot 10, Block 20, Plat of Miramar Addition No. 1
being a subdivision located in Section 10, T 4 N,
R 18 E, Walworth County, Wisconsin.
and that the above plat is an accurate survey and a true representation thereof and correctly shows the location of the residence on said property and the correct measurements thereof.
May 20, 1966.

George T. Dunham
George T. Dunham, Surveyor