


PLAT OF SURVEY

LOT 3, CHAMBERLIN'S SUBDIVISION, LCOATED IN THE NORTHWEST ¼ OF SECTION 9, TOWN 4 NORTH, RANGE 18 EAST, TOWN OF EAST TROY, WALWORTH COUNTY, WISCONSIN.

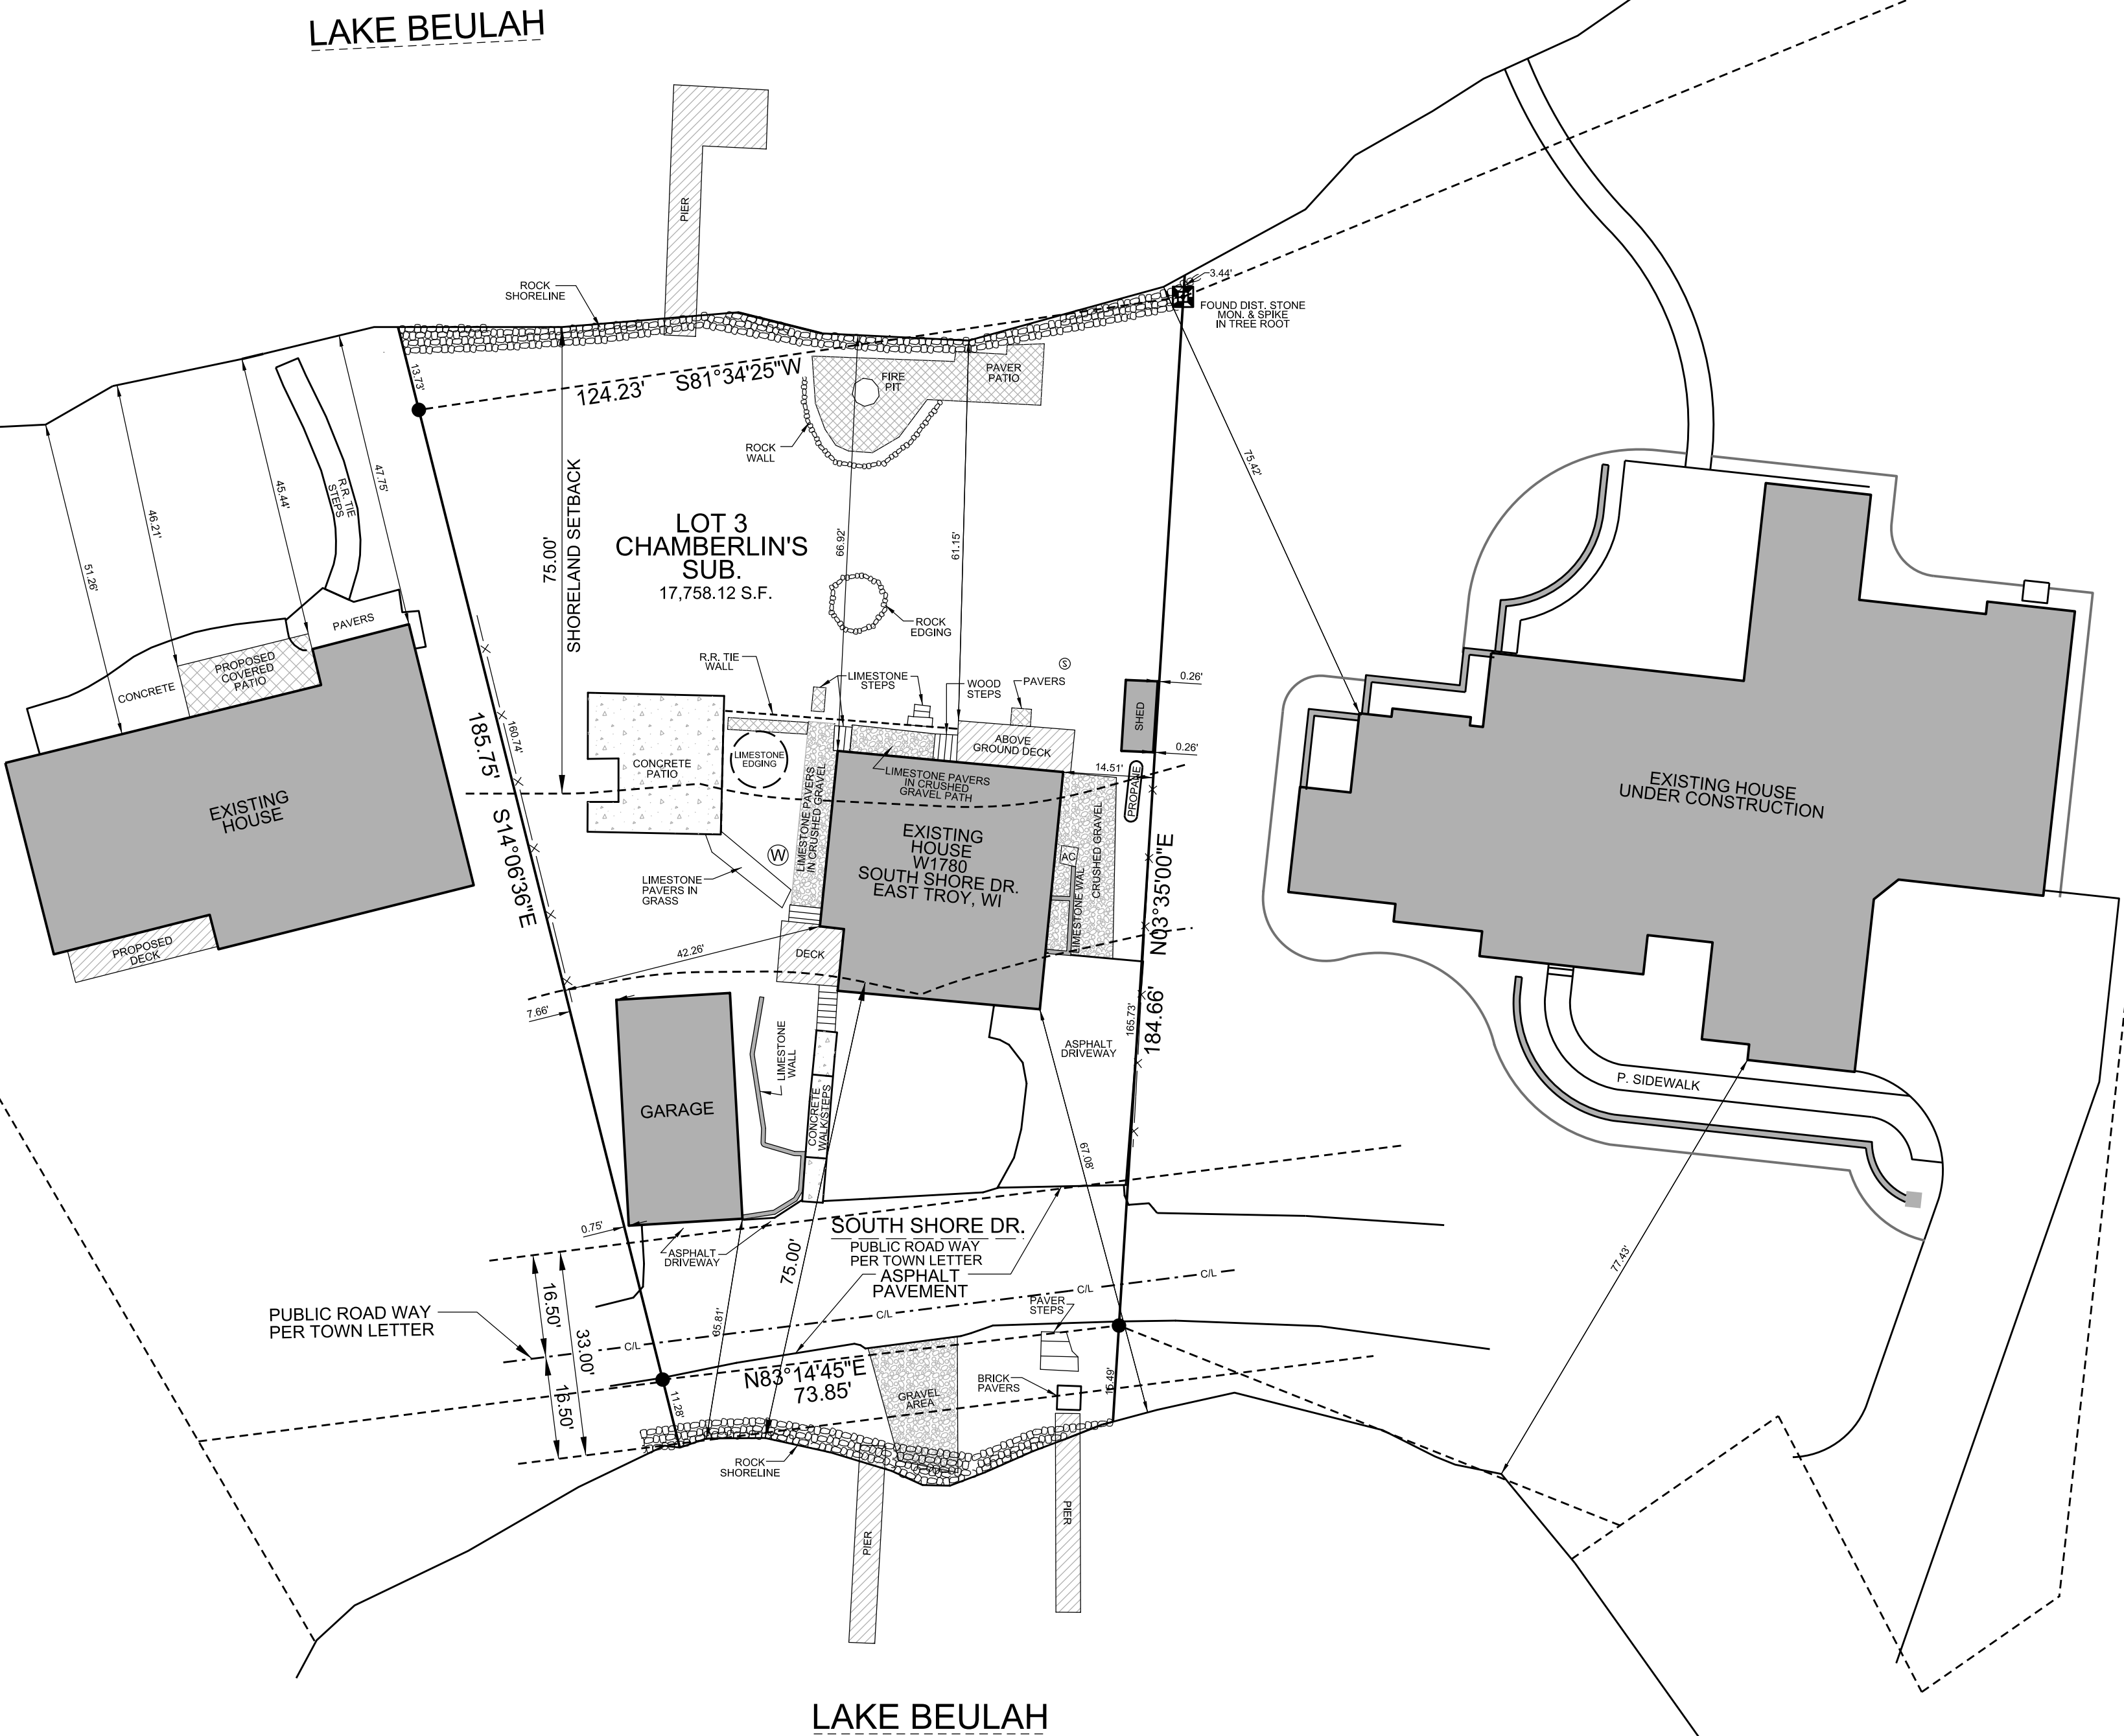

LEGEND:

(100.00') RECORDED DISTANCE

100.00' MEASURED DISTANCE

● 1" FOUND IRON PIPE, UNLESS NOTED

● SET 1" X 18" IRON PIPE WEIGHTING 1.13* PER FT.

⊙ SEPTIC TANK

⊙ SEPTIC VENT

⊙ POINT WELL

V²G
SURVEYING, LLC

123 WOLF RUIN - SUITE 4
MUKWONAGO, WI 53149
(262) 378-5097

DATE	ITEM
11/10/2021	ORIGINAL SURVEY

THIS SURVEY IS MADE FOR THE USE OF THE PRESENT OWNERS OF THE PROPERTY, AND ALSO THOSE WHO PURCHASE, MORTGAGE OR GUARANTEE TITLE TO WITHIN ONE (1) YEAR FROM DATE HERETO.

I, MICHAEL A. GREESON P.L.S. #2770, HEREBY CERTIFY THAT THIS SURVEY WAS MADE IN ACCORDANCE WITH THE MINIMUM STANDARDS FOR PROPERTY SURVEYS (CHAPTER A-E 7) FOR THE STATE OF WISCONSIN AND HAS BEEN PREPARED UNDER MY DIRECTION AND CONTROL AND IS CORRECT TO THE BEST OF MY KNOWLEDGE AND BELIEF.

WISCONSIN
MICHAEL A. GREESON
S-2770
EAST TROY
WIS.
LAND SURVEYOR

Michael A. Greeson

FILE NAME: 2021-161 ROB MILLER HOMES KENWY SURVEY-W1780 S SHORE DR.DGN