


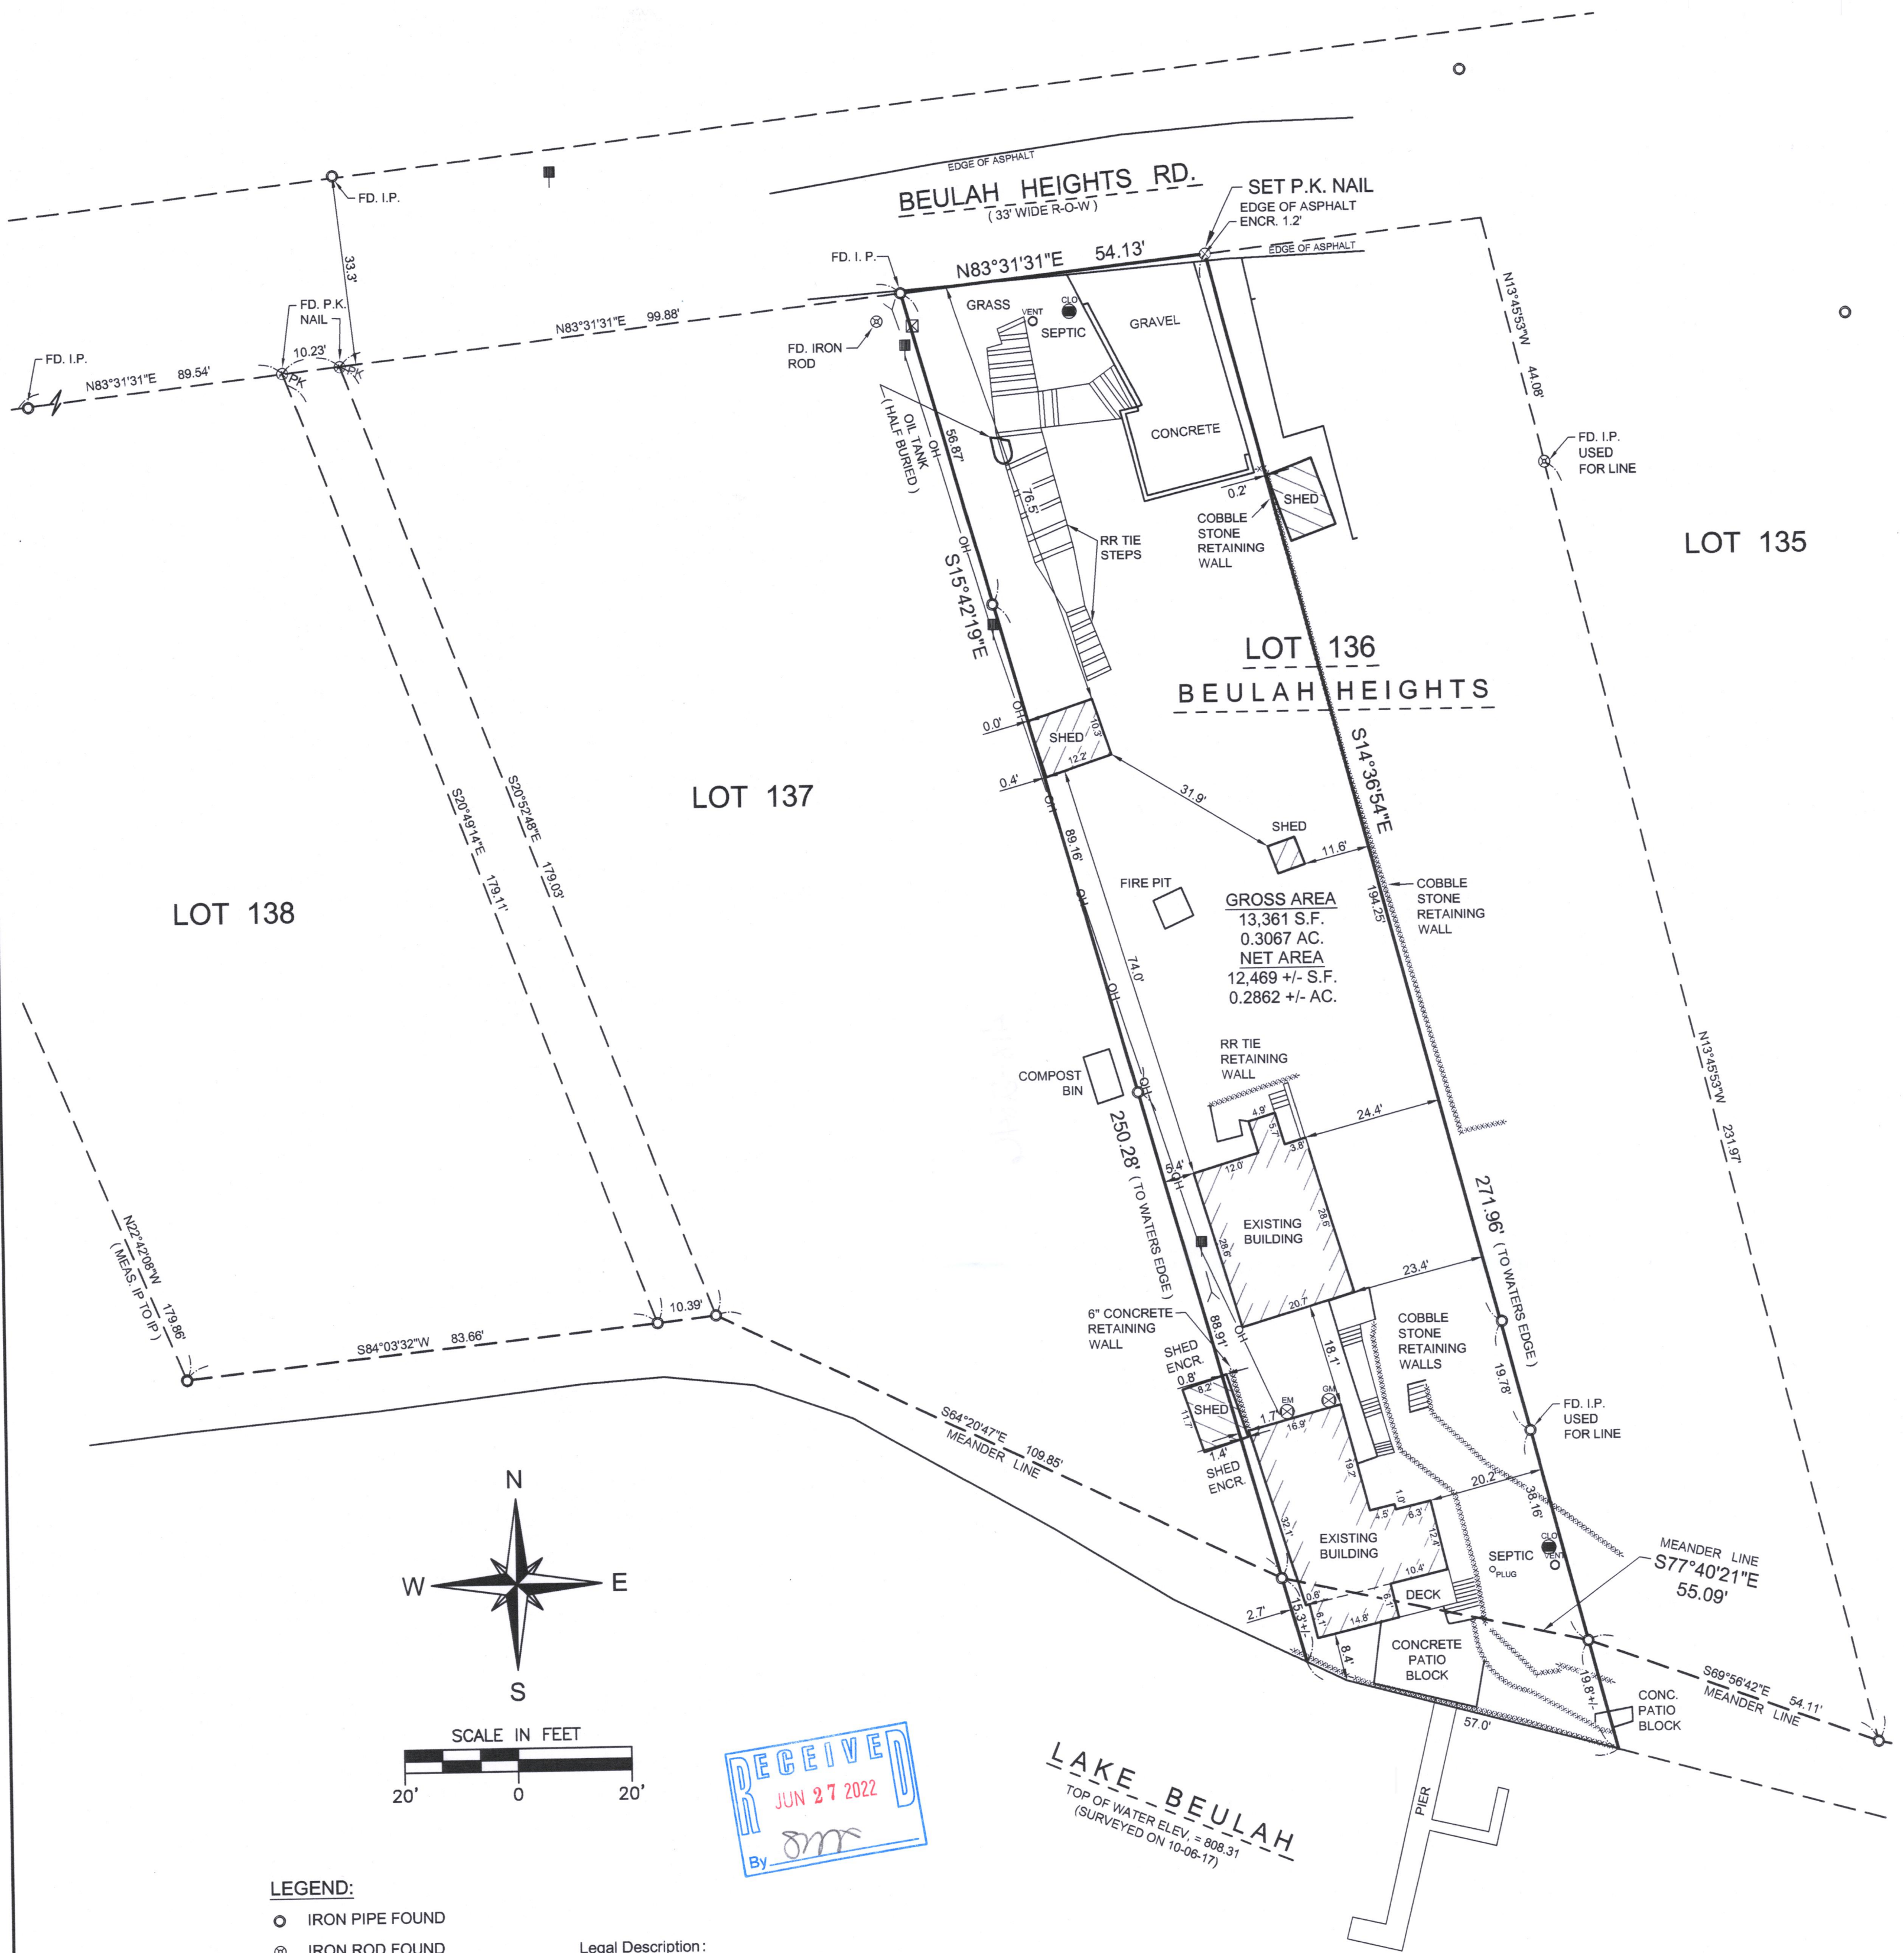

LEGEND:

- IRON PIPE FOUND
- ⊗ IRON ROD FOUND
- ⊗ P.K. NAIL
- EX. SEPTIC CLEAN OUT
- ⊗ EX. SEPTIC CLEAN OUT
- ⊗ EX. ELECTRIC METER
- ⊗ EX. SEPTIC VENT
- ⊗ EX. TELEPHONE PEDESTAL
- EX. POWER POLE
- EX. GUY WIRE
- OH — OH — EX. OVERHEAD WIRES
- ~~~~~ EX. RETAINING WALL

Legal Description:

The west 56 2/3 feet (56.67') of Lot 136 in BEULAH HEIGHTS being part of the Southeast 1/4 of Section 7, Southwest 1/4 of Section 8, Northeast 1/4 of Section 18 and the Northwest 1/4 of Section 17, Town 4 North, Range 18 East, in the Town of East Troy, Walworth County, Wisconsin.

Tax Key No. PBH 00019B
Address: W 2107 Beulah Heights Rd.

SURVEYOR'S CERTIFICATE

STATE OF WISCONSIN
COUNTY OF WAUKESHA

WE, JAHNKE & JAHNKE ASSOCIATES INC., DO HEREBY CERTIFY THAT WE HAVE MADE THIS SURVEY AND THAT THE INFORMATION AS SHOWN ON THE ABOVE PLAT OF SURVEY IS TRUE AND CORRECT REPRESENTATION THEREOF.

John R. Stigler
JOHN R. STIGLER, WIS. REG. NO. S-1820
Dated this 20th day of OCTOBER, 2017
Revised this 23th day of OCTOBER, 2017

NOTE:
NO TITLE POLICY WAS FURNISHED TO OUR OFFICE AT TIME OF SURVEY. THEREFORE THE COMPLETENESS OF EASEMENTS IS NOT GUARANTEED.

FOR: HENRI W. LABEAU 1993 TRUST

PLAT OF SURVEY
PART OF THE SE 1/4 OF SECTION 7 &
THE NE 1/4 OF SECTION 18, T 4 N, R 18 E,
TOWN OF EAST TROY, WALWORTH COUNTY, WISCONSIN.

JAHNKE & JAHNKE ASSOCIATES INC.

PLANNERS & PROFESSIONAL ENGINEERS

711 W. MORELAND BLVD., WAUKESHA, WI. 53188

TEL.No.(262)542-5797 FAX(262)542-7698 (E-MAIL jstigler@jahnkeandjahnke.com)

SCALE: 1" = 20'	DATE: OCTOBER 20, 2017
DRAWN BY: D.L.F.	CHECKED BY: J.R.S.
BOOK: WALWORTH 13, PG 21	JOB: 17-09-106
SHEET 1 OF 1	

If this seal is not red in color, this plan is a copy that should be assumed to contain unapproved alterations. The certification contained on this document shall not apply to any copy.

PBH-19B

418-2046