

# PLAT OF SURVEY


**LOCATION:** Troy Hill Lane, East Troy, Wisconsin

**LEGAL DESCRIPTION:**

Lot 41 in **TROY HILL ESTATES**, part of the Northwest 1/4, Northeast 1/4, Southwest 1/4, and Southeast 1/4 of the Southwest 1/4 of Section 30, Town 4 North, Range 18 East, in the Town of East Troy, Walworth County, Wisconsin.

June 8, 2021

Survey No. 113188-S

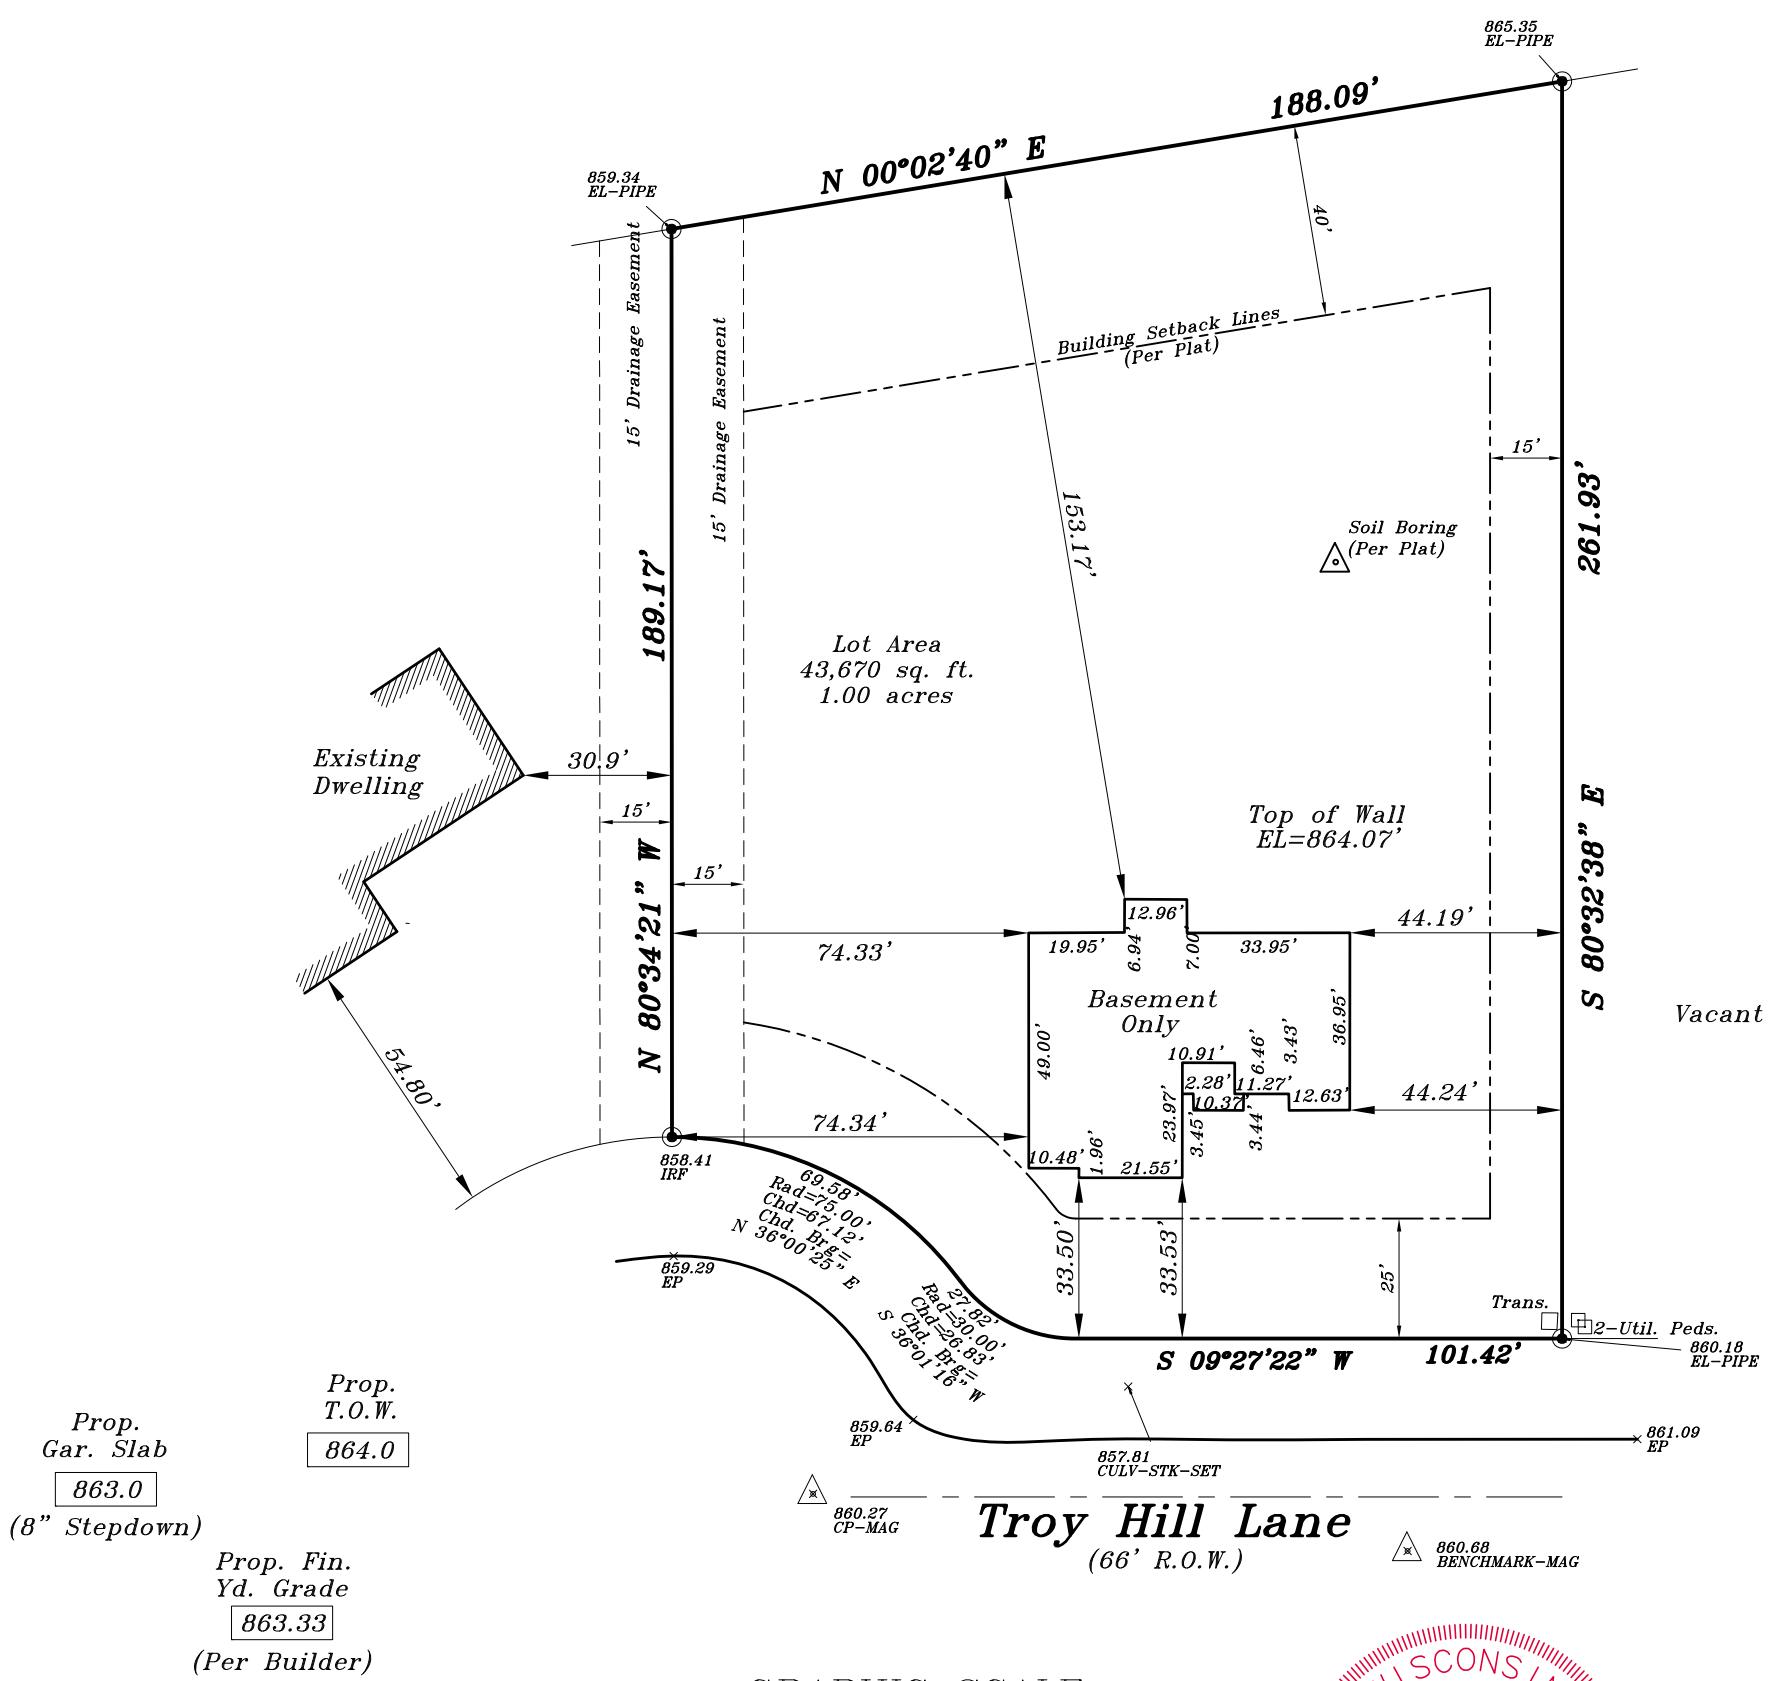

*Proposed finished yard, 1st floor or top of foundation grade shown on this drawing is a suggested grade and should be verified by the owner, builder or municipality*

# METROPOLITAN SURVEY SERVICE, INC.

## PROFESSIONAL LAND SURVEYORS

**9415 West Forest Home Avenue, Suite 202**

**Hales Corners, Wisconsin 53130**

PH. (414) 529-5380

**survey@metropolitansurvey.com**  
**www.metropolitansurvey.com**

— Denotes Iron Pipe Found

- — Denotes Iron Pipe Found
- — Denotes Iron Pipe Set

**000.0** = Denotes Proposed Grade

**000.0** Denotes Proposed Grade

I HEREBY CERTIFY THAT I HAVE SURVEYED THE ABOVE DESCRIBED PROPERTY AND THAT THE ABOVE MAP IS A TRUE REPRESENTATION THEREOF AND SHOWS THE SIZE AND LOCATION OF THE PROPERTY, ITS EXTERIOR BOUNDARIES, THE LOCATION OF ALL VISIBLE STRUCTURES AND DIMENSIONS OF ALL PRINCIPAL BUILDINGS THEREON, BOUNDARY FENCES, APPARENT EASEMENTS AND ROADWAYS AND VISIBLE ENCROACHMENT, IF ANY.

**THIS SURVEY IS MADE FOR THE EXCLUSIVE USE OF THE PRESENT OWNERS OF THE PROPERTY,  
AND ALSO THOSE WHO PURCHASE, MORTGAGE, OR GUARANTEE THE TITLE THERETO WITHIN  
ONE (1) YEAR FROM THE DATE HEREOF.**

**SIGNED**

**Dennis C. Sauer**  
Professional Land Surveyor S-2421