


Plat of Survey

Known as Harmony Lane, in the Town of East Troy, Wisconsin
 Lot 34 in MIRAMAR ADDITION NO. 2, being a Subdivision of a part of the NE 1/4 of
 Section 10 and the NW 1/4 of Section 11, T 4 N, R 18 E, in the Town of East Troy
 Walworth County, Wisconsin

OCTOBER 18, 1976

SURVEY NO. 139296-M

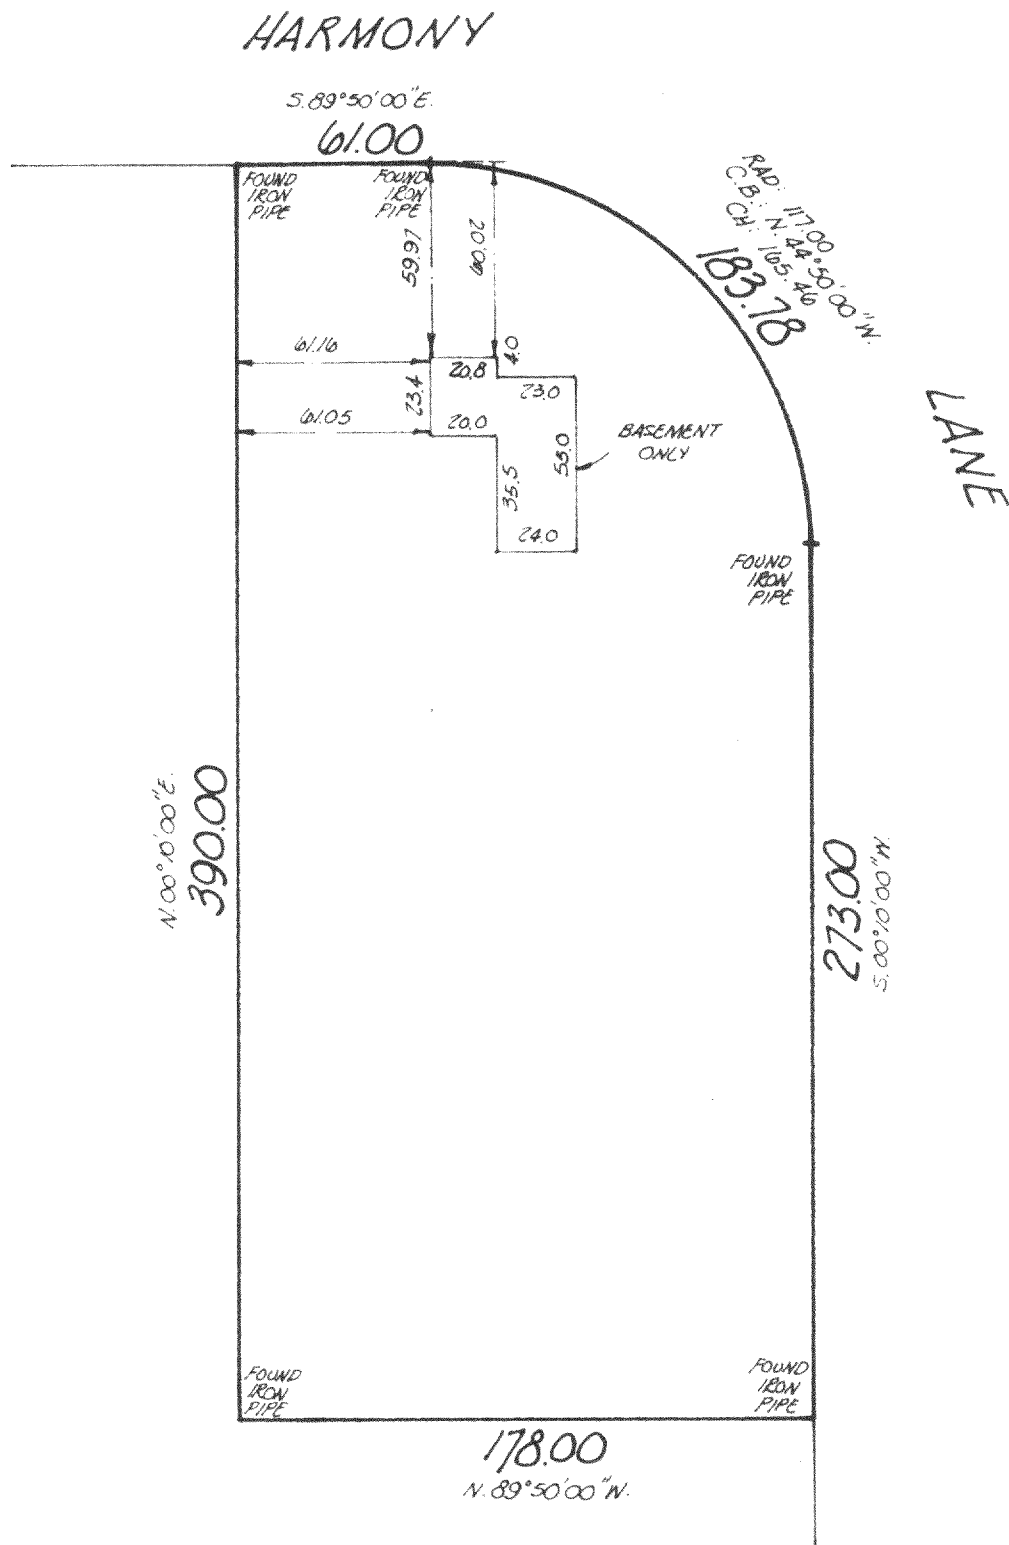


SCALE 1" = 60'

I Certify that I have surveyed the above described property (Property), and the above map is a true representation thereof and shows the size and location of the Property, its exterior boundaries, the location and dimensions of all visible structures thereon, fences, apparent easements and roadways and visible encroachments, if any.

This survey is made for the exclusive use of the present owners of the Property, and also those who purchase, mortgage, or guarantee the title thereto, within one (1) year from date hereof.

NATIONAL SURVEY SERVICE, INC.
 CIVIL ENGINEERS AND LAND SURVEYORS
 3470 NORTH 127th STREET (414) 781-1000
 P. O. BOX 444
 BROOKFIELD, WISCONSIN 53005

Kenneth E. Berke
 SURVEYOR

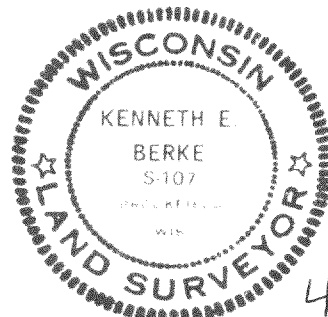

PMR2-34

418-291