



TAX KEY No. PBL 00002
LOT 1, EXCEPTING THE NORTHERLY 20 FEET THEREOF AND ALSO EXCEPTING THE SOUTHERLY 20 FEET THEREOF, BEULAH LAKE PARK SUBDIVISION. A SUBDIVISION LOCATED IN THE SOUTHWEST ¼ OF SECTION 4, TOWNSHIP 4 NORTH, RANGE 18 EAST, TOWN OF EAST TROY, WALWORTH COUNTY, WISCONSIN.

TAX KEY No. PBL 00003
THE SOUTHERLY 30 FEET OF LOT 1 AND THE NORTHERLY 35 FEET OF LOT 2 BEULAH LAKE
PARK SUBDIVISION. A SUBDIVISION LOCATED IN THE SOUTHEAST 1/4 OF SECTION 4,
TOWNSHIP 4 NORTH, RANGE 18 EAST, TOWN OF EAST TROY, WALWORTH COUNTY, WISCONSIN.

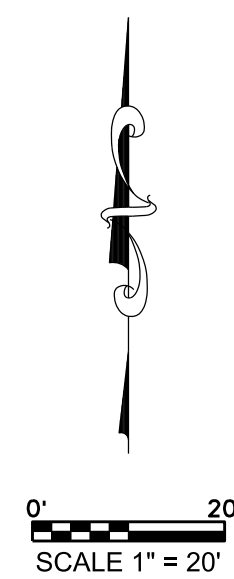

(100.00')	RECORDED DISTANCE
100.00'	MEASURED DISTANCE
●	1" FOUND IRON PIPE, UNLESS NOTED
⌀	¾" x 18" IRON PIPE SET, 1.13 lbs./L.F.
△ _W	WELL
Ⓢ	SEPTIC TANK
Ⓢ	SEPTIC VENT
⊗	LIGHT POLE
ⓔ	ELECTRIC TRANSFORMER
ⓔ	ELECTRIC PEDESTAL
Ⓣ	TELEPHONE PEDESTAL
Ⓣ	CABLE TV PEDESTAL

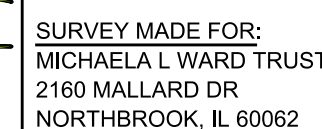

DATE	ITEM
05/19/2023	PLAT OF SURVEY

THIS SURVEY IS MADE FOR THE USE OF THE PRESENT OWNERS
OF THE PROPERTY, AND ALSO THOSE WHO PURCHASE, MORTGAGE
OR GUARANTEE TITLE TO WITHIN ONE (1) YEAR FROM DATE HERETO.

I, MICHAEL A. GREESON P.L.S. #2770, HEREBY CERTIFY THAT THIS SURVEY WAS MADE IN ACCORDANCE WITH THE MINIMUM STANDARDS FOR PROPERTY SURVEYS (CHAPTER A-6.7) FOR THE STATE OF WISCONSIN AND HAS BEEN PREPARED UNDER MY DIRECTION AND CONTROL AND IS CORRECT TO THE BEST OF MY KNOWLEDGE AND BELIEF.

