


FILE NAME: 2023-059 BUNZEL SURVEY W389 CTH L.DGN

PLOT DATE: 08/28/2023

V2G JOB*: 2023-059

PLAT OF SURVEY

LOT 3, BLOCK 2 OF LAKE BEULAH SUBDIVISION, LOCATED
IN SECTION 12, TOWN 4 NORTH, RANGE 18 EAST,
TOWN OF EAST TROY, WALWORTH COUNTY, WISCONSIN.

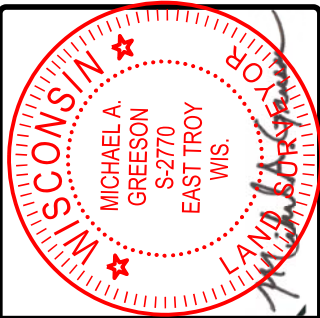

THIS SURVEY IS MADE FOR THE USE OF THE PRESENT OWNERS
OF THE PROPERTY, AND ALSO THOSE WHO PURCHASE, MORTGAGE
OR GUARANTEE TITLE TO WITHIN ONE (1) YEAR FROM DATE HERETO.

I, MICHAEL A. GREESON P.L.S. #2770, HEREBY CERTIFY THAT THIS
SURVEY WAS MADE IN ACCORDANCE WITH THE MINIMUM STANDARDS
FOR PROPERTY SURVEYS (CHAPTER A-E 7) FOR THE STATE OF WISCONSIN
AND HAS BEEN PREPARED UNDER MY DIRECTION AND CONTROL AND IS
CORRECT TO THE BEST OF MY KNOWLEDGE AND BELIEF.



SURVEY MADE FOR:
EVERETT BUNZEL
W389 CTH L
EAST TROY, WI 53120

DATE	ITEM
08/28/2023	PLAT OF SURVEY



V²G
SURVEYING, LLC

123 WOLF RUN - SUITE 4
MUKWONAGO, WI 53149
(262) 378-5097

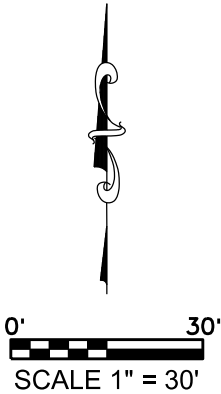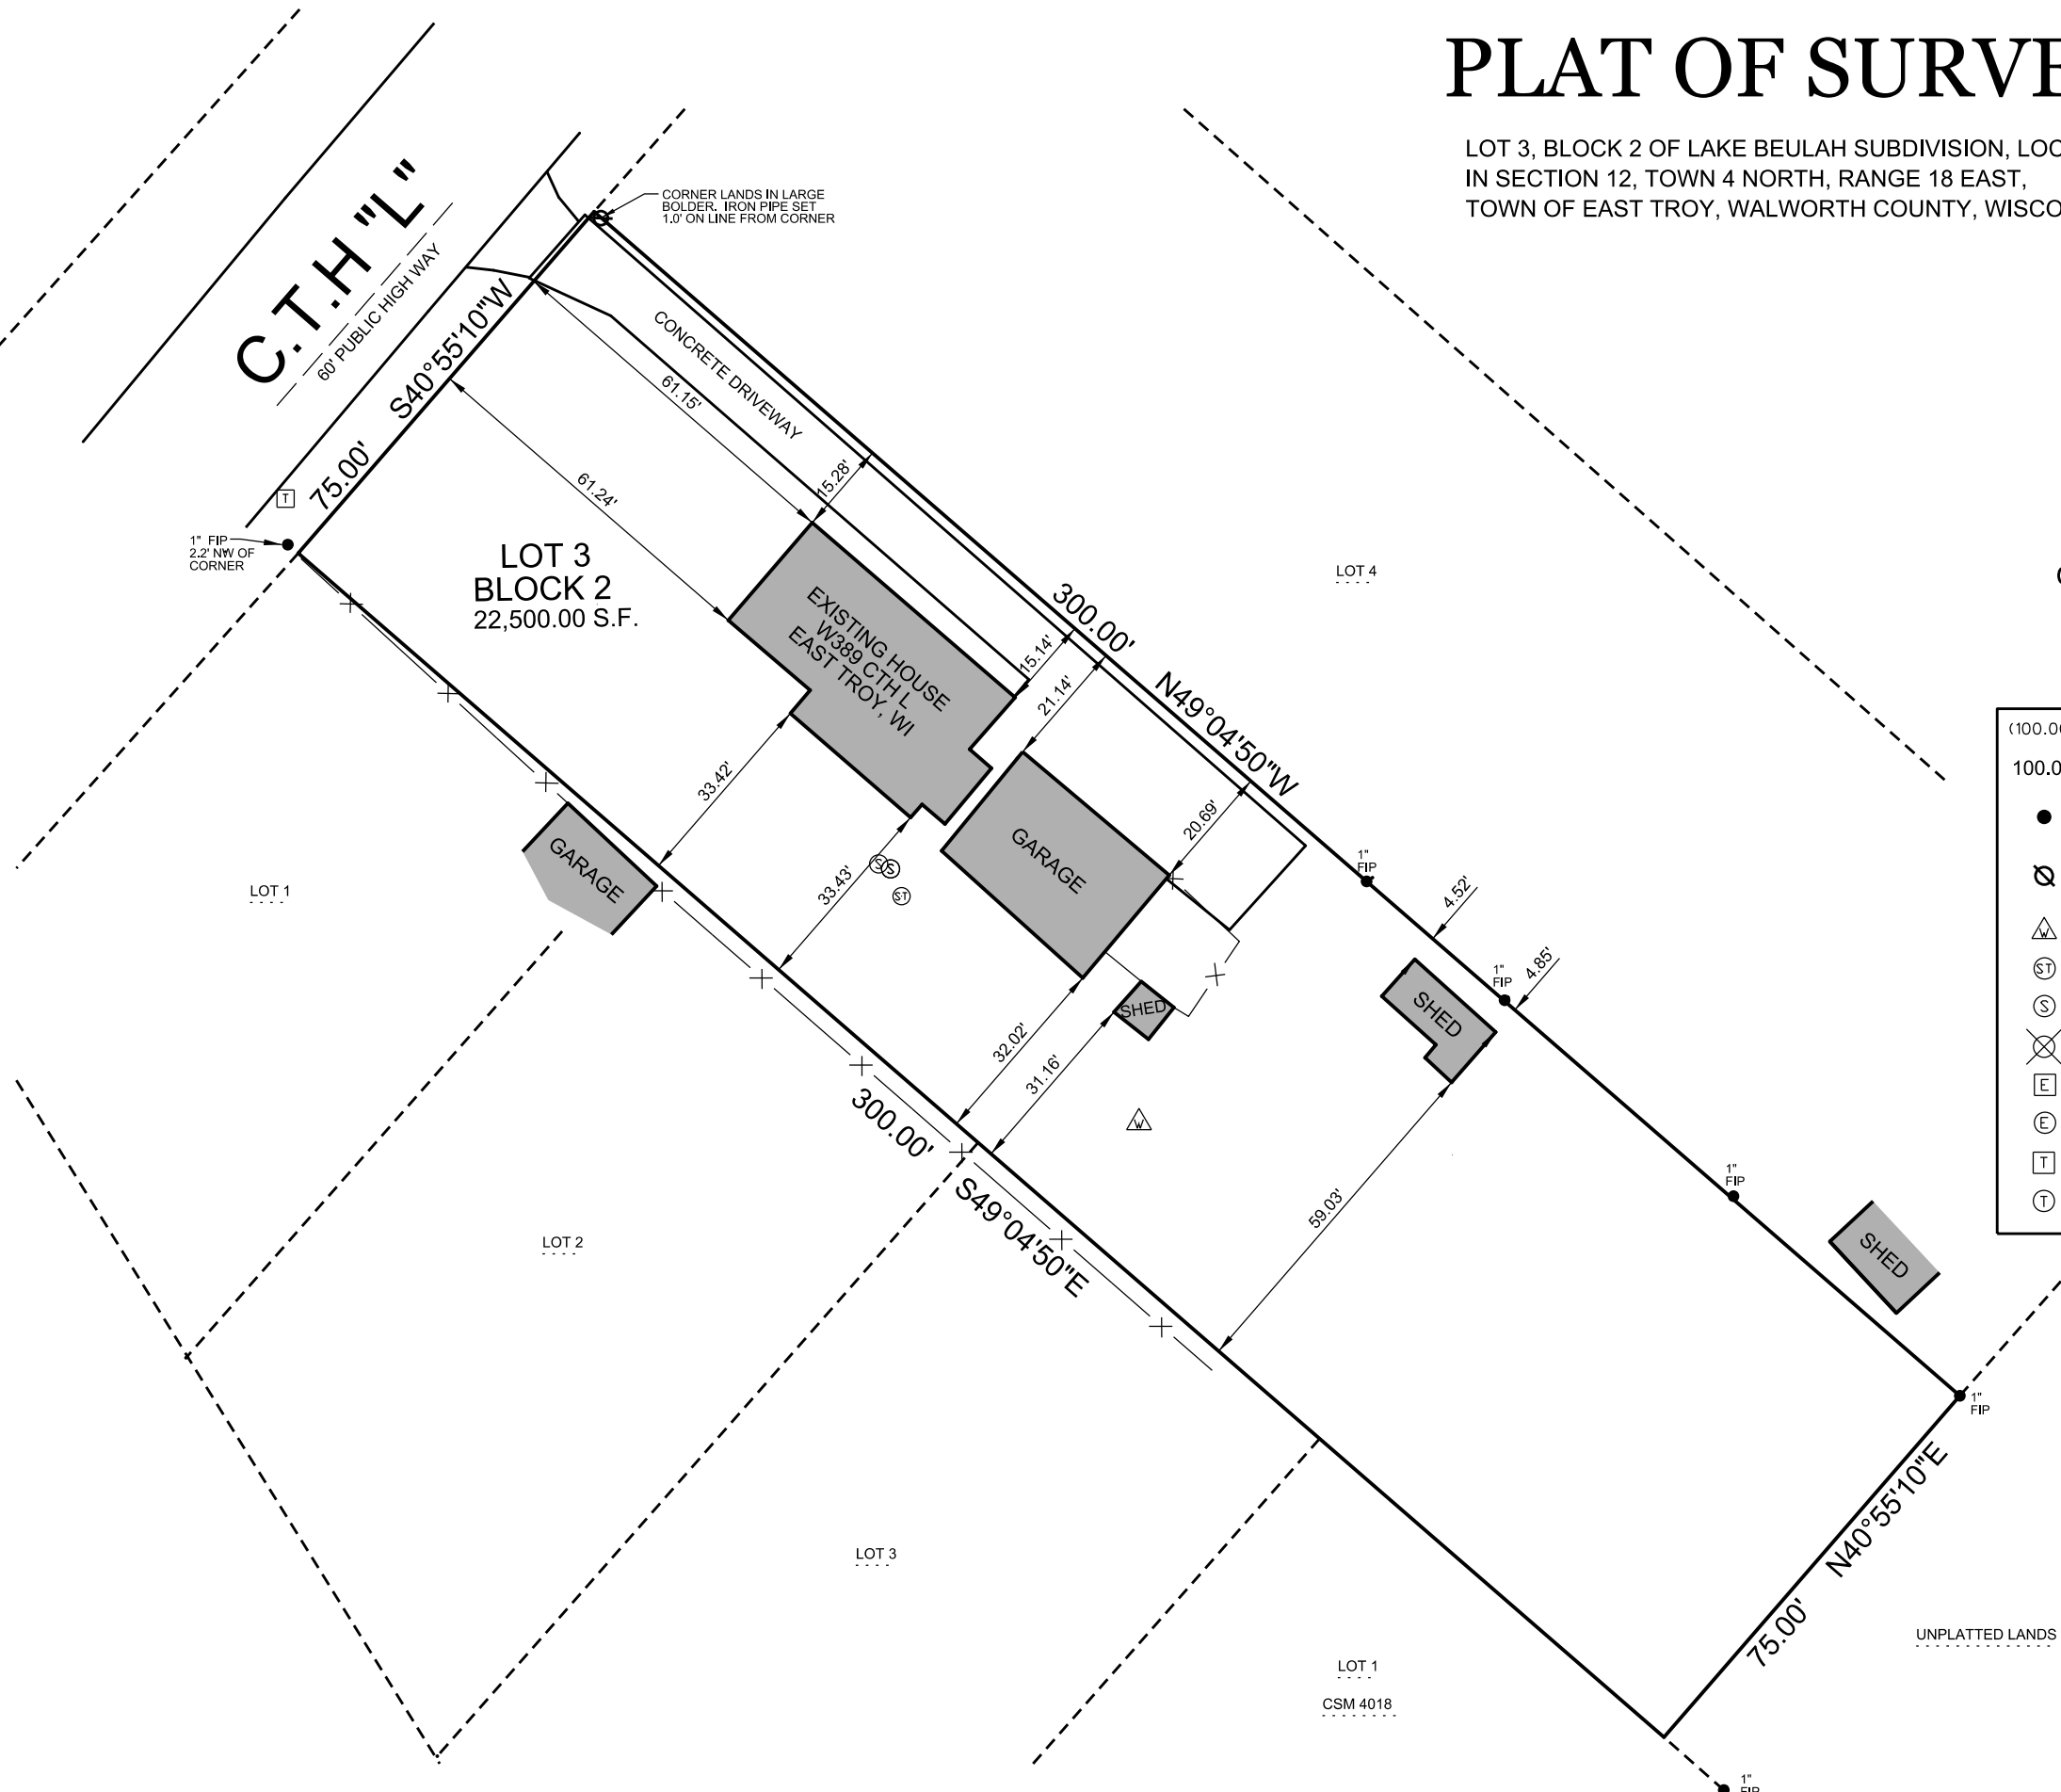

LEGEND:

(100.00') RECORDED DISTANCE
100.00' MEASURED DISTANCE

- 1" FOUND IRON PIPE, UNLESS NOTED
- 3/4" x 18" IRON PIPE SET, 1.13 lbs./L.F.
- WELL
- SEPTIC TANK
- SEPTIC VENT
- LIGHT POLE
- ELECTRIC TRANSFORMER
- ELECTRIC PEDESTAL
- TELEPHONE PEDESTAL
- CABLE TV PEDESTAL