



PLAT OF SURVEY

LOT 35, BLOCK 1 OF WILMERS GROVE BEACH SUBDIVISION, LOCATED IN THE EAST 1/2 OF SECTION 18, TOWNSHIP 4 NORTH, RANGE 18 EAST, WALWORTH COUNTY, WISCONSIN.

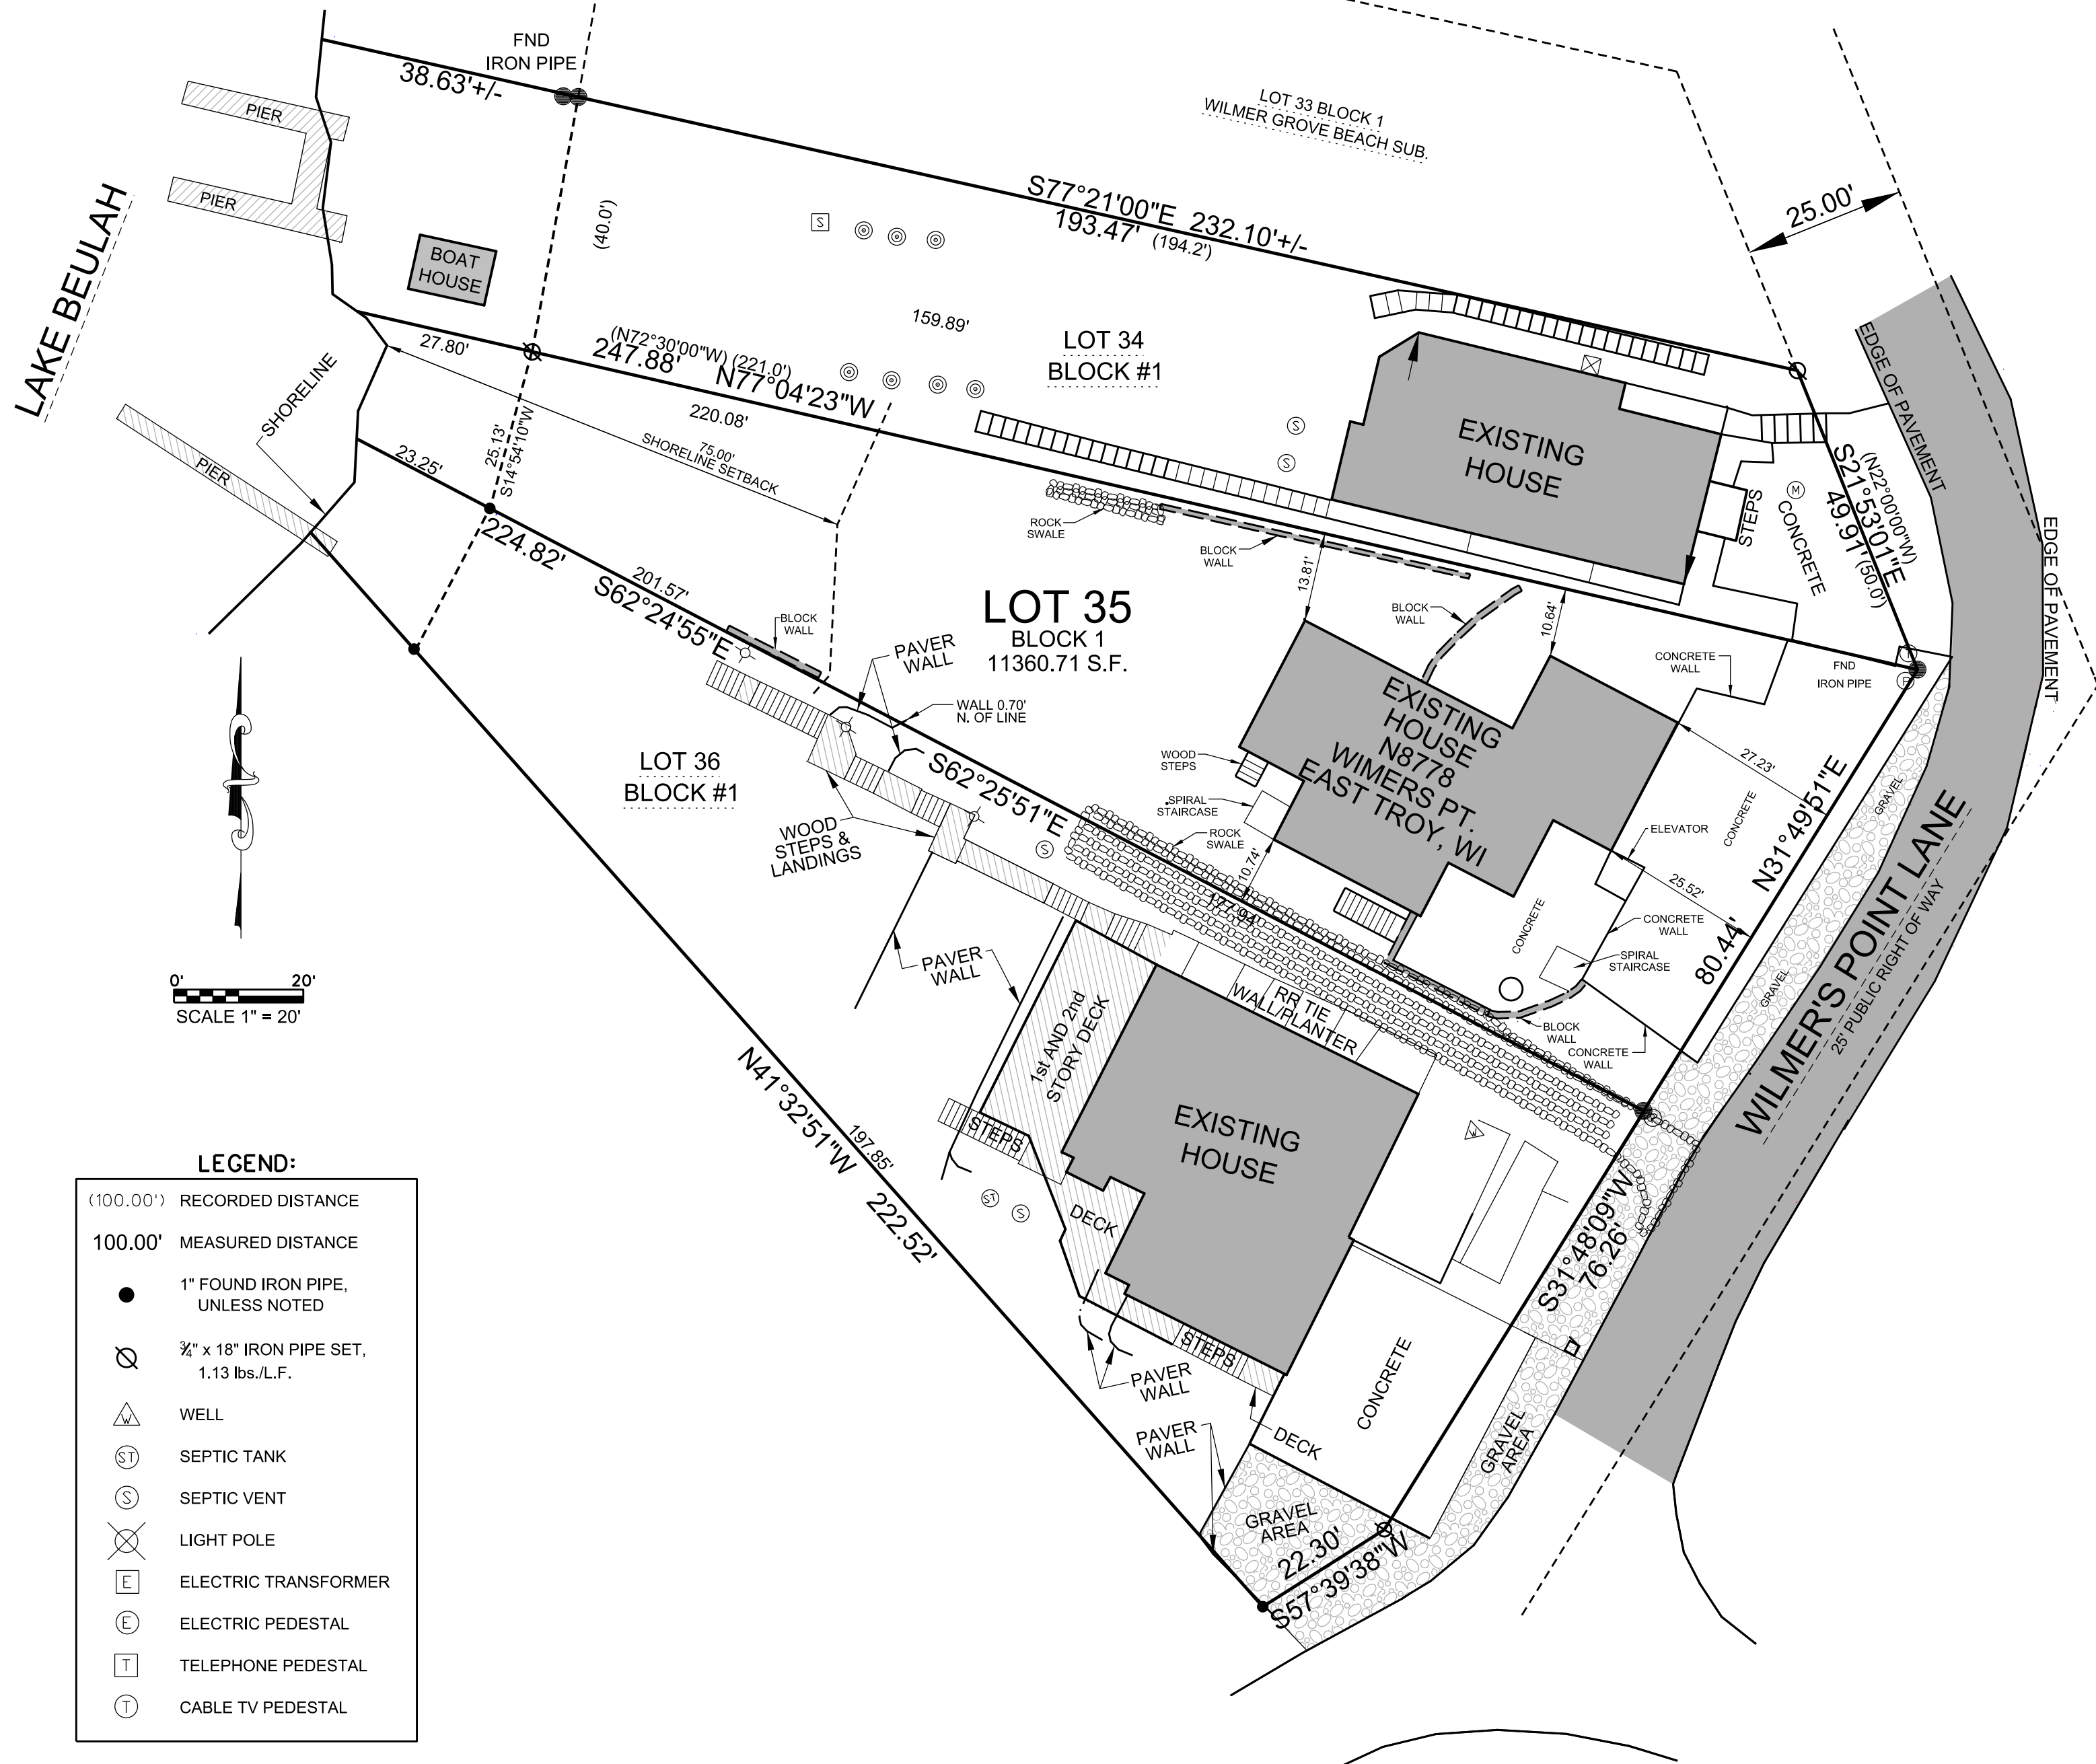

LEGEND:

- (100.00') RECORDED DISTANCE
- 100.00' MEASURED DISTANCE
- 1" FOUND IRON PIPE, UNLESS NOTED
- ⊗ 3/4" x 18" IRON PIPE SET, 1.13 lbs./L.F.
- ⚡ WELL
- ⊙ SEPTIC TANK
- ⊙ SEPTIC VENT
- ⊗ LIGHT POLE
- ⊞ ELECTRIC TRANSFORMER
- ⊞ ELECTRIC PEDESTAL
- ⊞ TELEPHONE PEDESTAL
- ⊞ CABLE TV PEDESTAL

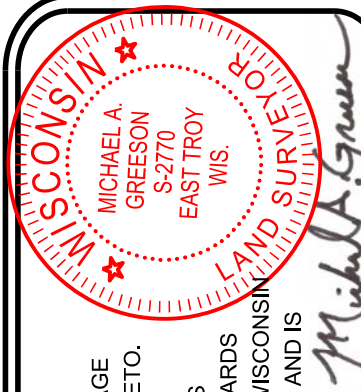

THIS SURVEY IS MADE FOR THE USE OF THE PRESENT OWNERS OF THE PROPERTY, AND ALSO THOSE WHO PURCHASE, MORTGAGE OR GUARANTEE TITLE TO WITHIN ONE (1) YEAR FROM DATE HERETO.

I, MICHAEL A. GREESON P.L.S. #2770, HEREBY CERTIFY THAT THIS SURVEY WAS MADE IN ACCORDANCE WITH THE MINIMUM STANDARDS FOR PROPERTY SURVEYS (CHAPTER A-E 7) FOR THE STATE OF WISCONSIN AND HAS BEEN PREPARED UNDER MY DIRECTION AND CONTROL AND IS CORRECT TO THE BEST OF MY KNOWLEDGE AND BELIEF.

Michael A. Greeson

SURVEY MADE FOR:
 ROBERT SIEGEL
 WENDY SIEGEL
 N8778 WILMERS POINT LN
 EAST TROY WI 53120

DATE	ITEM
06/01/2023	PLAT OF SURVEY

V²G
 SURVEYING, LLC
 123 WOLF RUN - SUITE 4
 MUKWONAGO, WI 53149
 (262) 378-5097