


PLAT OF SURVEY

LOTS 16 AND 17, BLOCK 12, IN MIRAMAR SUBDIVISION, BEING A PART OF THE EAST 1/2 OF SECTION 10, AND THE WEST 1/2 OF SECTION 11, TOWN 4 NORTH, RANGE 18 EAST, TOWN OF EAST TROY, WALWORTH COUNTY, WISCONSIN.

SURVEYED FOR: KURT RATH
SURVEY ADDRESS: N9169 HICKORY STREET

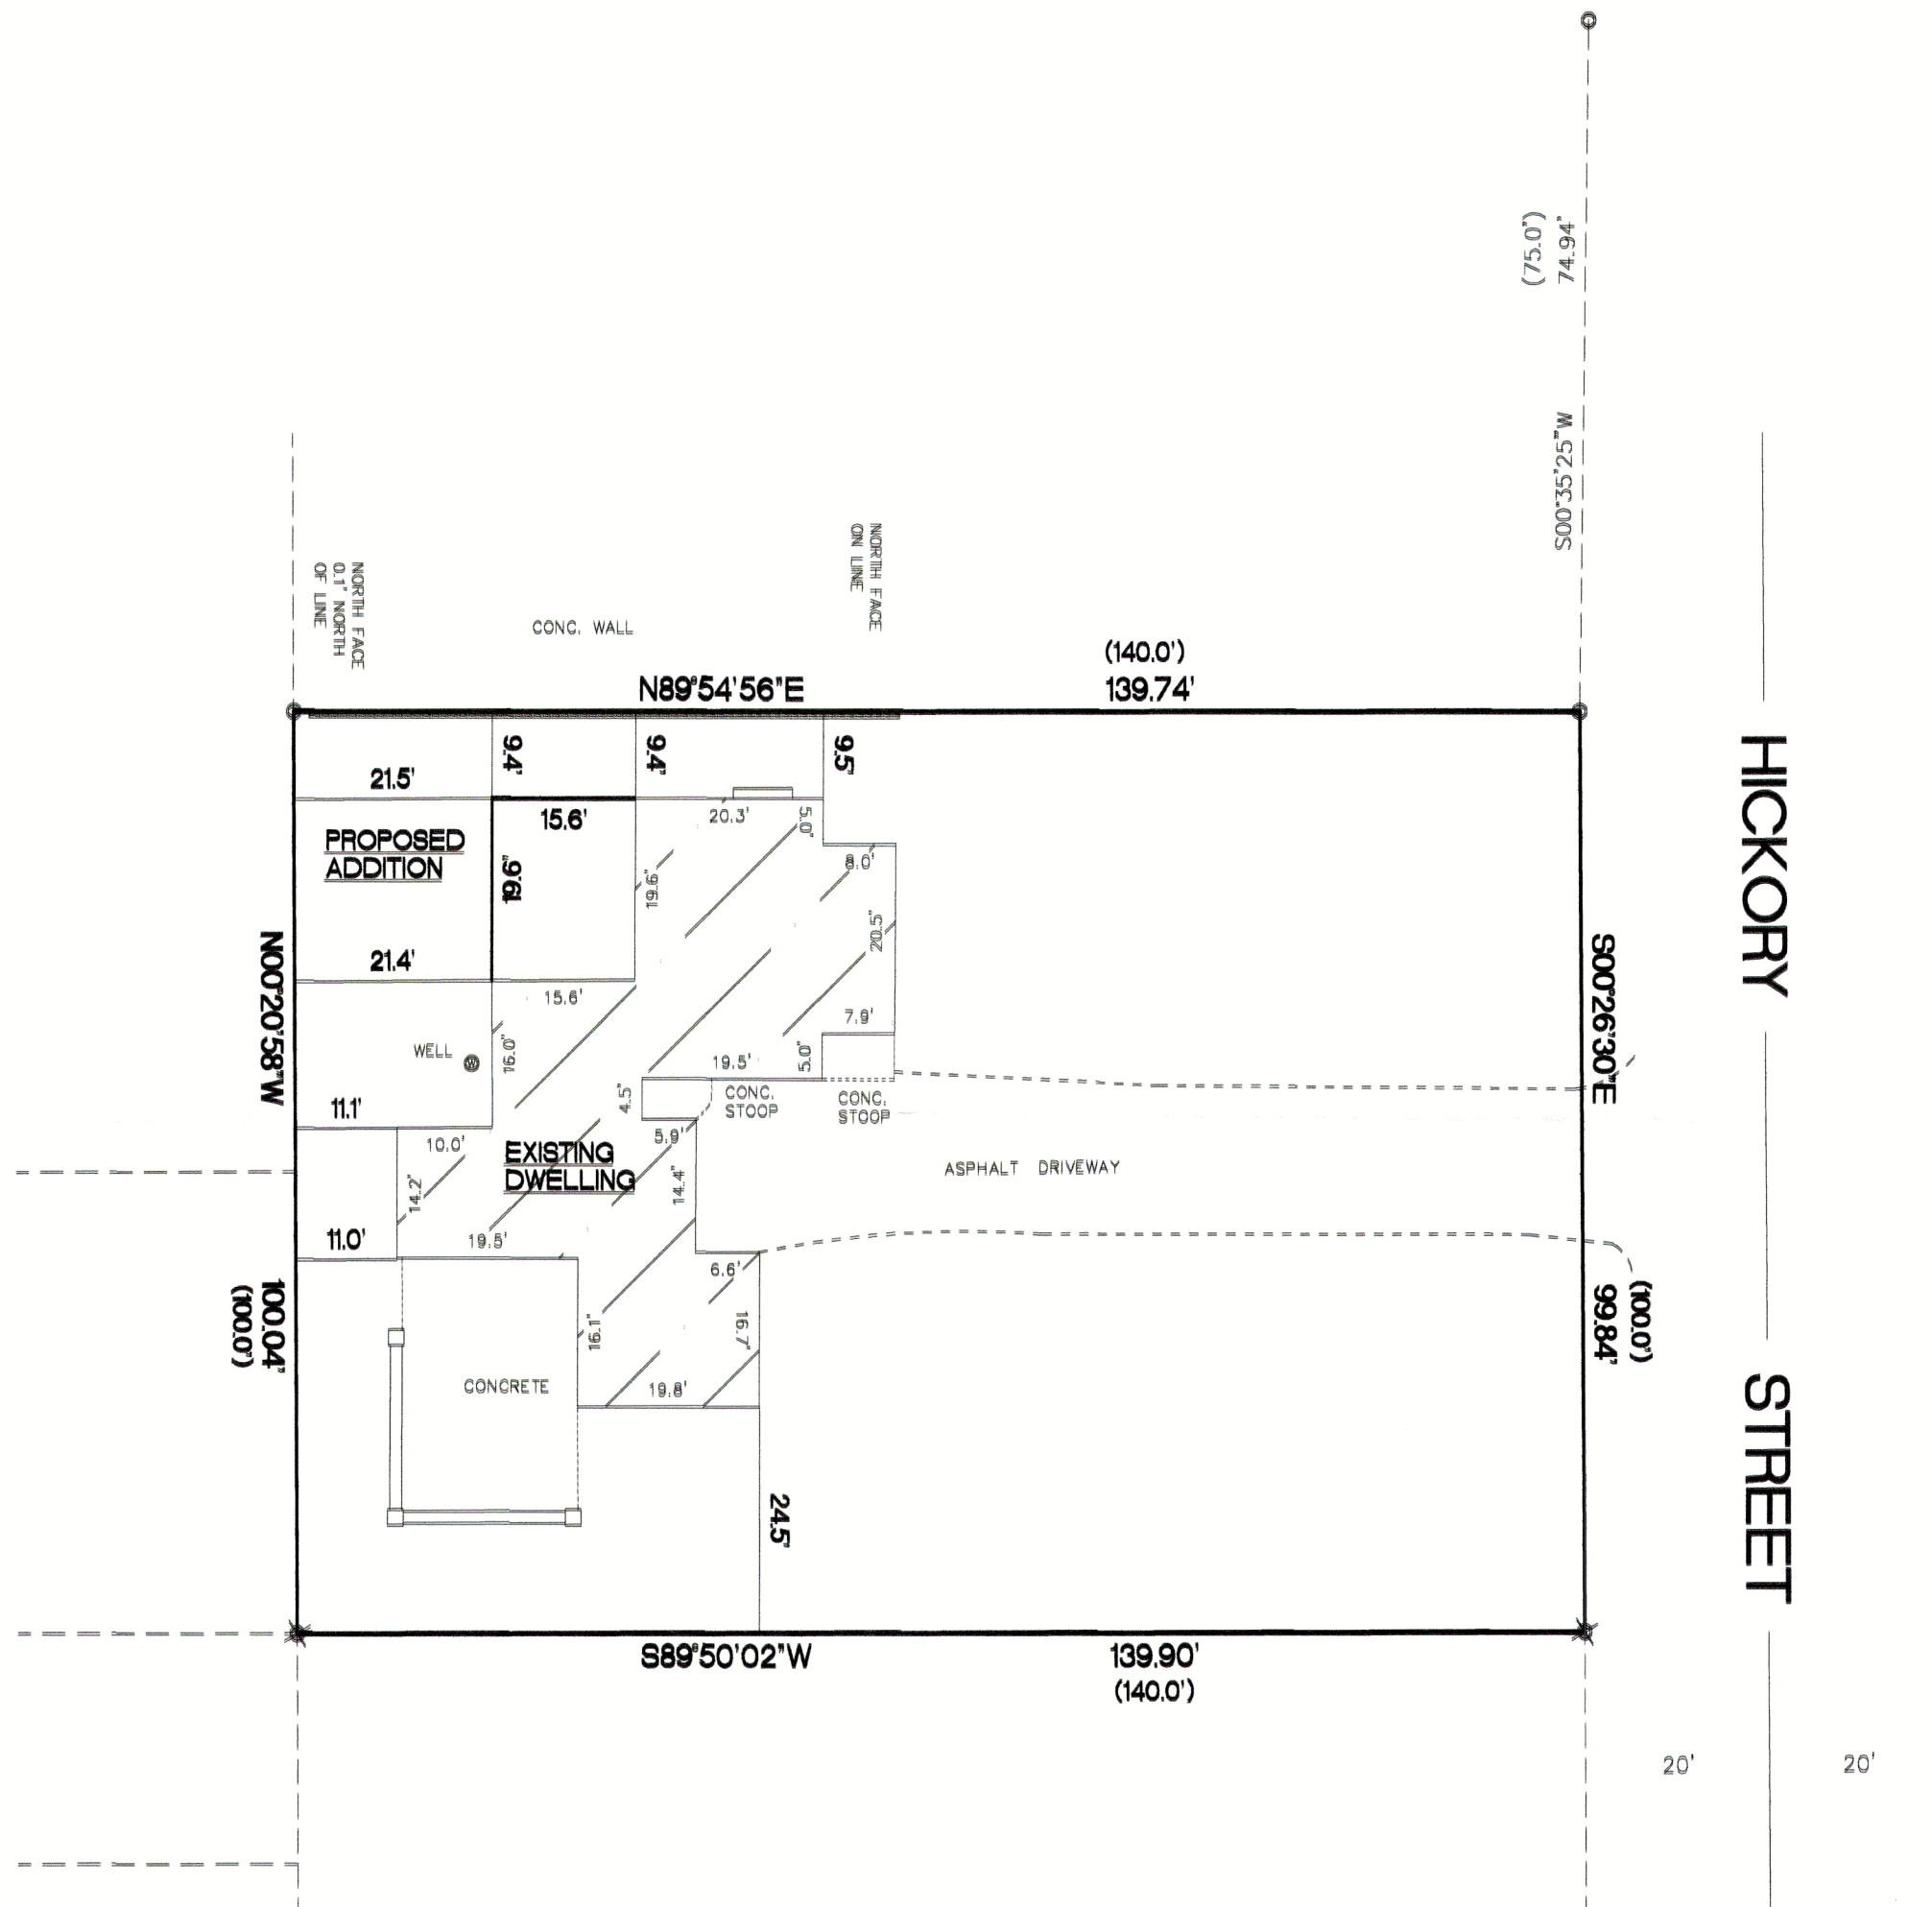

SCALE 1"=20'



BEARINGS ARE REFERENCED TO THE EAST LINE OF THE NORTHEAST 1/4 OF SECTION 10-4-18 AND IS ASSUMED TO BEAR N00°15'42"W, (NAD83).

- FOUND 1 1/4" O.D. IRON PIPE
- ✱ FOUND 1" O.D. IRON PIPE
- () RECORDED AS DIMENSIONS




418-2946

"I hereby certify that I have surveyed the above property and that the above map is a true representation thereof and shows the size and location of the property, its exterior boundaries, the location of all visible structures and dimensions of all principal buildings thereon, boundary fences, apparent easements, roadways and encroachments if any."

"This survey is made for the use of the present owners of the property, and also those who purchase, mortgage or guarantee the title thereto within one year from date hereof."

Kettle Moraine Surveying Inc.
P.O. Box 957
Eagle WI. 53119
(262)594-3484

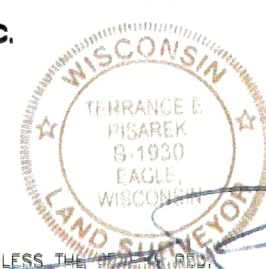

THIS IS NOT AN ORIGINAL SURVEY UNLESS THE SIGNATURE IS PRESENT

3/13/2024
DATE

TEP
FIELD WORK BY

TEP
DRAWN BY

24022
JOB NUMBER