
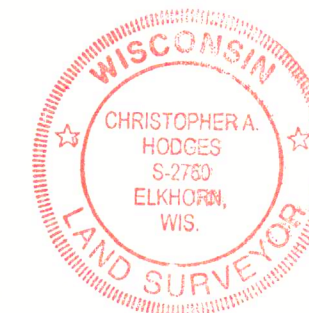
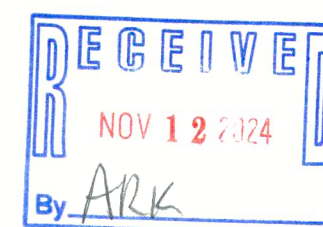
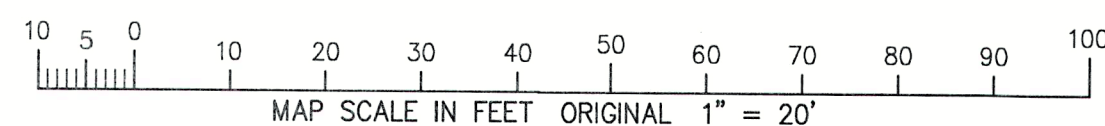


PLAT OF SURVEY
LOT 11 SPLEAS SUBDIVISION
PART OF SECTION 10
TOWN 4 NORTH, RANGE 18 EAST
WALWORTH COUNTY, WISCONSIN

LEGEND
○ = FOUND IRON PIPE STAKE
□ = FOUND CONCRETE MONUMENT
● = SET IRON REBAR STAKE
(xxx) = RECORDED AS

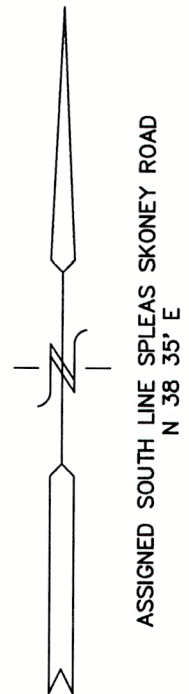


NOTE: COPIES OF THIS MAP TO WHICH THE FOLLOWING CERTIFICATE WILL APPLY SHOW SURVEYOR'S ORIGINAL SEAL AND SIGNATURE IN RED INK. COPIES BY ANY OTHER MEANS MAY HAVE ALTERATIONS WHICH DO NOT REPRESENT THE SURVEYOR'S WORK PRODUCT.

I HEREBY CERTIFY THAT THE ABOVE DESCRIBED PROPERTY HAS BEEN SURVEYED UNDER MY DIRECTION AND THAT THE ABOVE MAP IS A TRUE REPRESENTATION THEREOF AND SHOWS THE SIZE AND LOCATION OF THE PROPERTY AND ITS EXTERIOR BOUNDARIES. THIS SURVEY IS MADE FOR THE USE OF THE PRESENT OWNERS OF THE PROPERTY, AND ALSO THOSE WHO PURCHASE, MORTGAGE, OR GUARANTEE THE TITLE THERETO WITHIN ONE YEAR FROM THE DATE HEREOF.

DATED: 7/10/2024

CHRISTOPHER A. HODGES P.L.S. 2760

7/10/2024 - REVISED A PLAT OF SURVEY PREPARED BY PETER S. GORDON AND DATED 1/4/2002 TO SHOW GARAGE AS BUILT AND LOCATED 5/21/2024.

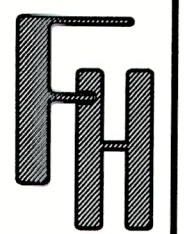

WORK ORDERED BY:
TOM SCHULTZ
1071 SPLEAS SKONEY ROAD
EAST TROY, WI 53120

FARRIS, HANSEN & ASSOCIATES, INC.
Engineering, Architecture, Surveying
7 Ridgeway Court P.O. Box 437
ELKHORN, WISCONSIN 53121
Office: (262) 723-2098
e-mail: office@farris-hansen.com

REVISIONS
08/17/2002-
PROPOSED
MISC. ADDED

PROJECT NO.
5945
DATE:
01-02-02
SHEET NO.
1 OF 1