



PLAT OF SURVEY

FOR LOT 3 OF CERTIFIED SURVEY MAP NO. 4351, AND BEING A PART OF
GOVERNMENT LOT 3 OF SECTION 9, TOWN 4 NORTH, RANGE 18 EAST,
TOWN OF EAST TROY, WALWORTH COUNTY, WISCONSIN.

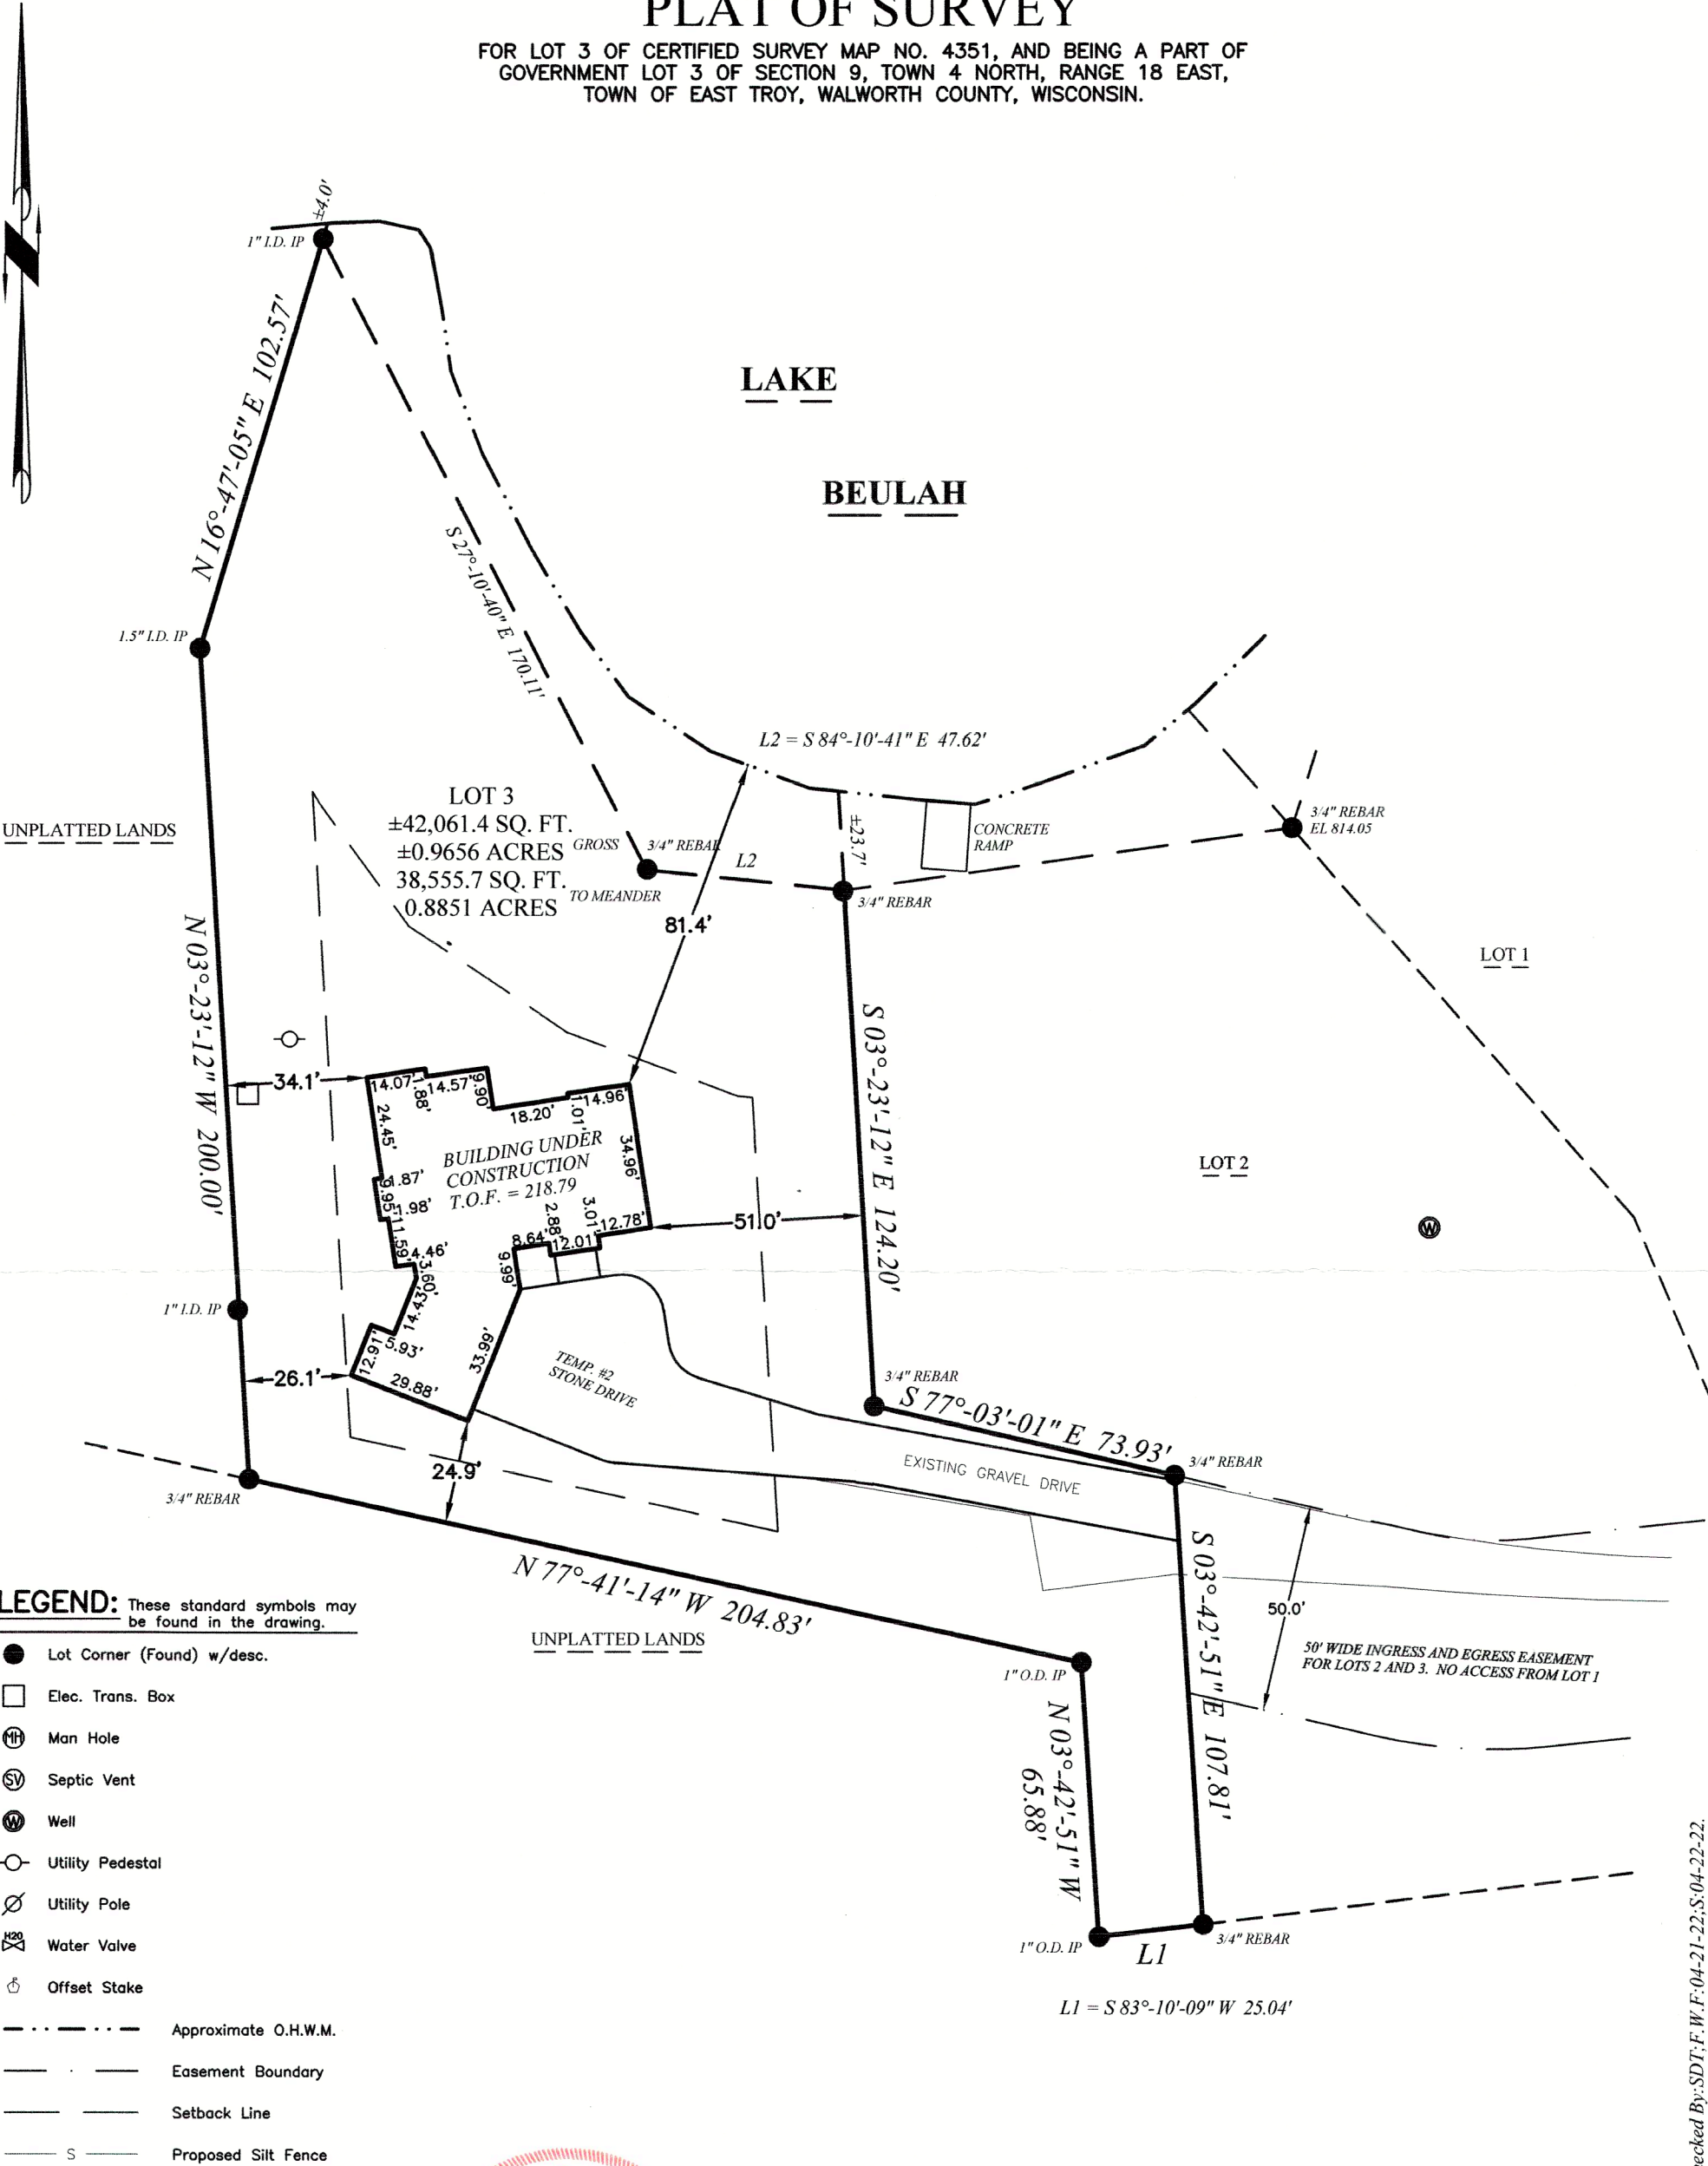

IF THE SURVEYOR'S SEAL IS NOT
WET STAMPED IN RED AND SIGNED
IN OPPOSABLE INK, THE PLAT IS
A COPY THAT SHOULD BE ASSUMED
TO CONTAIN UN-AUTHORIZED ALT-
ERATIONS. THE CERTIFICATION ON
ON THIS DOCUMENT DOES NOT APPLY
TO ANY COPIES NOR DIGITAL FORMATS
UNLESS VERIFIED DIGITAL CERTIFICATE
BY SAME EXISTS UN-ALTERED.

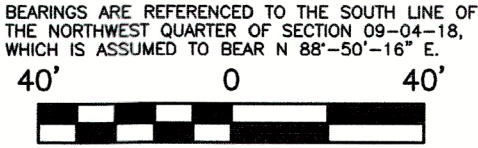

State of Wisconsin }
County of Jefferson } SS.

I, Scott D. Thomas, L.P.L.S., do hereby certify that I have made this survey and that the information as shown on the above Plat of Survey is a true and correct representation thereof and that this survey complies with Wisconsin Administrative Code A-E 7. Lots are drawn from subdivision plats/C.S.M.s; unplatted lands from recorded deeds/surveys. Boundary survey plats reflect field-located information; consult a title attorney to discover all the legal encumbrances attached to any property.

PROJECT: Rudolph
BUILDER: Aspen Homes, Inc.
325 Oakton Ave., Ste. 202
Pewaukee, WI 53072
Ph: (262) 695-4485

PA 4351-3

418-2975