



PLAT OF SURVEY

LOTS 15 AND THE NORTH 1/2 OF LOT 14, BLOCK 15, IN MIRAMAR SUBDIVISION, BEING A PART OF THE EAST 1/2 EAST 1/2 OF SECTION 10 AND THE WEST 1/2 OF SECTION 11, TOWN 4 NORTH, RANGE 18 EAST, TOWN OF EAST TROY, WALWORTH COUNTY, WISCONSIN.

SURVEYED FOR: DAVID PAUL
SURVEY ADDRESS: N9163 PINE STREET

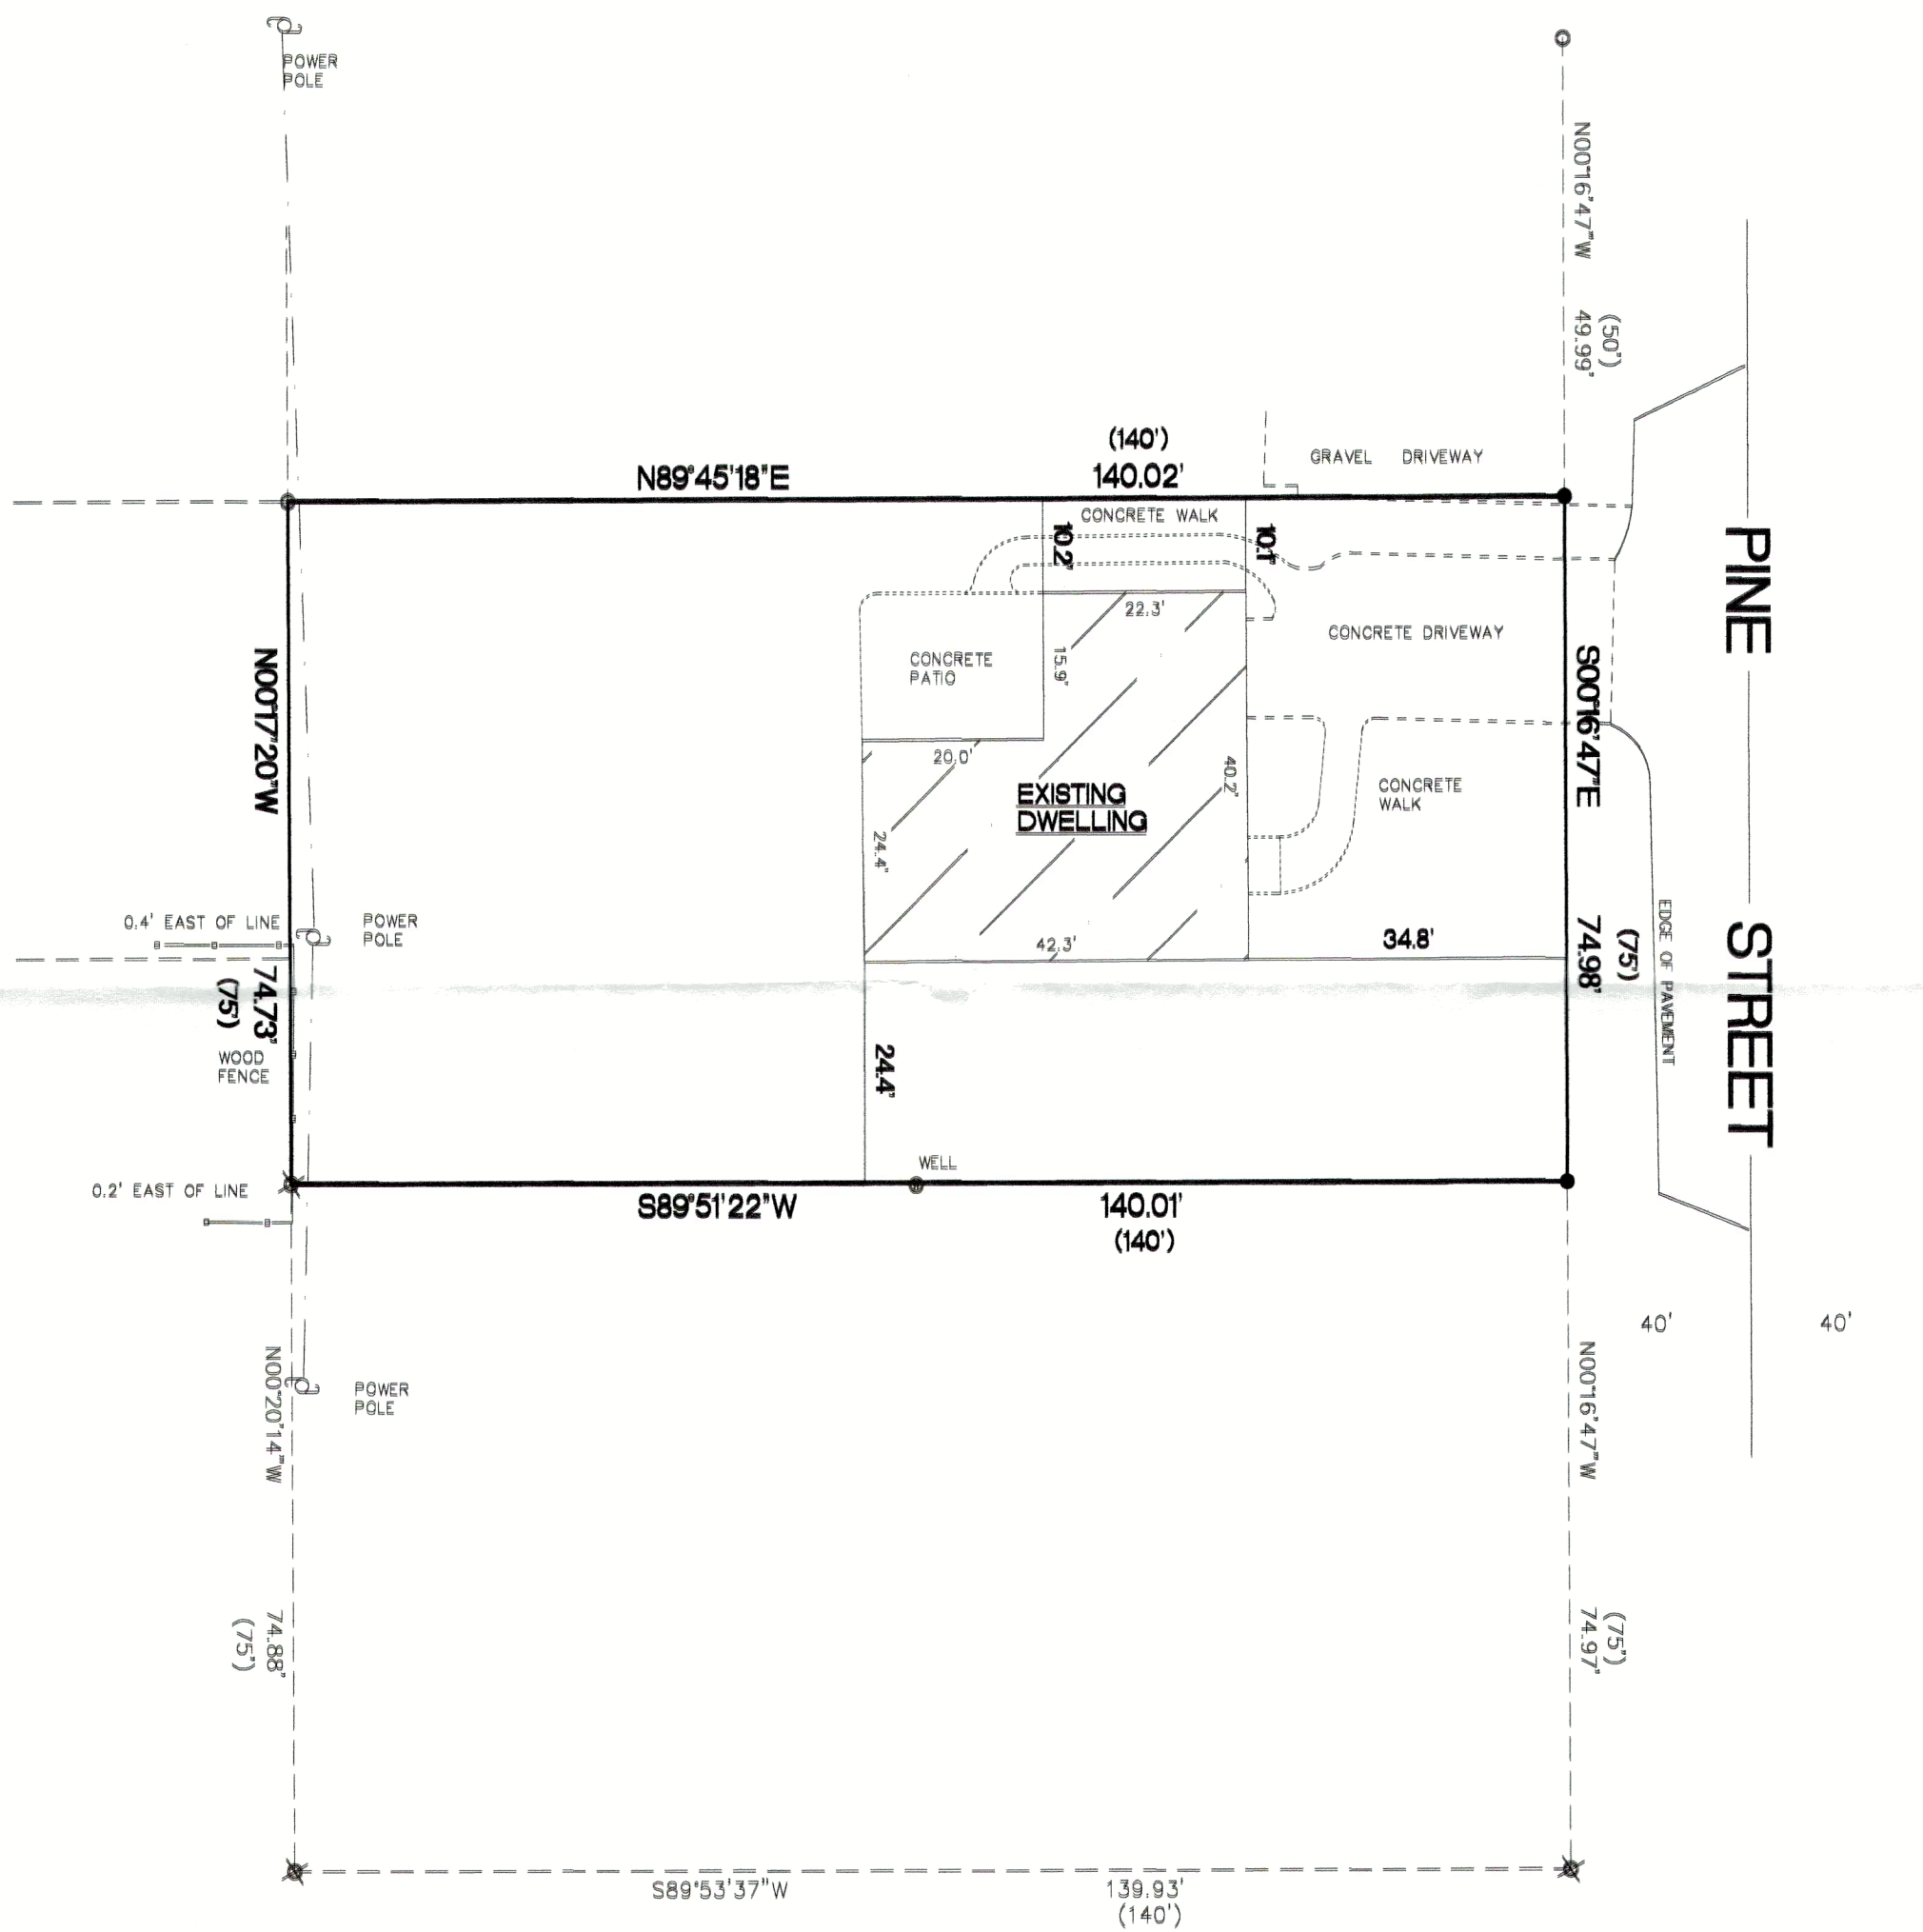

SCALE 1"=20'

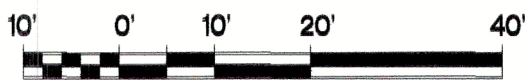

BEARINGS ARE REFERENCED TO THE EAST LINE OF THE NORTHEAST 1/4 OF SECTION 10-4-18 AND IS ASSUMED TO BEAR N00°15'42"W, (NAD83).

10481 SQ. FT.

- FOUND 1 1/4" O.D. IRON PIPE
- ✕ FOUND 1" O.D. IRON PIPE
- SET 1 1/4" O.D. IRON PIPE
- () RECORDED AS DIMENSIONS

"I hereby certify that I have surveyed the above property and that the above map is a true representation thereof and shows the size and location of the property, its exterior boundaries, the location of all visible structures and dimensions of all principal buildings thereon, boundary fence, apparent easements, roadways and encroachments if any."

"This survey is made for the use of the present owners of the property, and also those who purchase, mortgage or guarantee the title thereto within one year from date hereof."

Kettle Moraine Surveying Inc.
P.O. Box 357
Eagle WI 53119
(262)594-3484



THIS IS NOT AN ORIGINAL SURVEY UNLESS

REV. 10/22/2024
10/21/2024
DATE

TEP
FIELD WORK BY

TEP
DRAWN BY

24096
JOB NUMBER

PMR -180 418-2983