


PLAT OF SURVEY

LOT 12, BLOCK 2, OF SKONEY'S SUBDIVISION, A SUBDIVISION OF PART OF THE SE 1/4 OF THE SW 1/4, AND THE SW 1/4 OF THE SE 1/4 OF FRACTIONAL SECTION 10, T.4N., R.18E., TOWN OF EAST TROY, COUNTY OF WALNORTH AND THE STATE OF WISCONSIN.

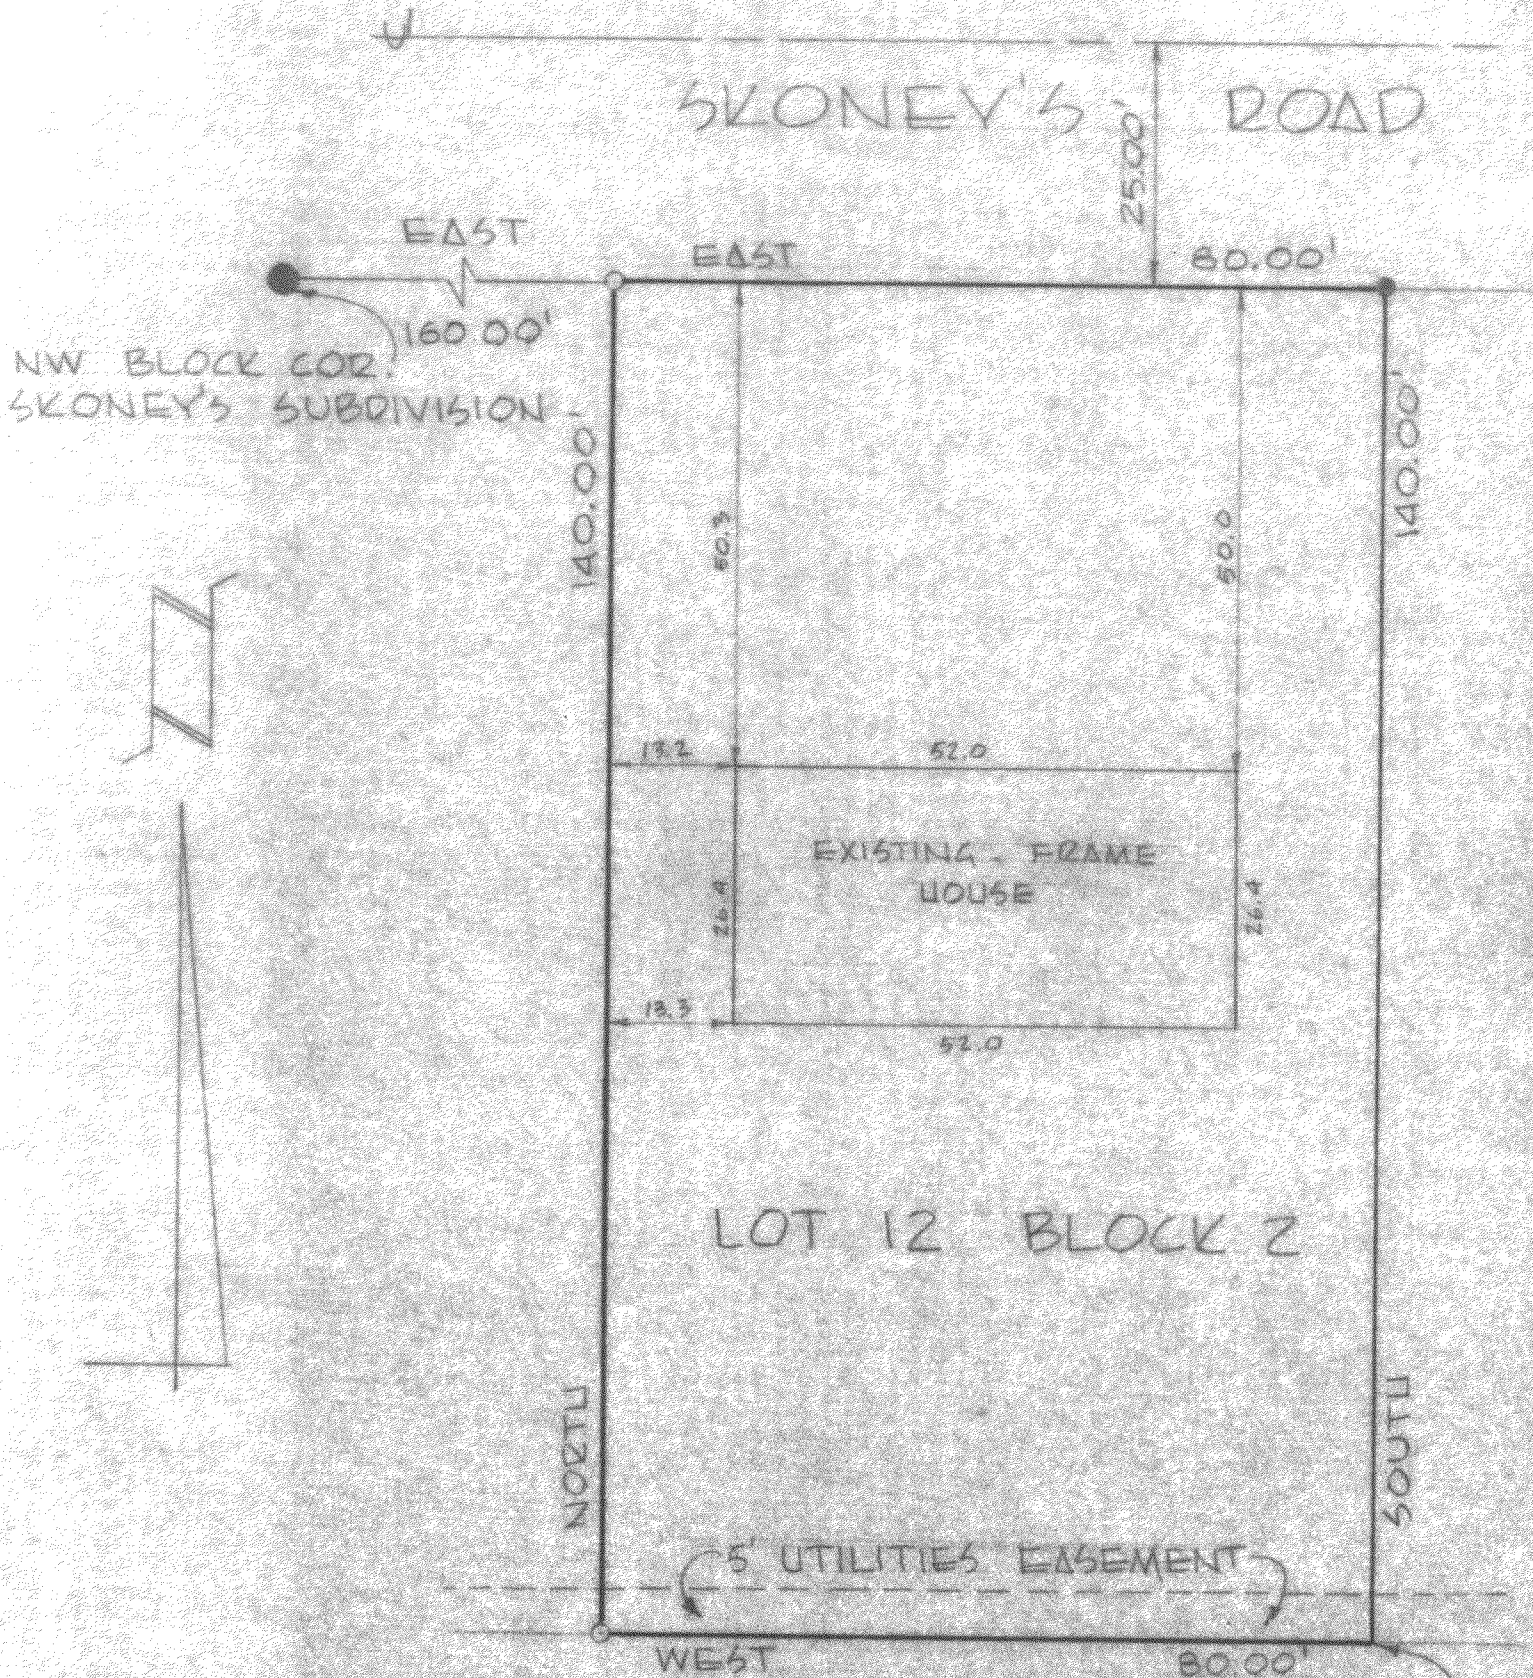


— LEGEND —

- FOUND CONCRETE MONUMENT
- FOUND 1" DIA. IRON PIPE
- SET 1" DIA. IRON PIPE

SCALE: 1" = 20'

JOB NO. 77002

DATE: JAN. 10, 1977

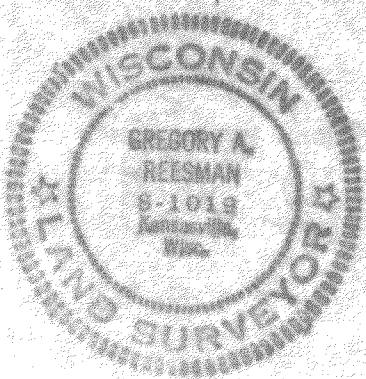

SURVEYOR'S CERTIFICATE

I HEREBY CERTIFY THAT THE LANDS DEPICTED HEREON HAVE BEEN SURVEYED UNDER MY DIRECTION AND THAT THE PLAT HEREON DRAWN IS A CORRECT REPRESENTATION OF SAID SURVEY.

Gregory A. Reesman

GREGORY A. REESMAN
LAND SURVEYOR S-1019
KANSASVILLE, WIS.

418-817