

PLAT OF SURVEY
OF


LOT 9, DUTCHLAND ACRES, A SUBDIVISION LOCATED IN THE NORTHEAST 1/4 OF SECTION 21, T. 4 N.,
R. 18 E. OF THE 4TH P.M., TOWNSHIP OF EAST TROY, COUNTY OF WALWORTH, STATE OF WISCONSIN.

FOR: PETER D. CHRISTIANSON

SCALE 1" = 40'

o = IRON PIPE STAKE

BEARINGS ARE THOSE OF RECORDED PLAT.

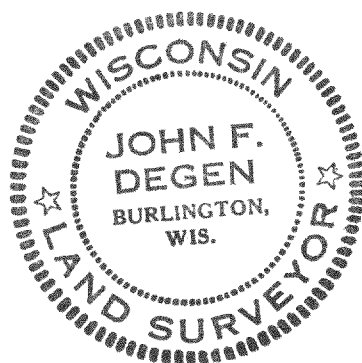


I have surveyed the above-described property, and the map hereon is a true representation thereof and shows the size and location of the property, its exterior boundaries, the location and dimensions of all visible structures thereon, fences, apparent easements and roadways and visible encroachments, if any.

This survey is made for the exclusive use of the present owners of the property, and also those who purchase, mortgage, or guarantee the title thereto, within one year from date hereof.

Dated at Burlington, this 24th day
of MARCH, 19 78.

John F. Degen
John F. Degen, Land Surveyor S 242

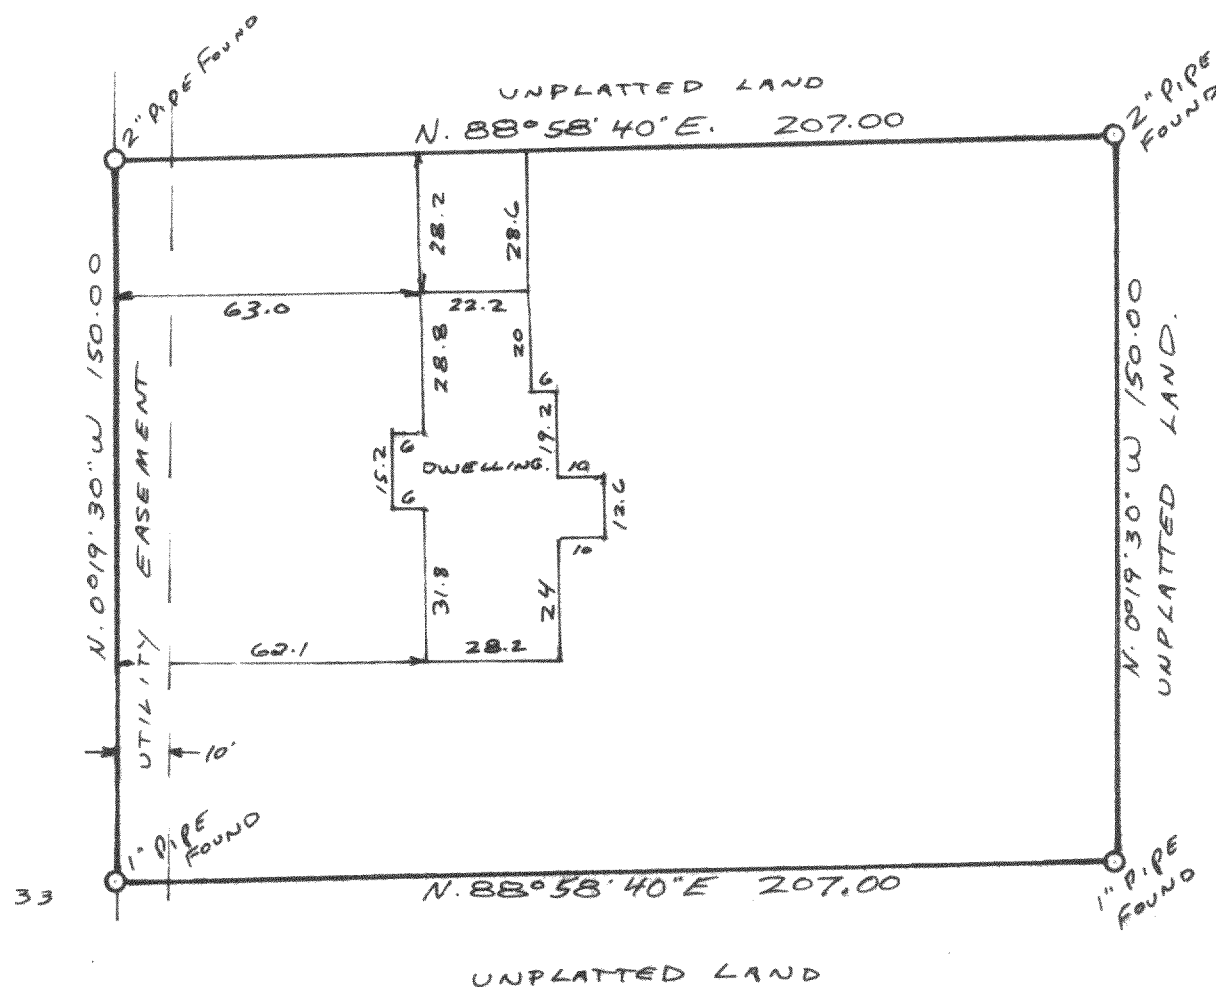

418-315
DRAWER 6-E-4