


PLAT OF SURVEY

OF LOT 30 OF SHOREWOOD, A SUBDIVISION LOCATED
IN SECTIONS 10, 11, 14, & 15, T4N, R18E, WALWORTH
COUNTY, WISCONSIN

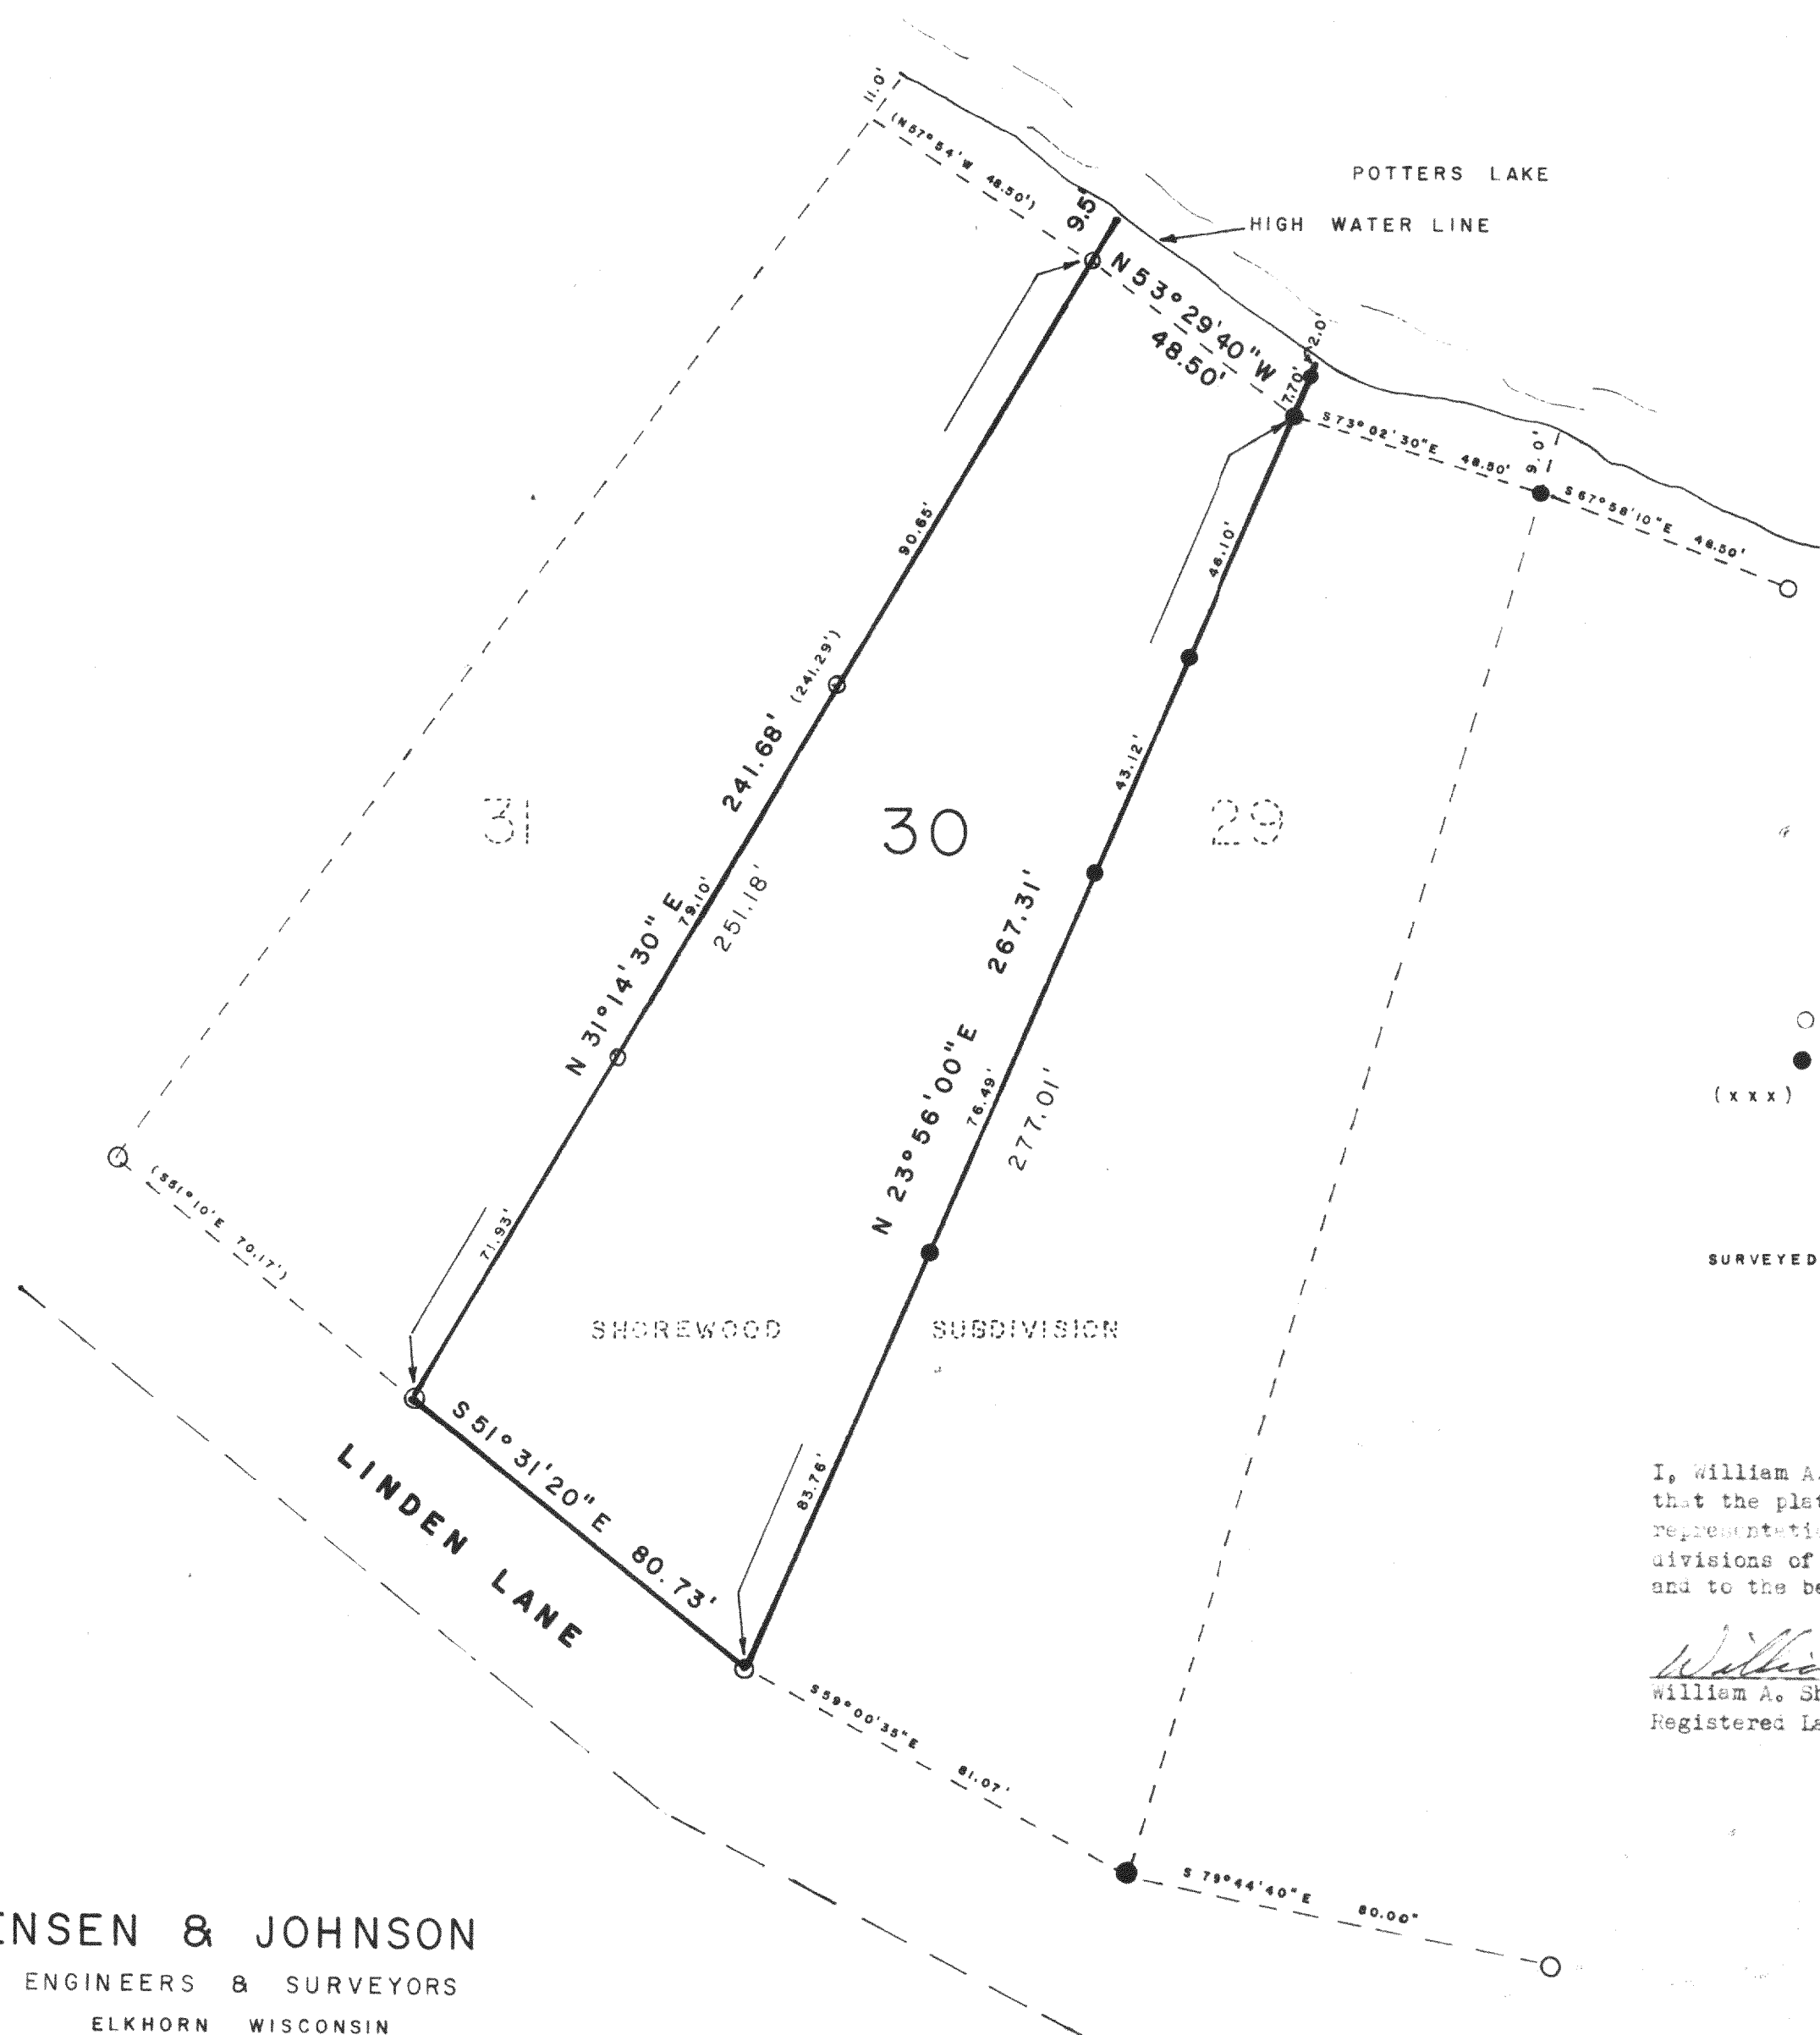

THE NORTHWESTERLY LINE OF SAID LOT
30 WAS ASSUMED TO BEAR N 31° 14' 30\"/>


SCALE: 1\"/>

○ found iron pipe 1\"/>

SURVEYED FOR: RICHARD BRAULT

I, William A. Shearman, Registered Land Surveyor, do hereby certify
that the plat shown hereon is a true and accurate survey and a true
representation thereof and the exterior boundary lines and all
divisions of said property have been surveyed under my direction
and to the best of my knowledge and belief.

William A. Shearman
William A. Shearman S-1378 Dated this 1st day of Sept
Registered Land Surveyor 1977.

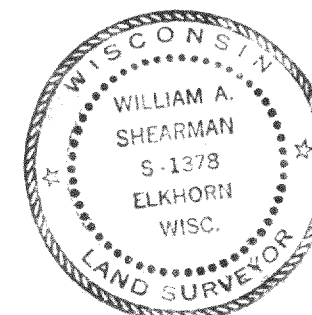

JENSEN & JOHNSON
ENGINEERS & SURVEYORS
ELKHORN WISCONSIN