

Plat of Survey

Known as 1007 Hickory Lane, in the Town of East Troy, Wisconsin
The North 20.00 ft of Lot 25 and all of Lots 26 and 27 in Block 7 in MIRAMAR
SUBDIVISION, being a Subdivision in Sections 10 and 11, T 4 N, R 19 E, in
the Town of East Troy, Walworth County, Wisconsin.


AUGUST 17, 1977

JOHN C AND MARAINE ERNST-OWNERS

SURVEY NO. 141372-M

WHITE OAK

DR. 40'

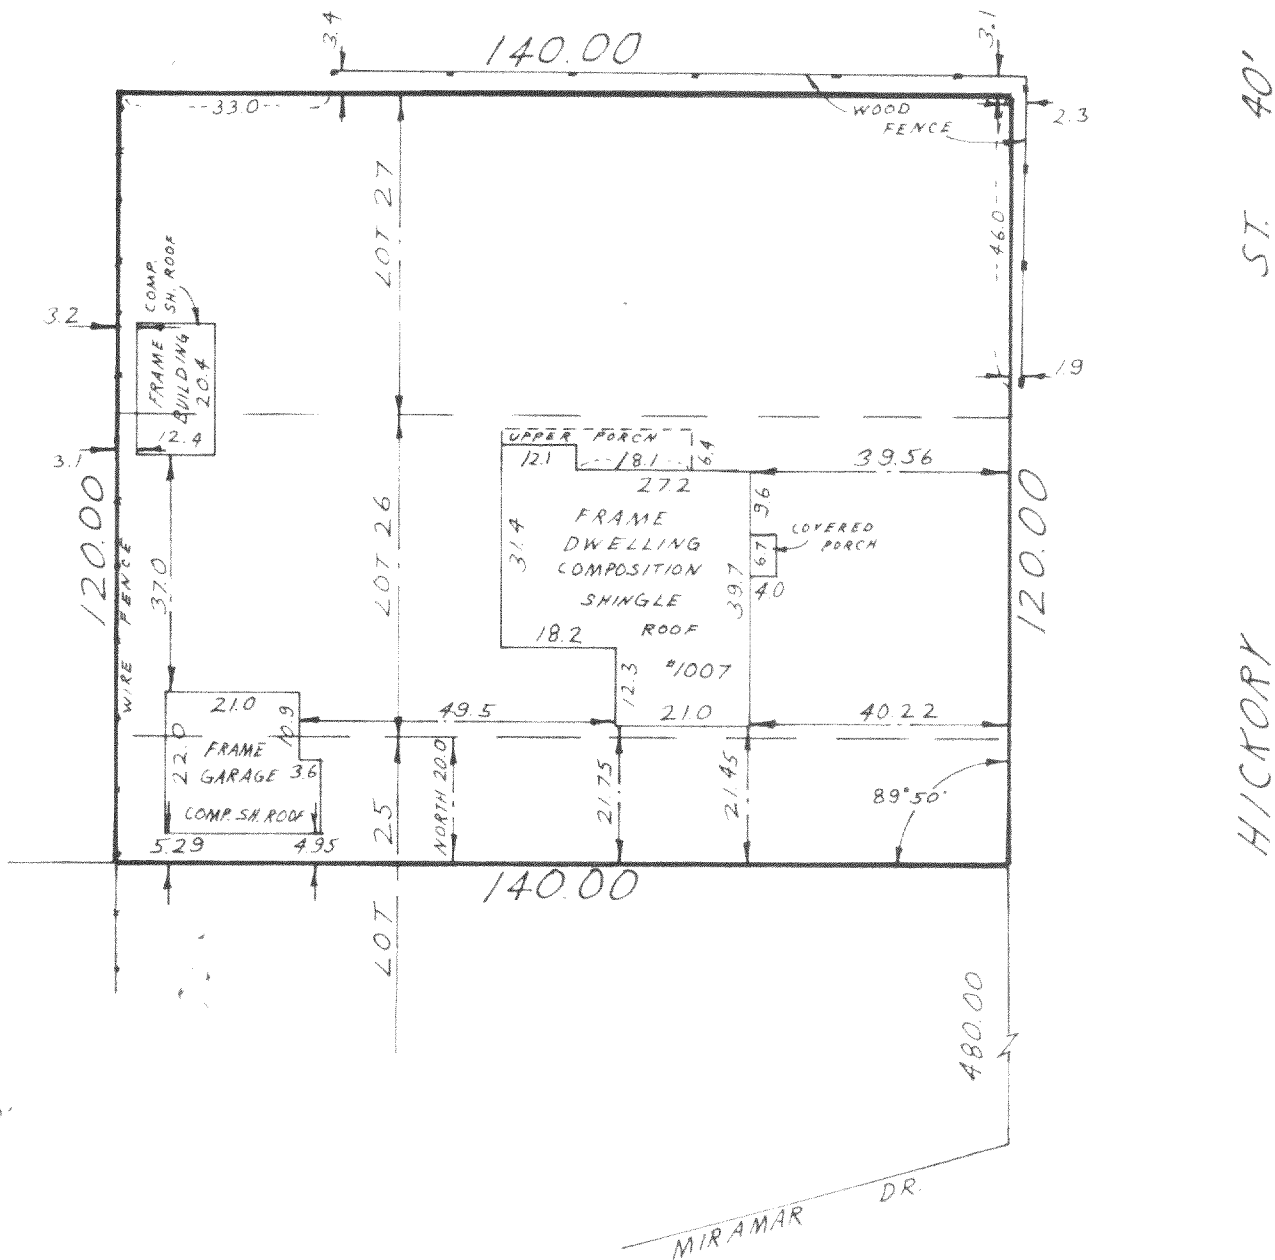


SCALE: 1"=30'

I Certify that I have surveyed the above described property (Property), and the above map is a true representation thereof and shows the size and location of the Property, its exterior boundaries, the location and dimensions of all visible structures thereon, boundary fences, apparent easements and roadways and visible encroachments, if any.

This survey is made for the exclusive use of the present owners of the Property, and also those who purchase, mortgage, or guarantee the title thereto, within one (1) year from date hereof.

Kenneth E. Berke
SURVEYOR

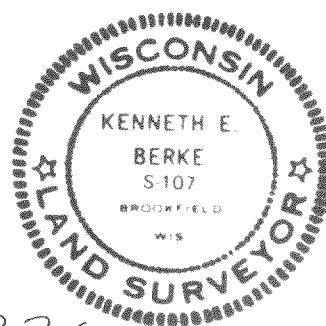

national survey & engineering

3470 north 127th street • p.o. box 444 • brookfield, wisconsin, 53005 • phone 414 / 781-1000

PMR-100ct+PMR-101

418-336