



BRANCH OFFICE
809 - 43RD STREET
KENOSHA, WISCONSIN 53140
PHONE: 414-658-4488

Lot 24, and the Easterly 1/3 of Lot 25, Block 1, Wilmars Grove Sub-division, Town of East Troy, County of Walworth, State of Wisconsin.

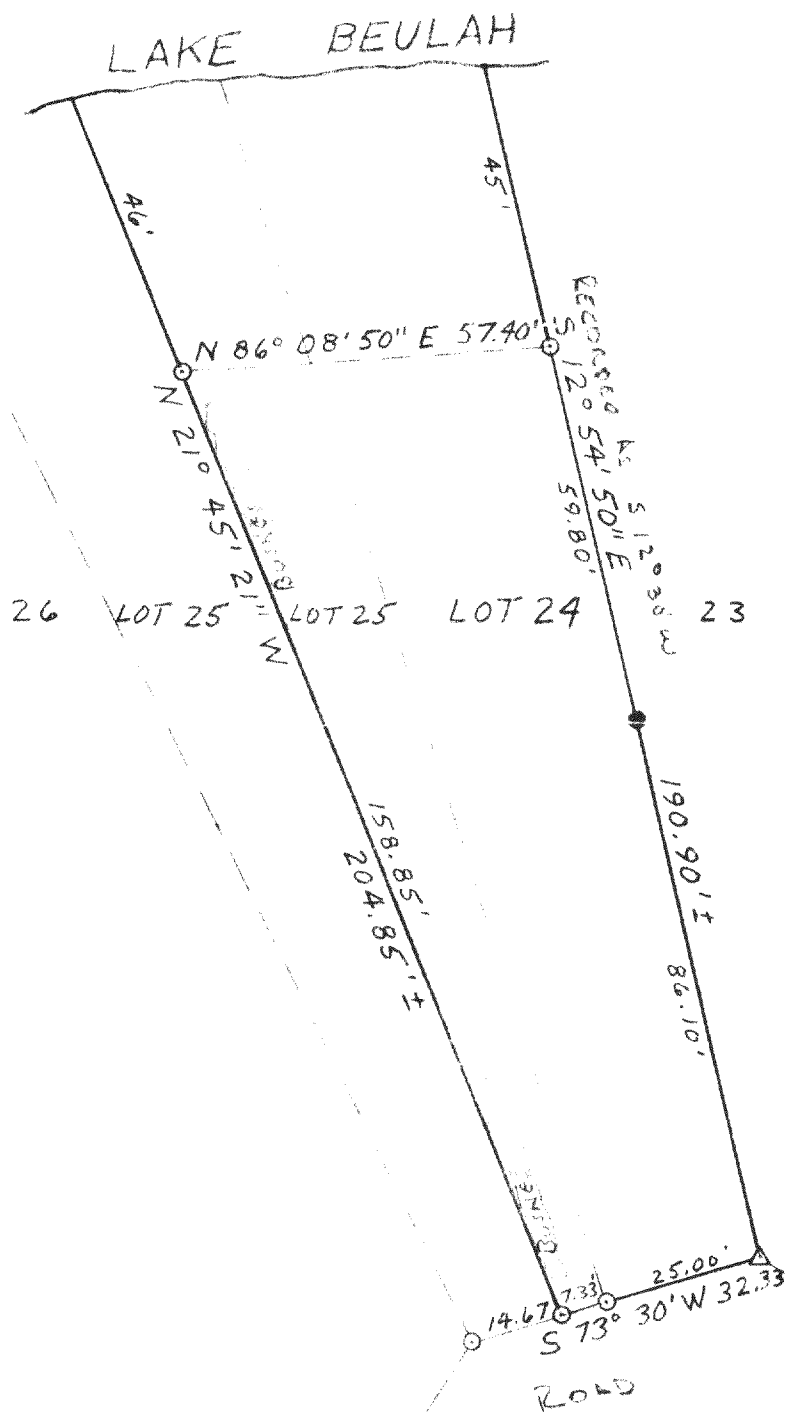

- FOUND 5/8" O.D. IRON BAR
- SET 1 1/2" x 24" IRON PIPE
- △ SET RAILROAD SPIKE

SGALE 11/17/30'

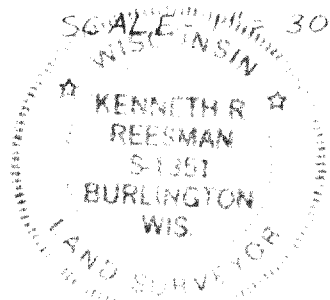

"I CERTIFY THAT I HAVE SURVEYED THE ABOVE DESCRIBED PROPERTY AND THAT THE ABOVE PLAT IS AN ACCURATE SURVEY AND A TRUE REPRESENTATION THEREOF AND CORRECTLY SHOWS THE EXTERIOR BOUNDARY LINES _____ ON SAID PROPERTY AND THE CORRECT MEASUREMENTS THEREOF."

12-28-77

77274
JOB NUMBER