




I, Joseph M. Biagi, do hereby certify that I have on this twenty second day of April, 1939 surveyed Lot 9 Block 12, Miramar Subdivision, in Section 11, T. 4. N., R. 13. E., Walworth County, Wisconsin, at 3.00 P.M., and state that the plat here shown is a true and correct representation of the measurements as found at the site.

*Joseph M. Biagi.*

MAPLE ST.

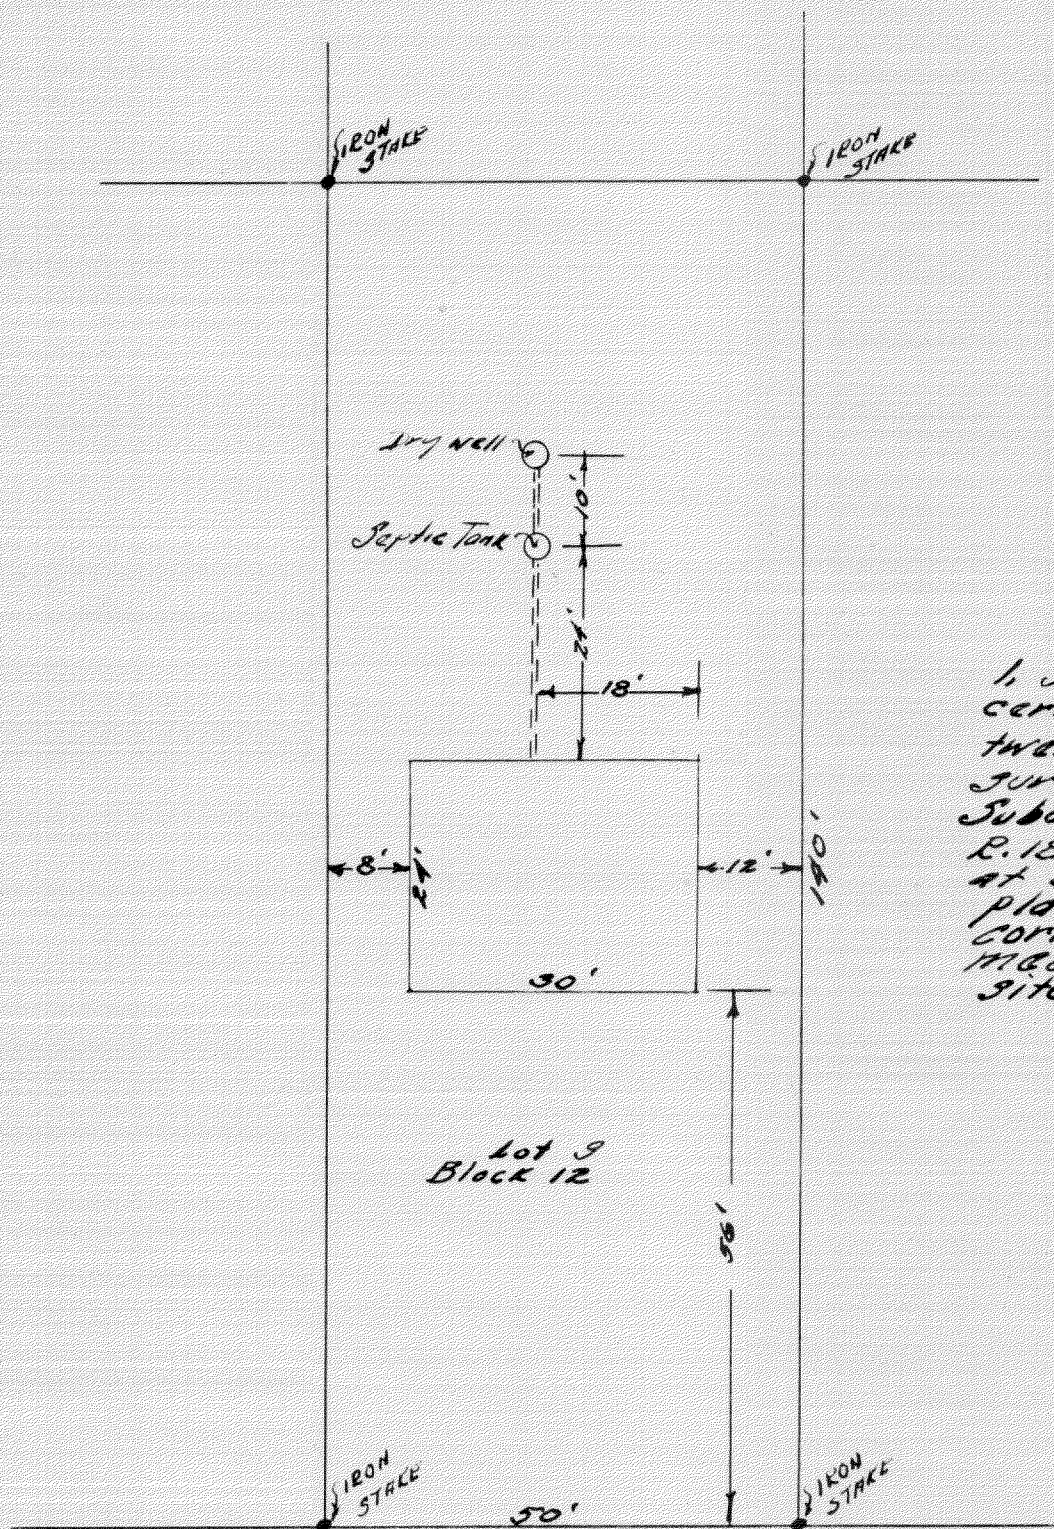