

WAUKESHA LAND SURVEYS INC.



S. 20 W. 23156 ELLIS ST.

WAUKESHA, WISCONSIN 53186

Plat of Survey

For Mr. James Keyes

Location Lot 38, 40, 42, 44, and 46 of O-Ton-Kah subdivision in the NW $\frac{1}{4}$ of Section 10, Town 4 North, Range 18 East, Town of East Troy, Walworth County, Wisconsin.

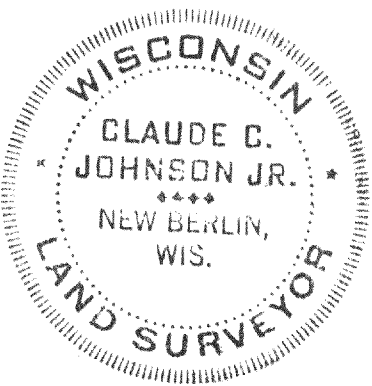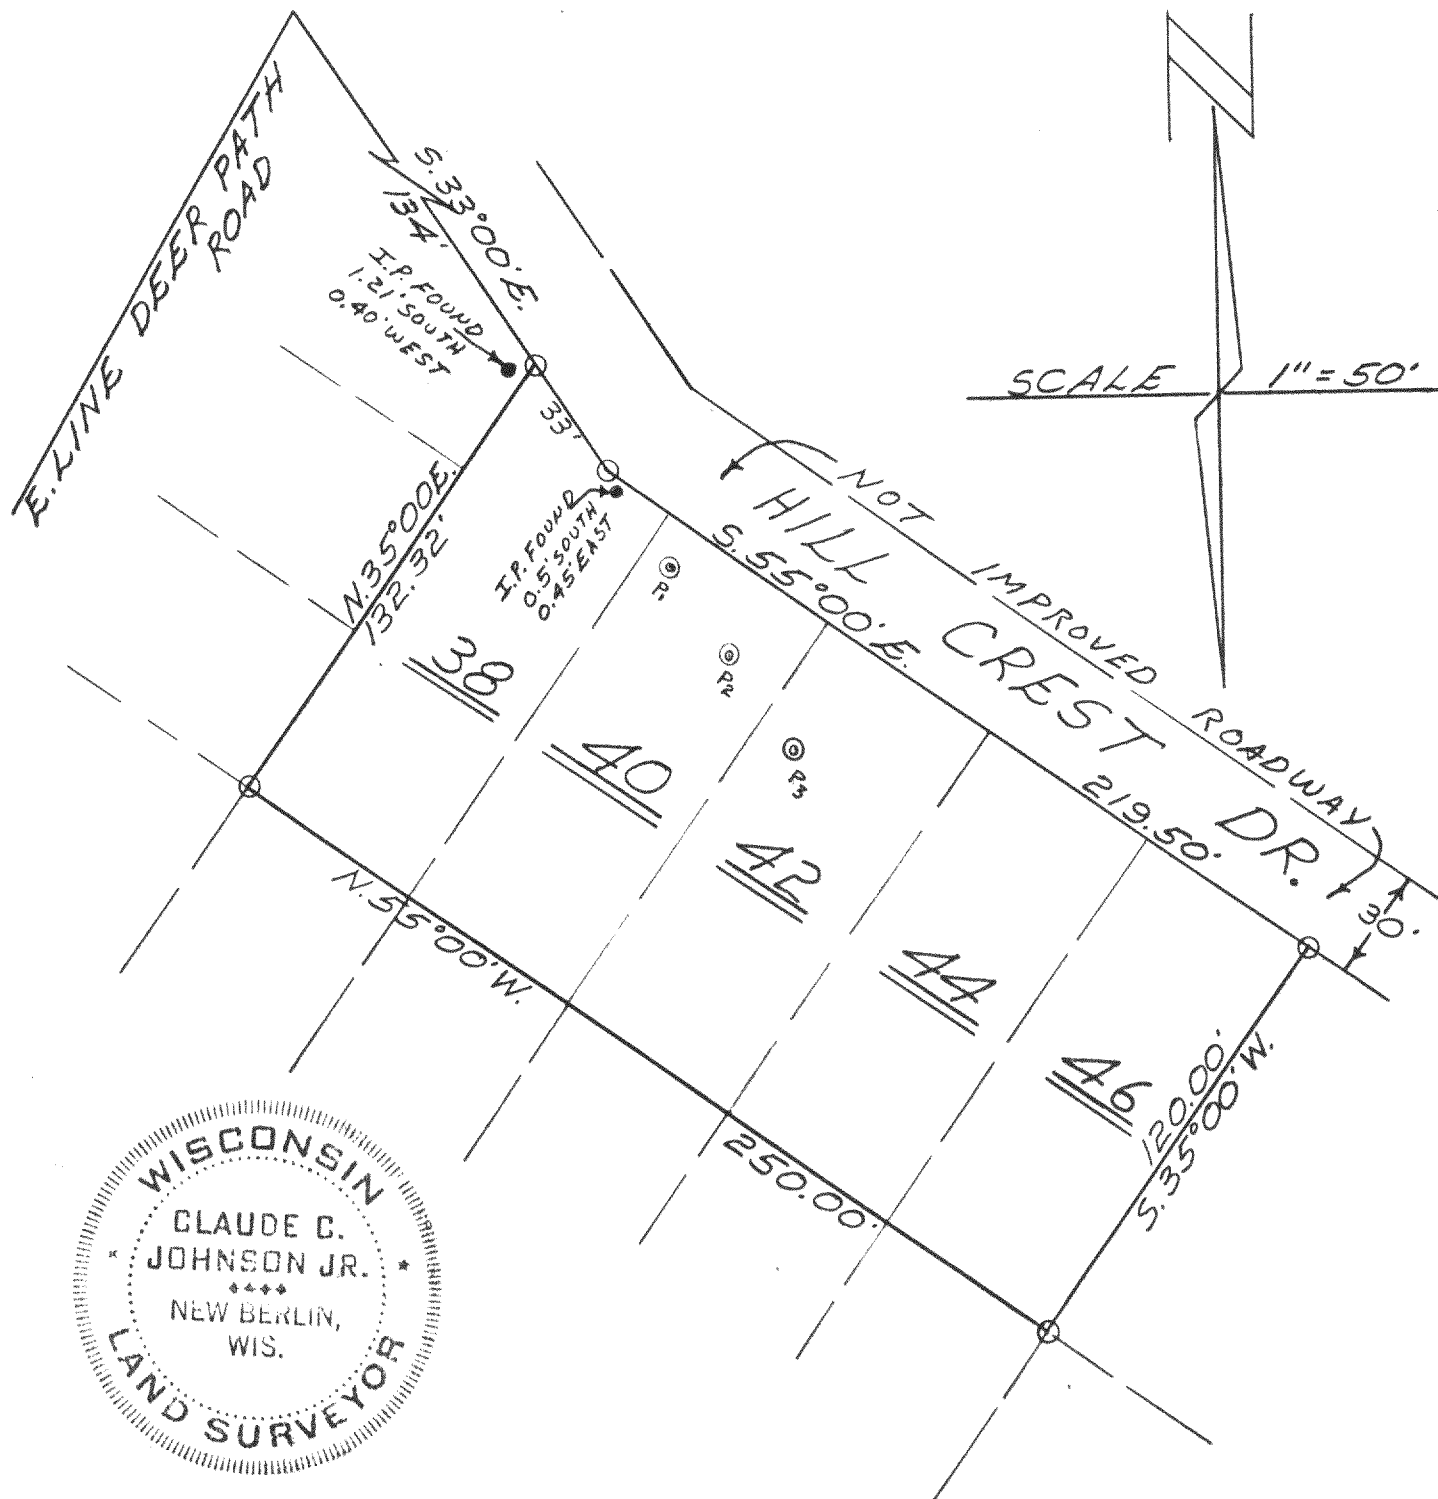

State of Wisconsin } ss.
County of Waukesha

Certificate

We, WAUKESHA LAND SURVEYS, INC., certify that we have surveyed the above-described property and that the above plat is true representation thereof and correctly shows the exterior boundary lines and location of vacant buildings and other improvements and roads, and other apparent easements.

Dated this 21st day of January 1972

Claude C. Johnson Jr.
Claude C. Johnson, Jr.
Land Surveyor No. S-765