


Plat of Surney

Known as 1002 Miramar Drive, in the ~~Village of East Troy~~ ^{TOWN OF EAST TROY}, Wisconsin
Lot 10 and the South 10.00 ft of Lot 11 in Block 4 in MIRAMAR, being a Subdivision in
Sections 10 and 11 in T 4 N, R 18 E, in the ~~Village of East Troy~~ ^{TOWN OF EAST TROY}, Walworth County,
Wisconsin.

JUNE 29, 1978

WM P MORAN


SURVEY NO. 143075-M

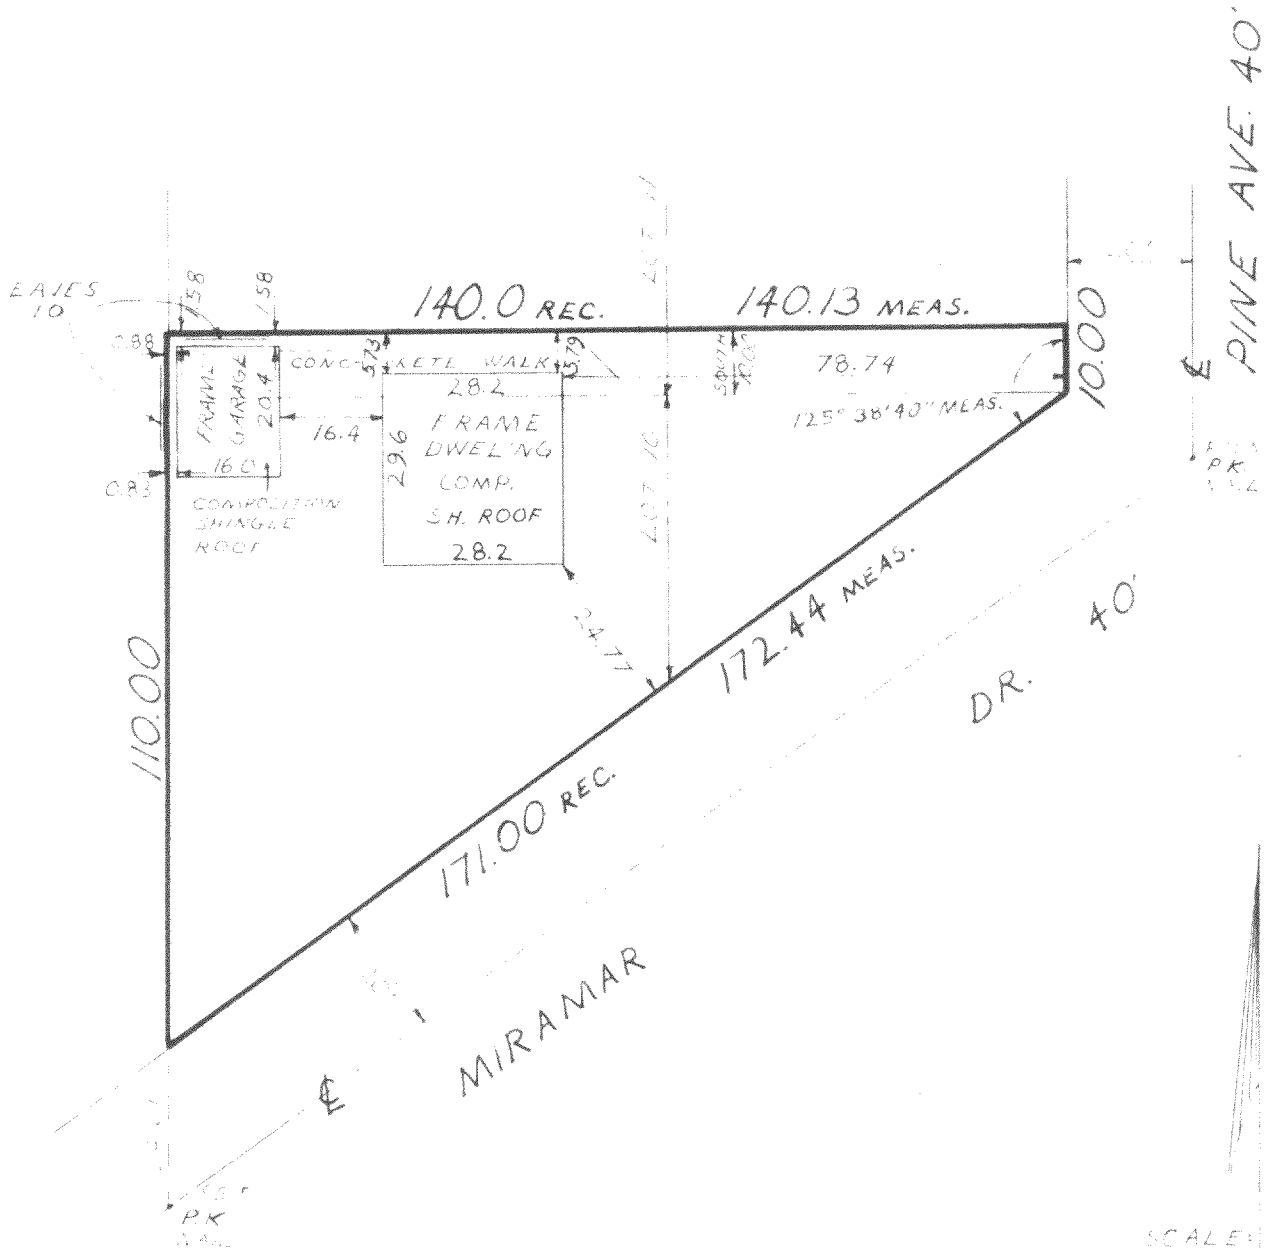

I Certify that I have surveyed the above described property (Property), and the above map is a true representation thereof and shows the size and location of the Property, its exterior boundaries, the location and dimensions of all visible structures thereon, boundary fences, apparent easements and roadways and visible encroachments, if any.

This survey is made for the exclusive use of the present owners of the Property, and also those who purchase, mortgage, or guarantee the title thereto, within one (1) year from date hereof.

Kenneth E Burke
SURVEYOR

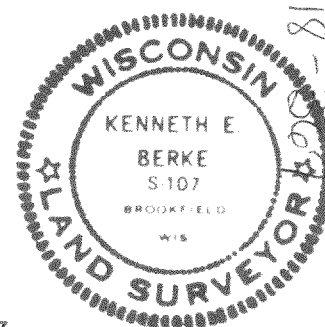

 national survey of engineering

3470 north 127th street • p. o. box 444 • brookfield, wisconsin, 53005 • phone 414 / 781-1000

PMR-53

418-367